


BENNINGTON (51)
#2

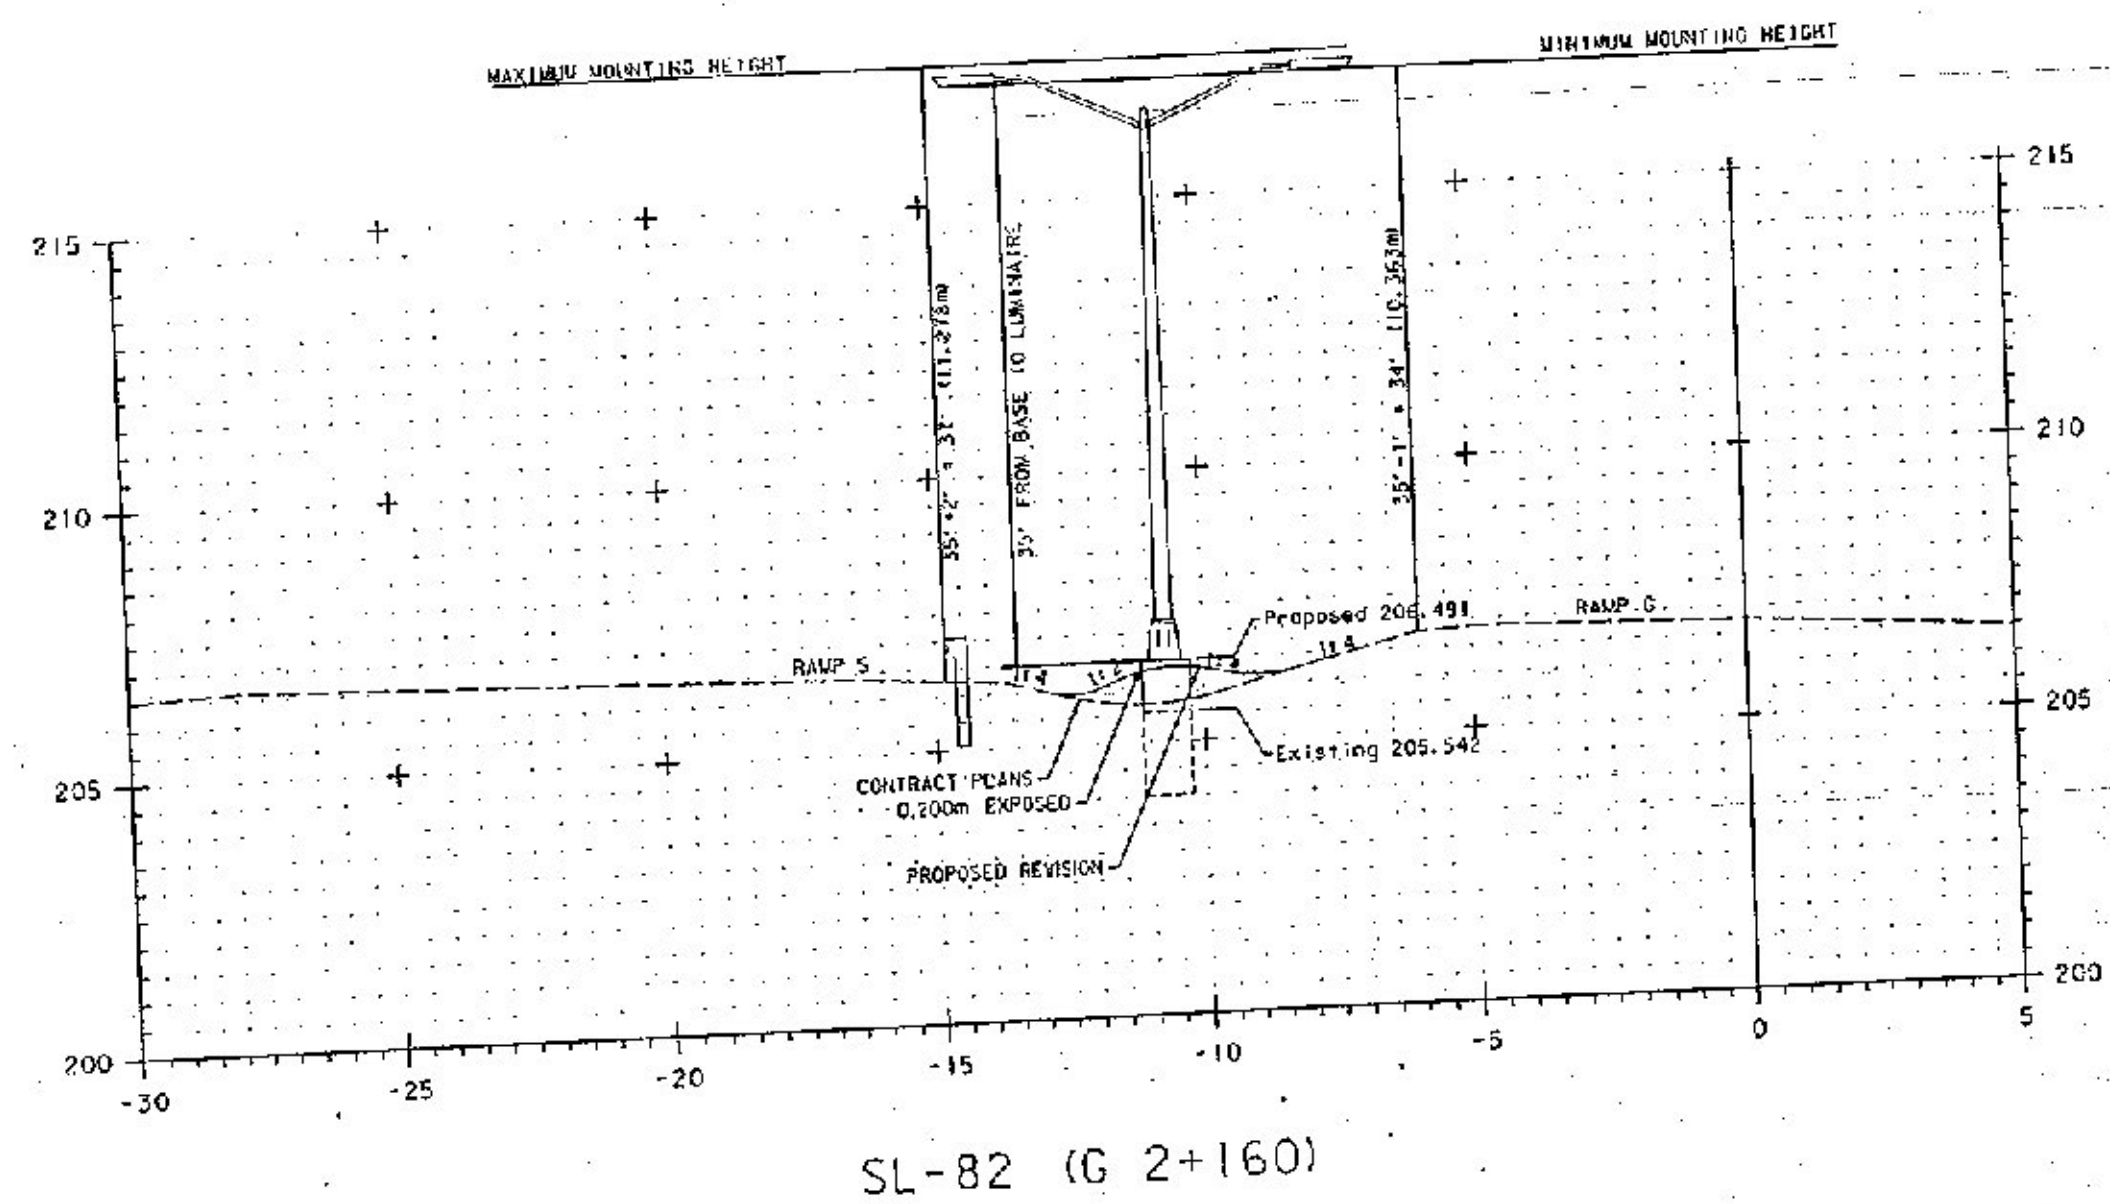

See Note on
Sheet 370

RECORD PLANS - LIGHT POLE
SL-82 CROSS SECTION
6/17/11