




G 2+280

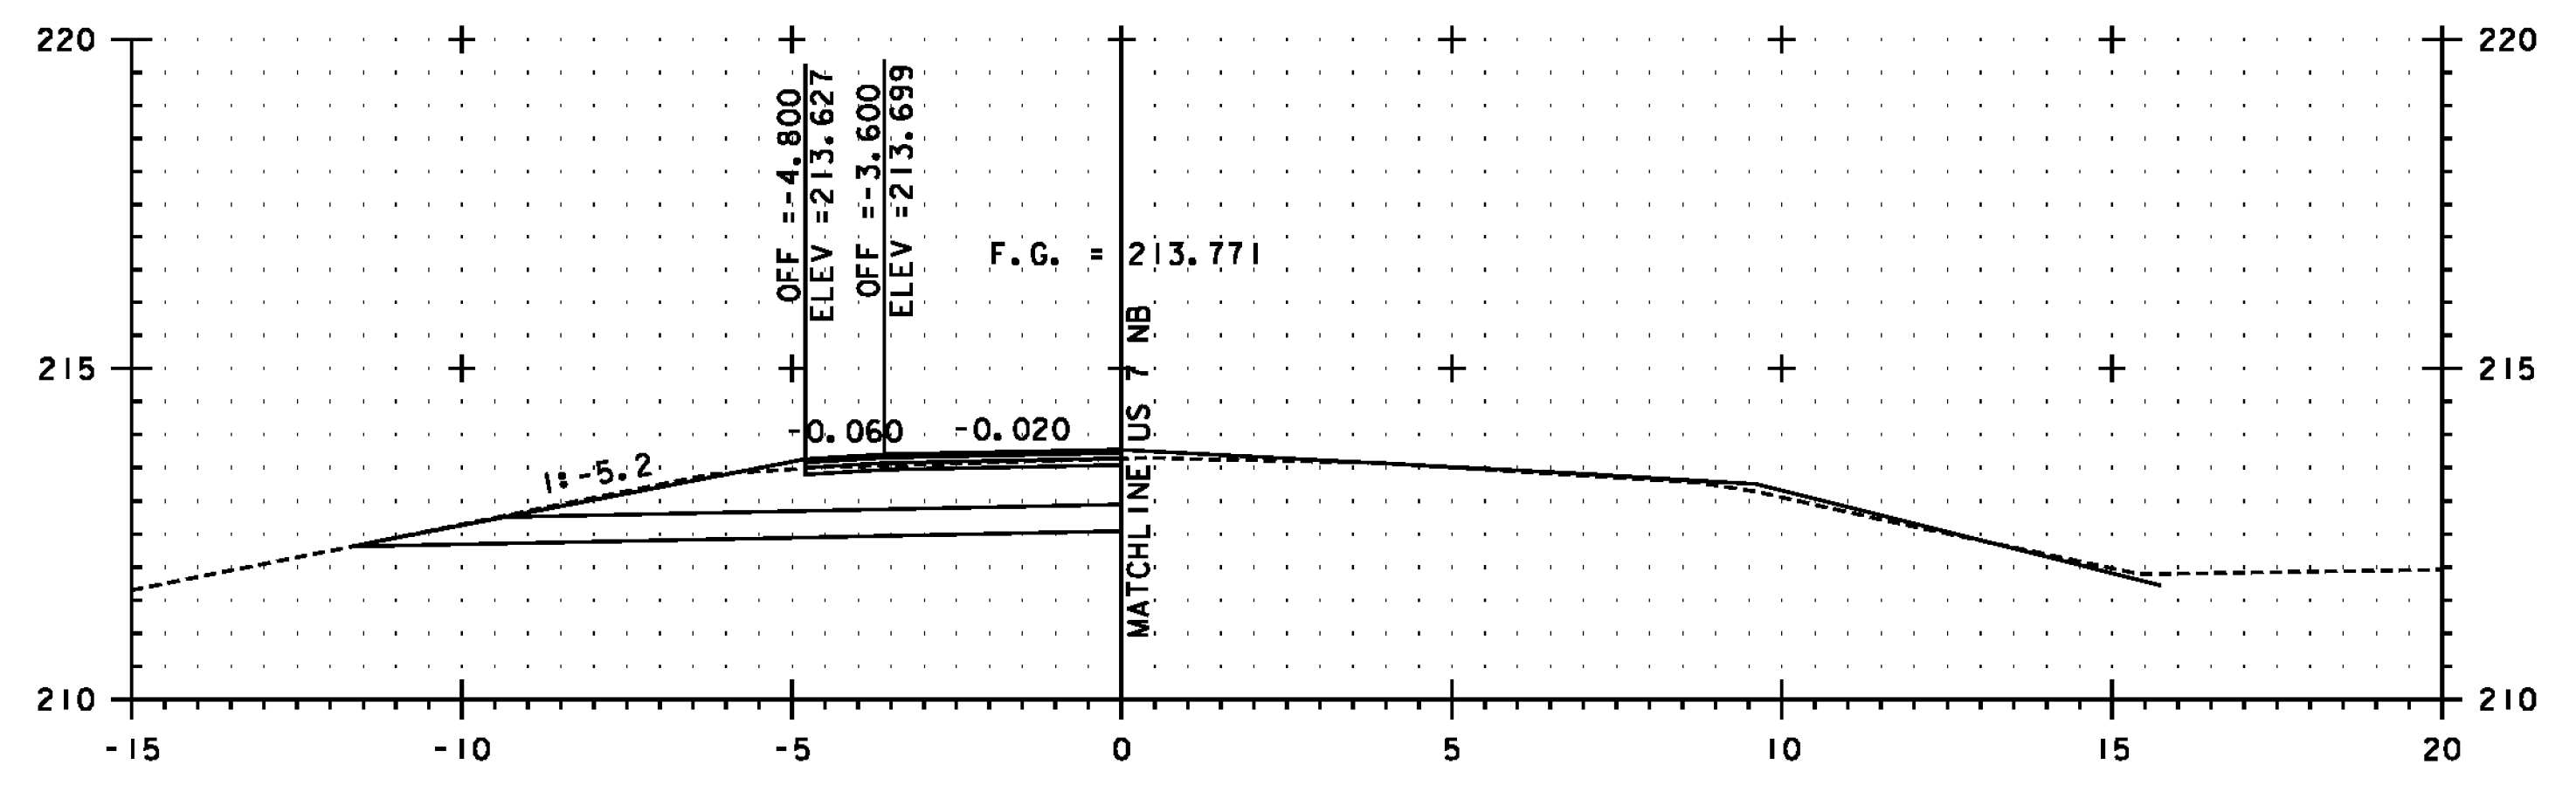

G 2+306.468 = NB 11+025.260, 3.6m LT.

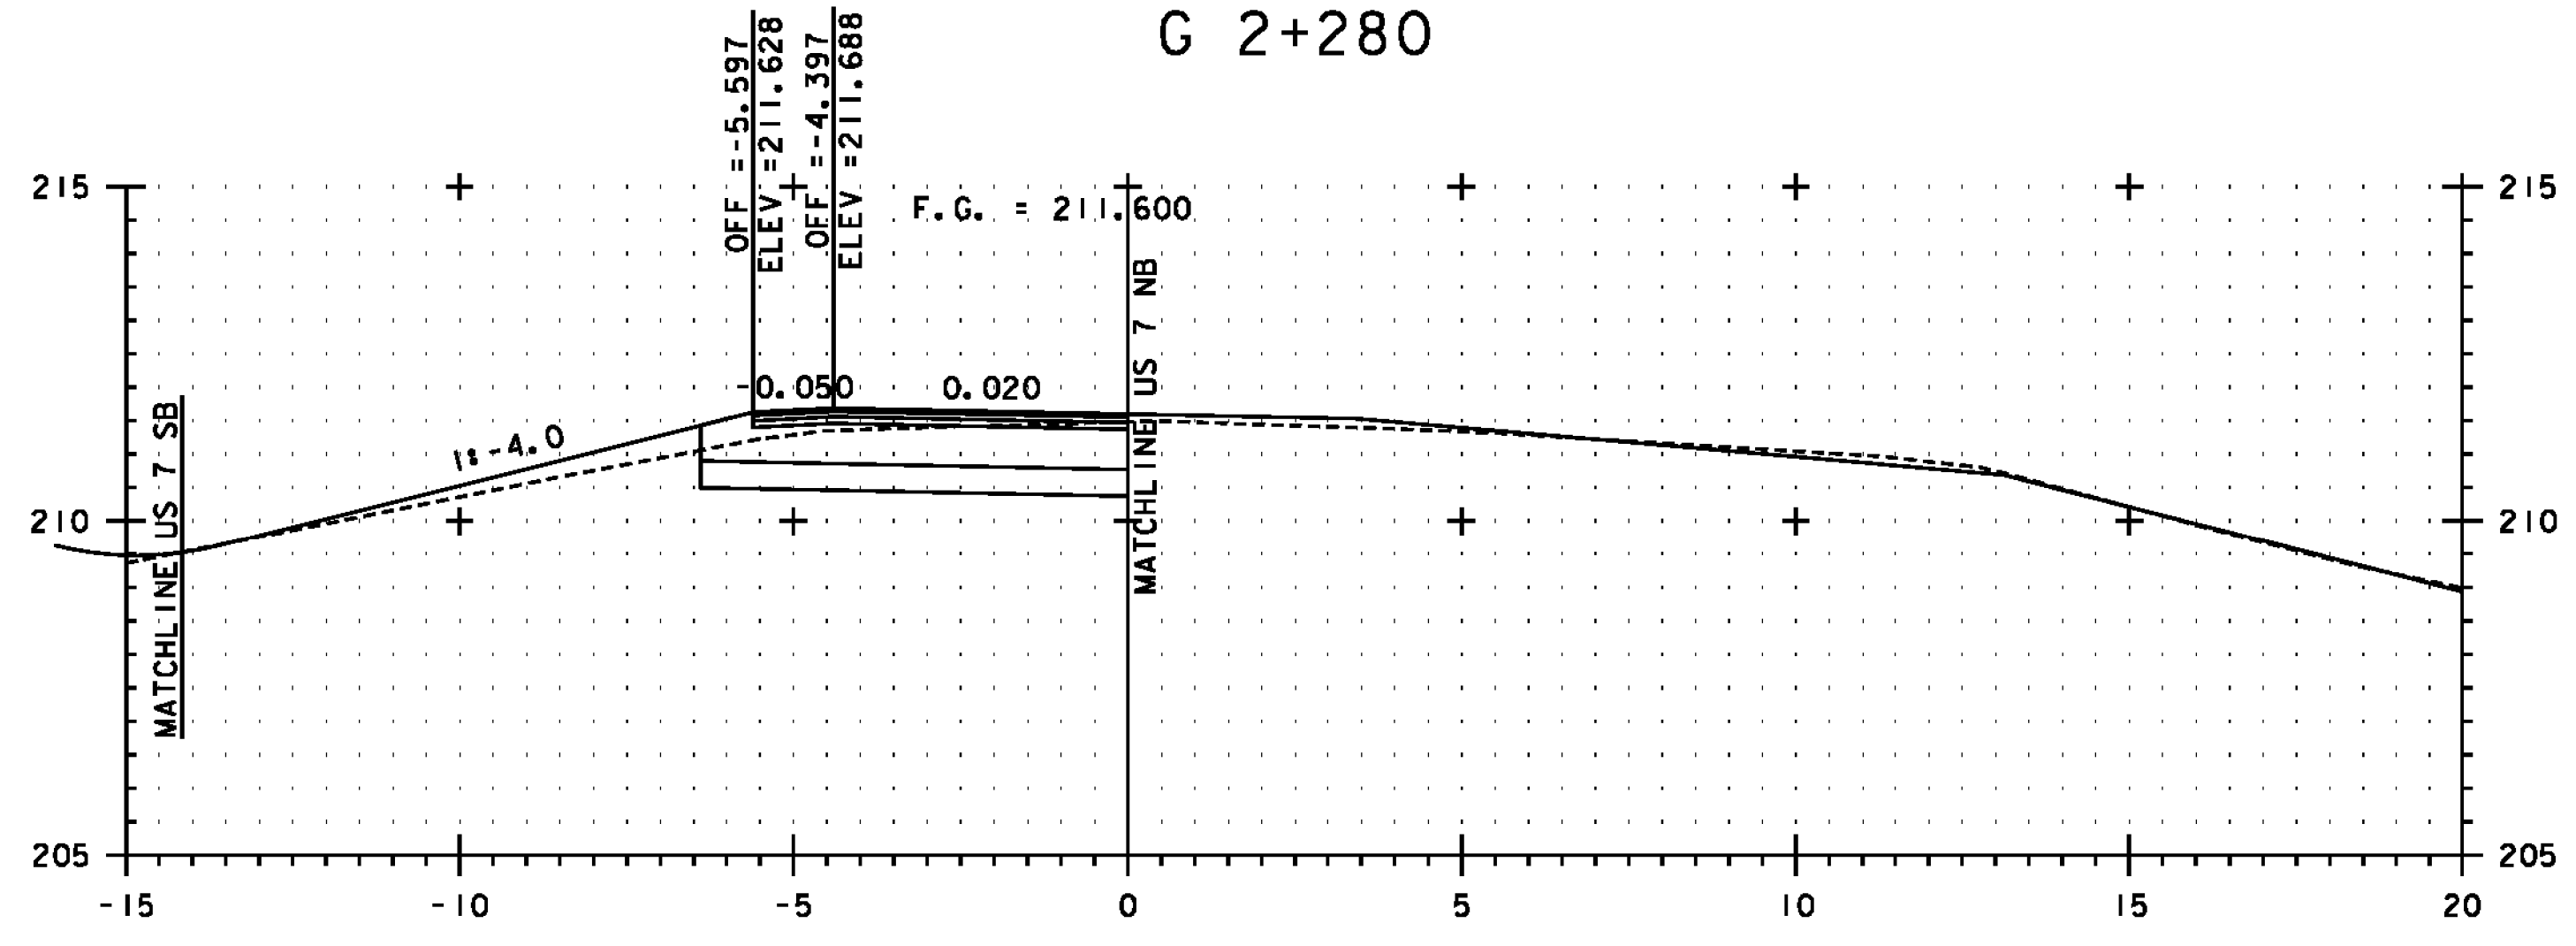


G 2+260

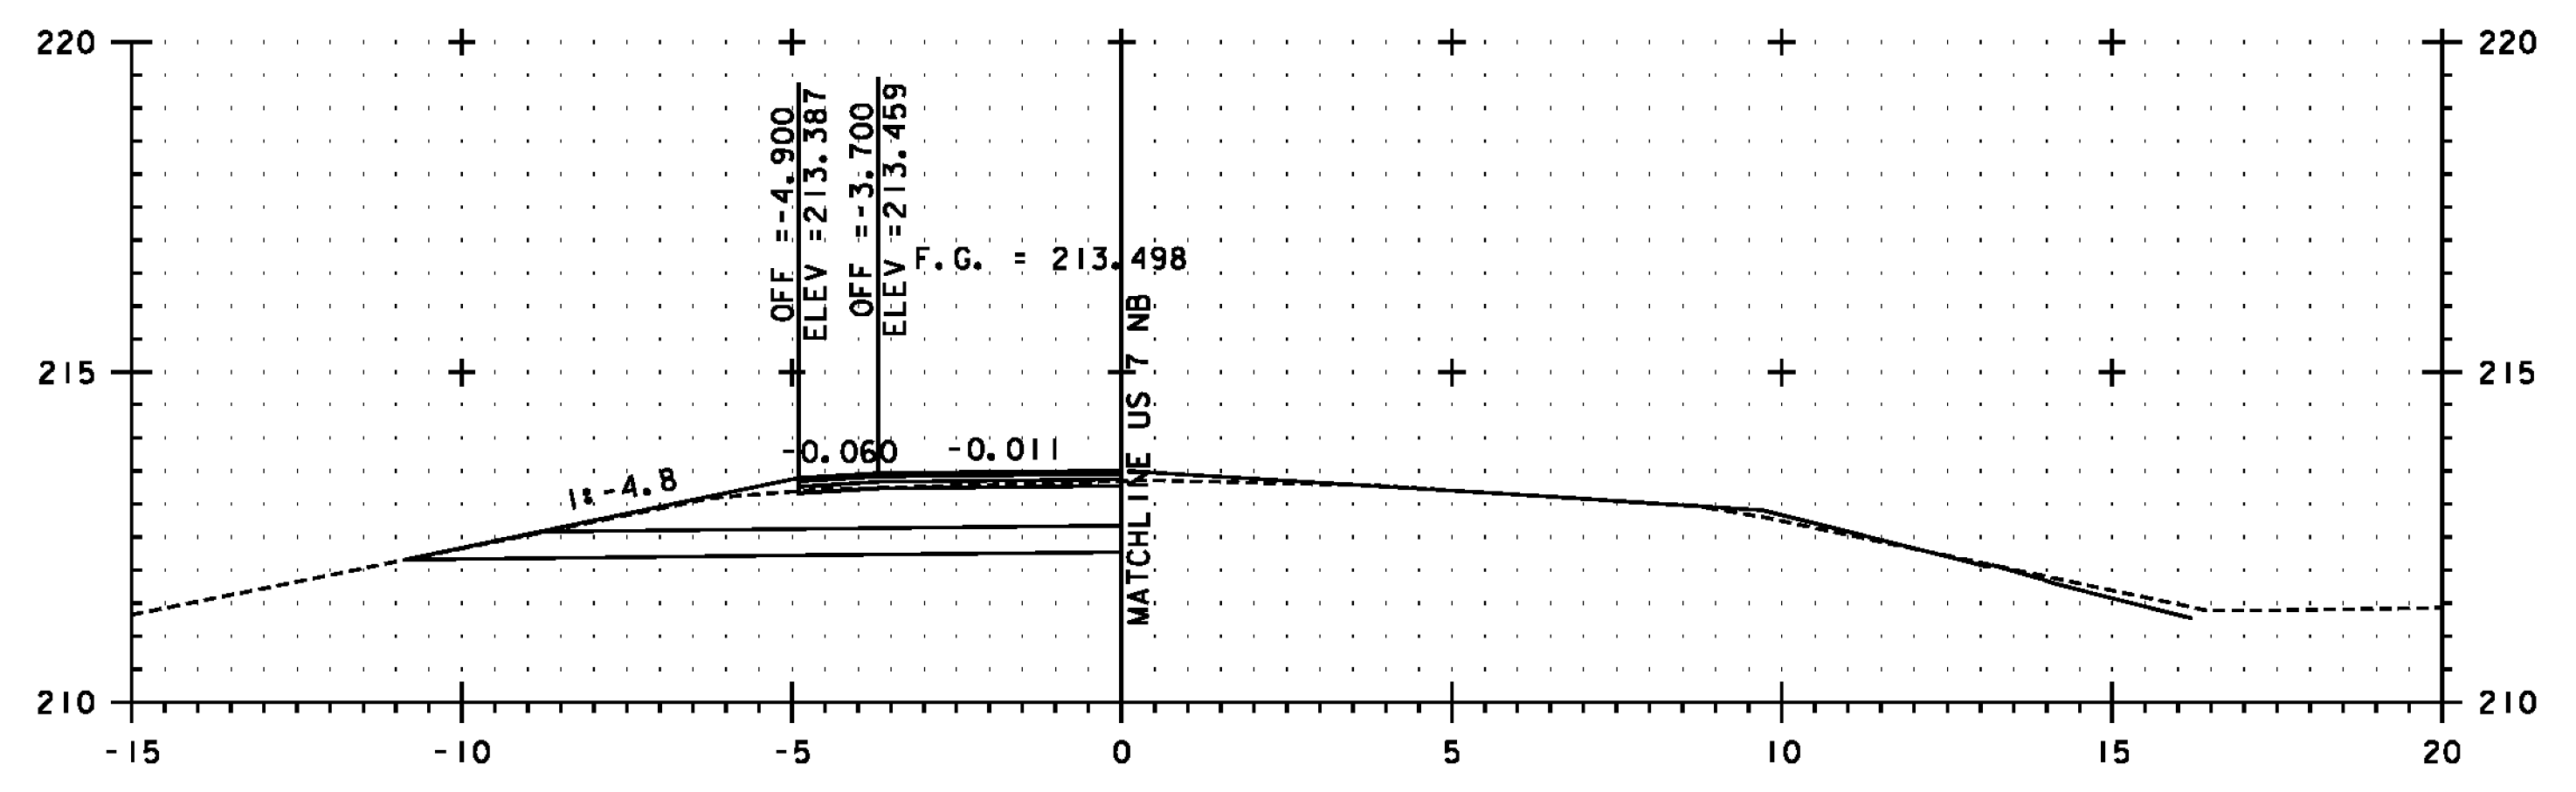

G 2+300

SEE NOTE ON SHEET 370

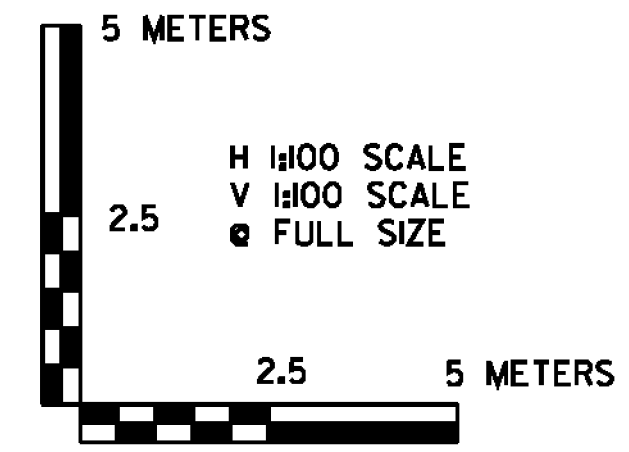

PROJECT NAME:	BENNINGTON
PROJECT NUMBER:	NH 019-(154)
FILE NAME:	...plot_files\zd307c4xs.rampG.ptf
DESIGN SUPERVISOR:	GREG EDWARDS
DESIGNED BY:	MARC FOISY
DRAWN BY:	STANTEC
CHECKED BY:	GARY SANTY
RAMP G CROSS SECTION	GXS-12
	SHEET 381 OF 468

1/26/2010 4:57:15 PM v:\1953\getlive\19530002\tr\anspor\station\dr\w\ng\com\tr\cpf_4\plot_files\zd307c4xs.rampG.ptf