




I I+020

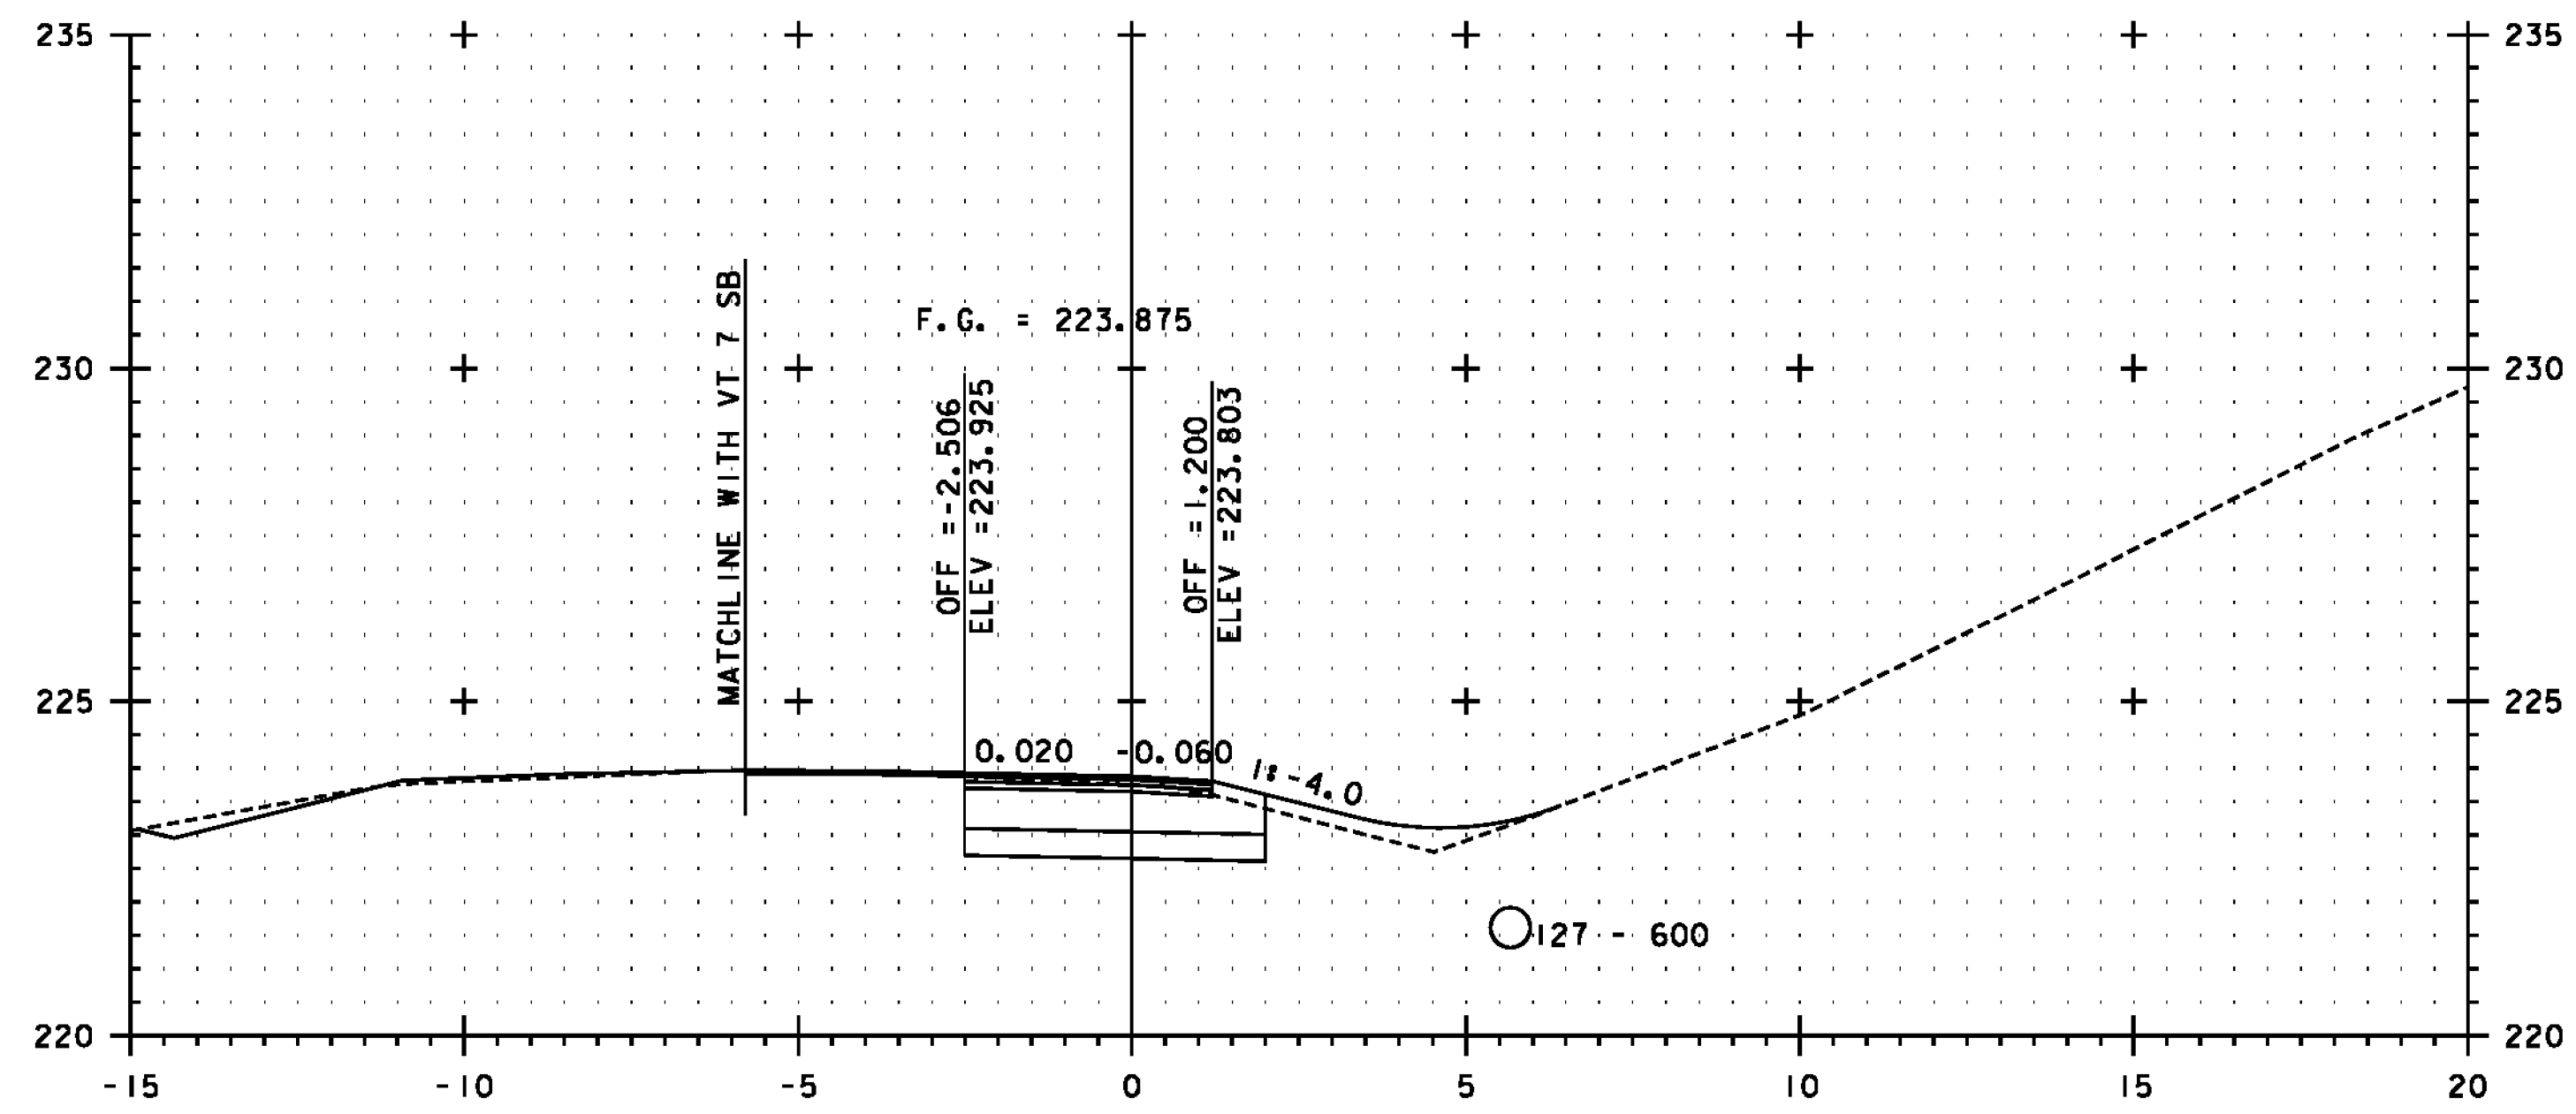

I I+060

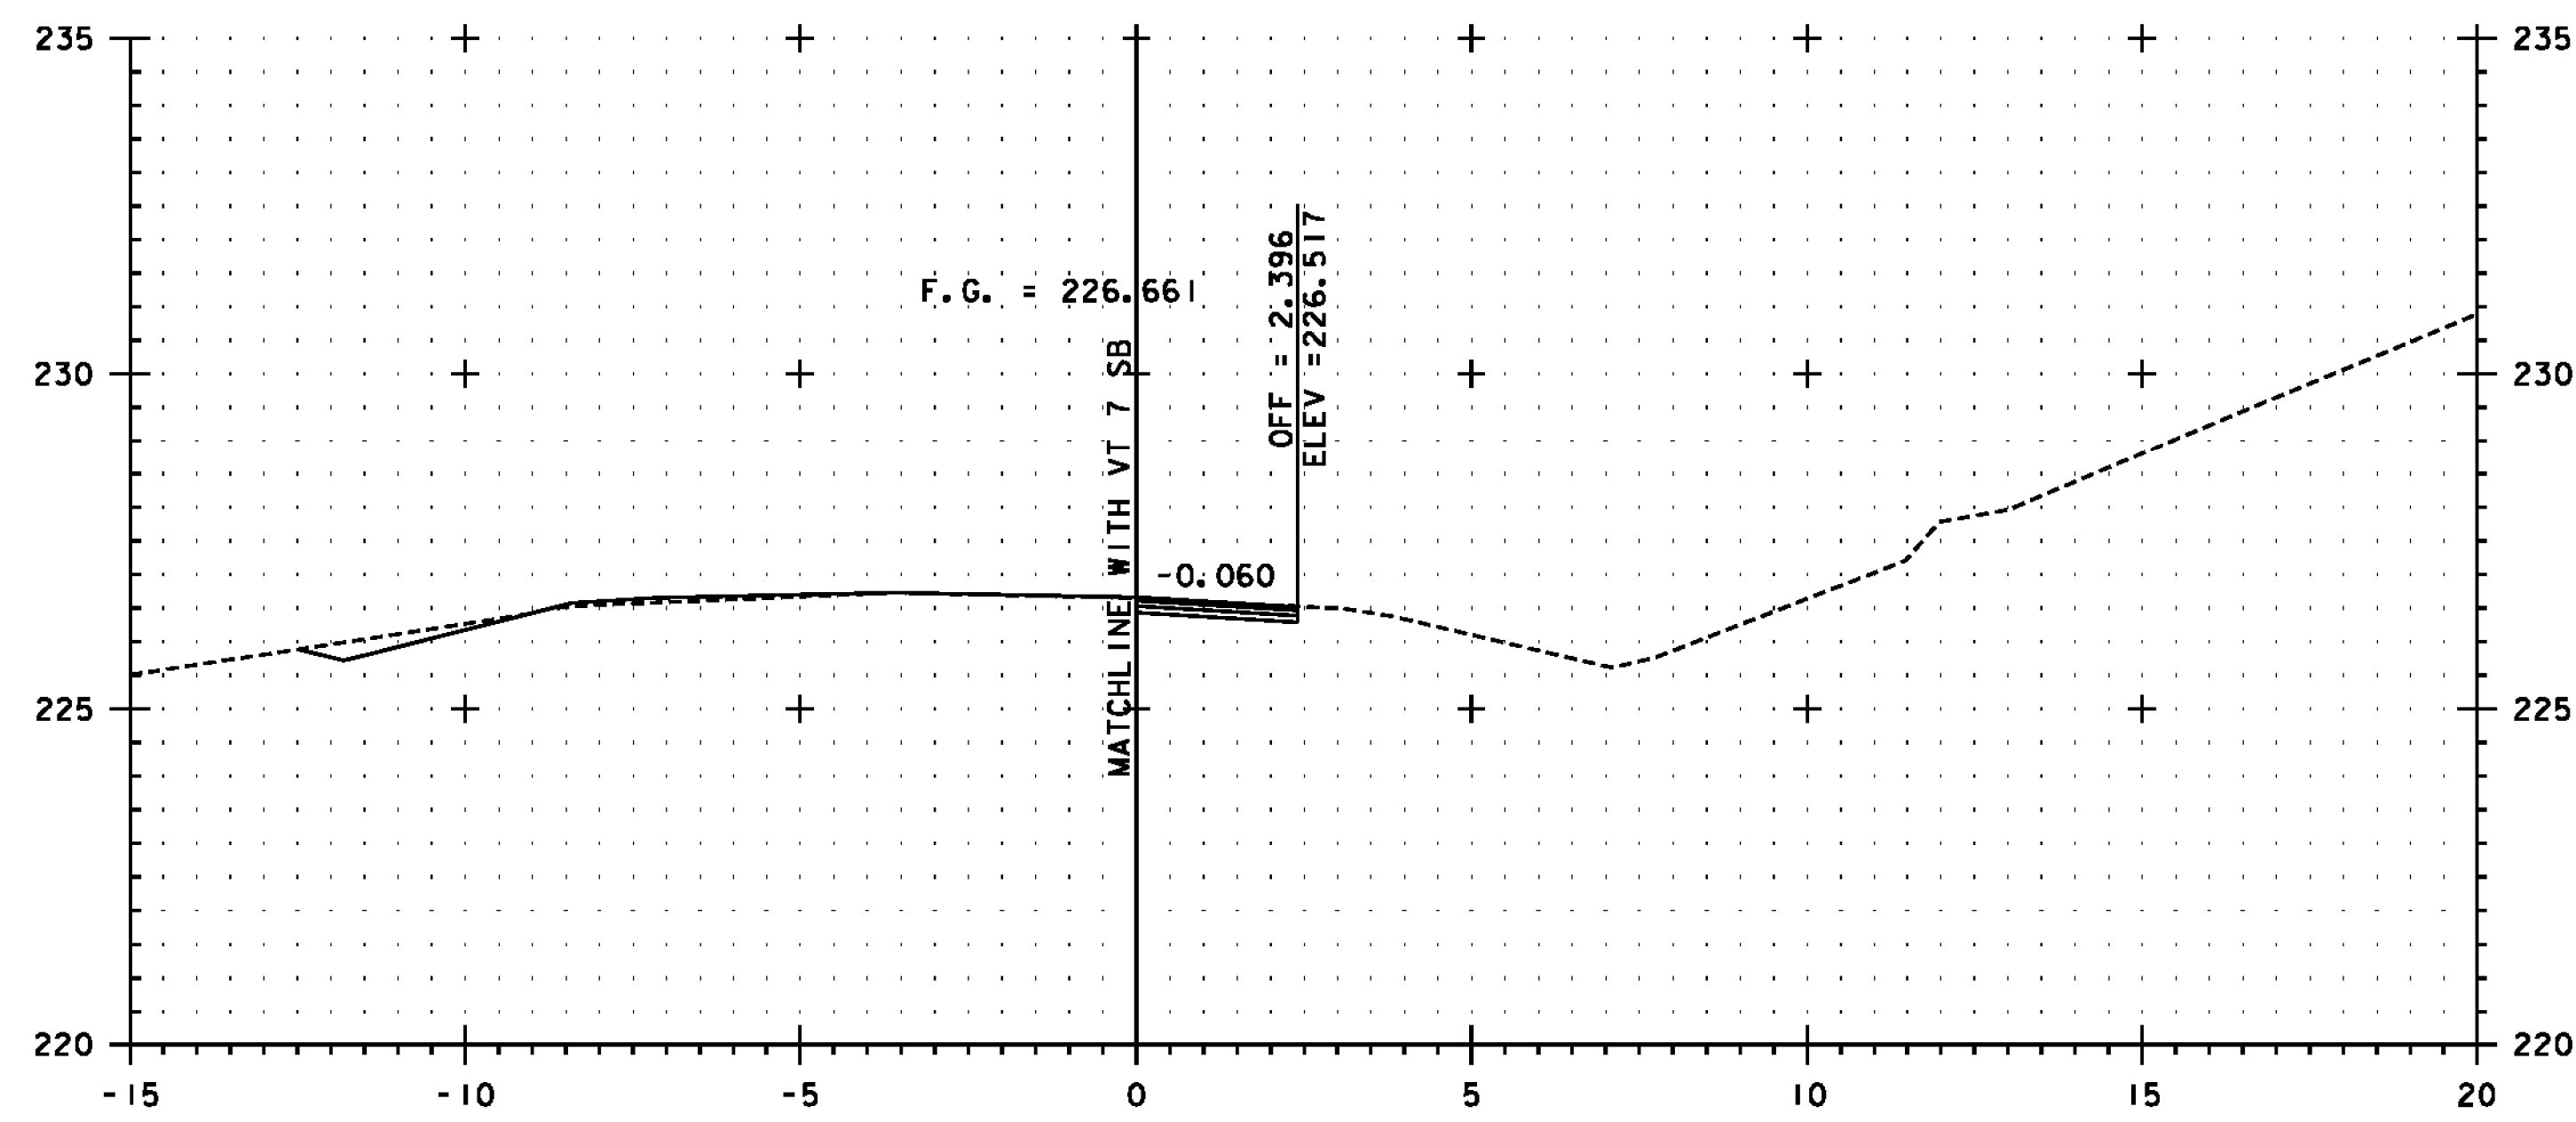


I I+000 = SB I I+483.722

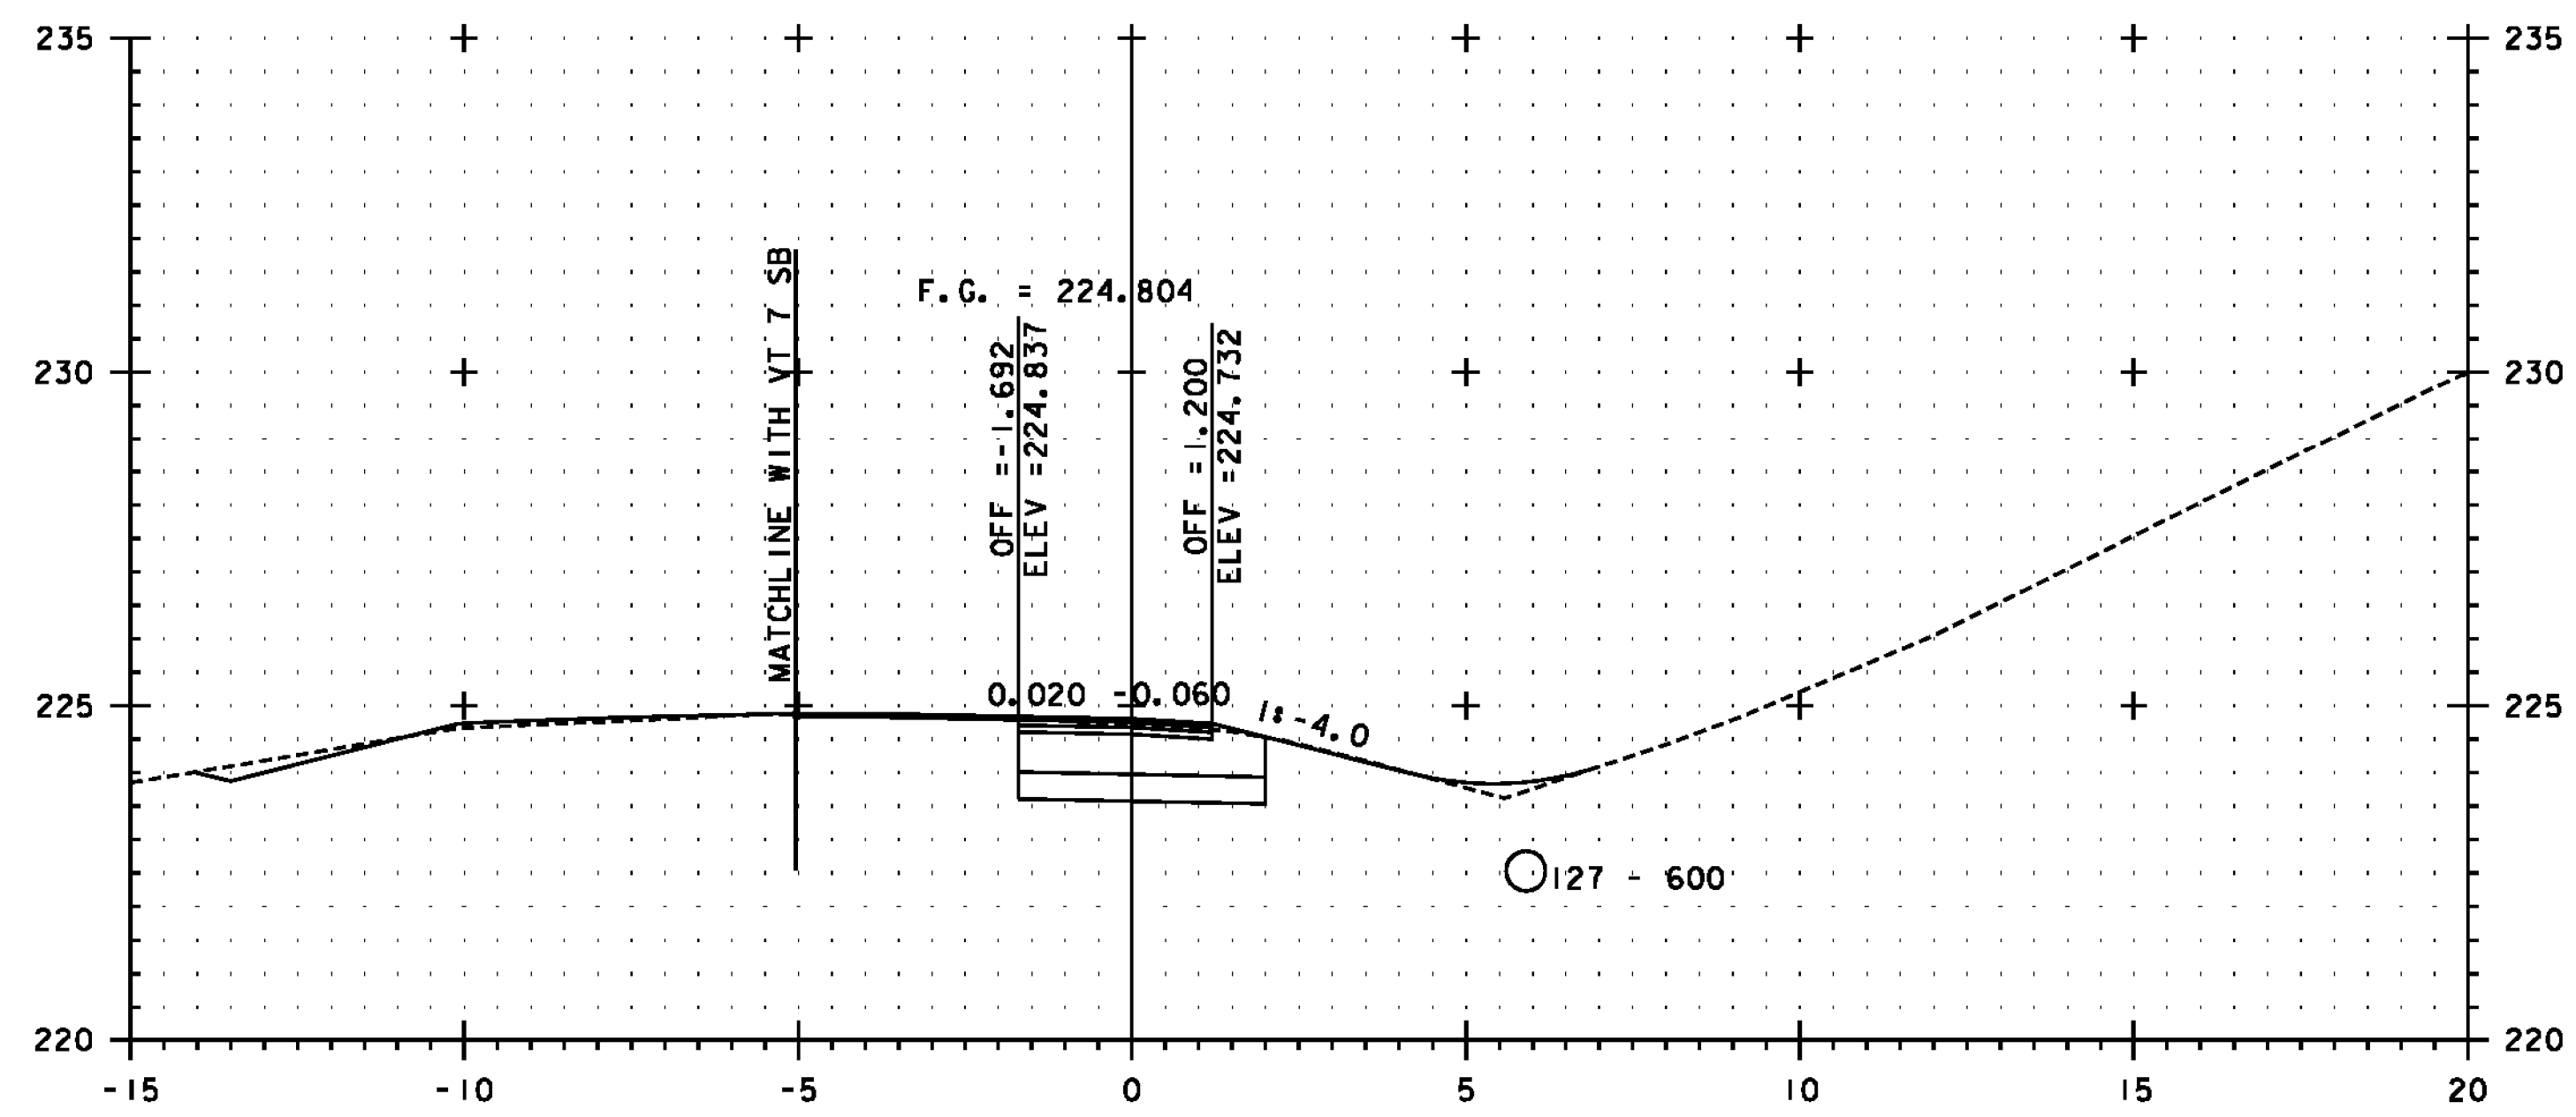

I I+040

NOTE: FINAL CROSS SECTIONS FOR RAMP I ARE CONTAINED IN THE FINAL COMP BOOKS FOR ITEM 203.15 - COMMON EXCAVATION

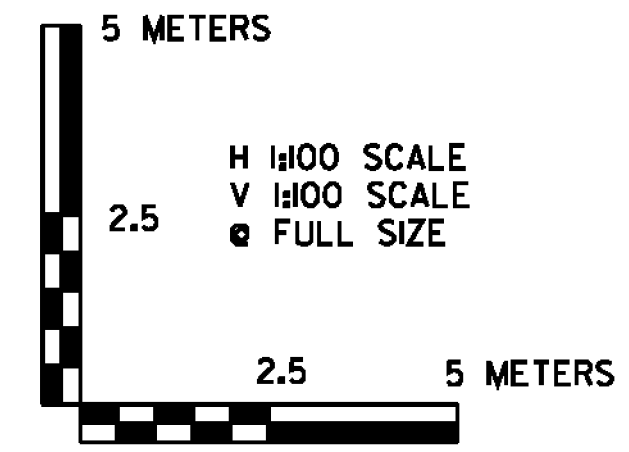

PROJECT NAME:	BENNINGTON
PROJECT NUMBER:	NH 019-(154)
FILE NAME:	...plot_files\zd307c4xs.ramp1.ptf
DESIGN SUPERVISOR:	GREG EDWARDS
DESIGNED BY:	MARC FOISY
RAMP I CROSS SECTION	IXS-01
PLOT DATE:	1/26/2010
DRAWN BY:	STANTEC
CHECKED BY:	GARY SANTY
SHEET	382 OF 468

1/26/2010 4:57:17 PM v:\1953\getlive\19530002\transportation\drw\mg\comp\tr\cpt\_4\plot\_files\zd307c4xs.ramp1.ptf