




I+100

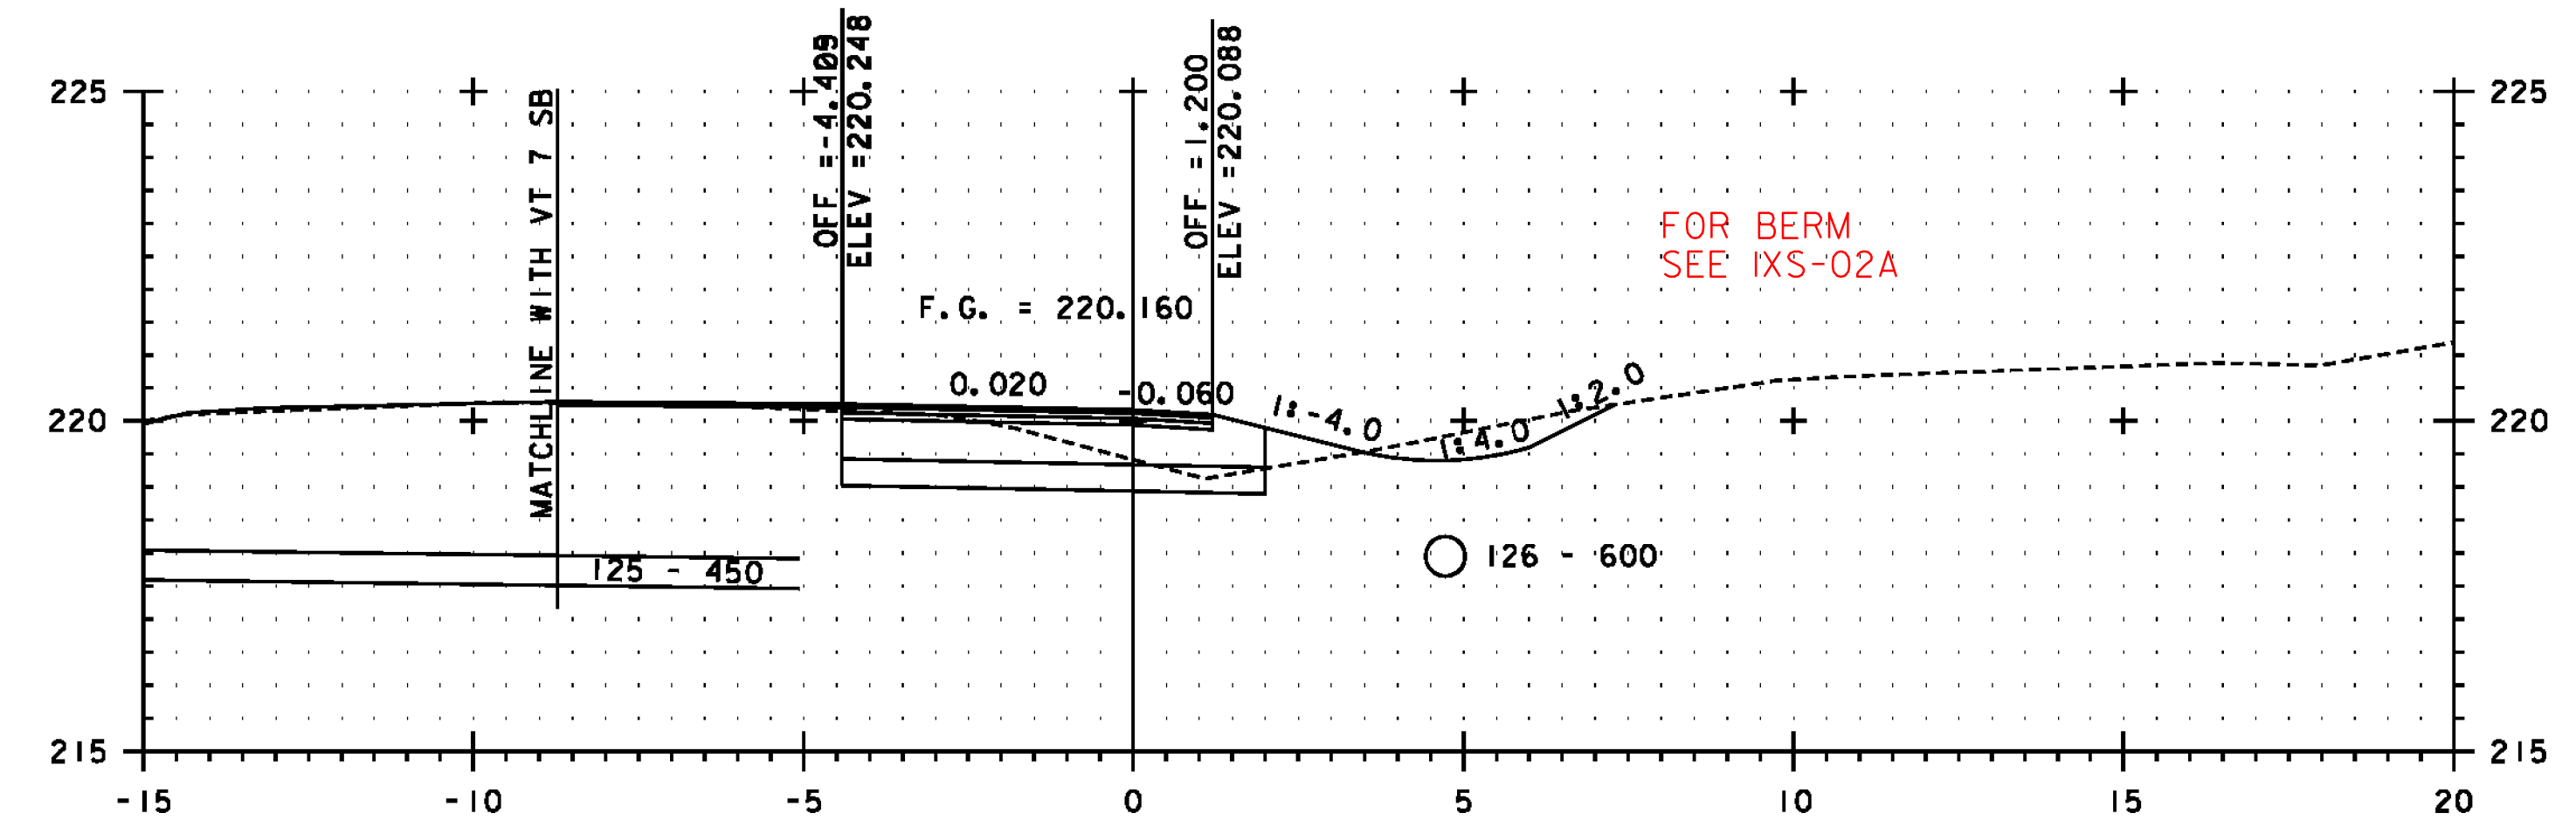

I+140

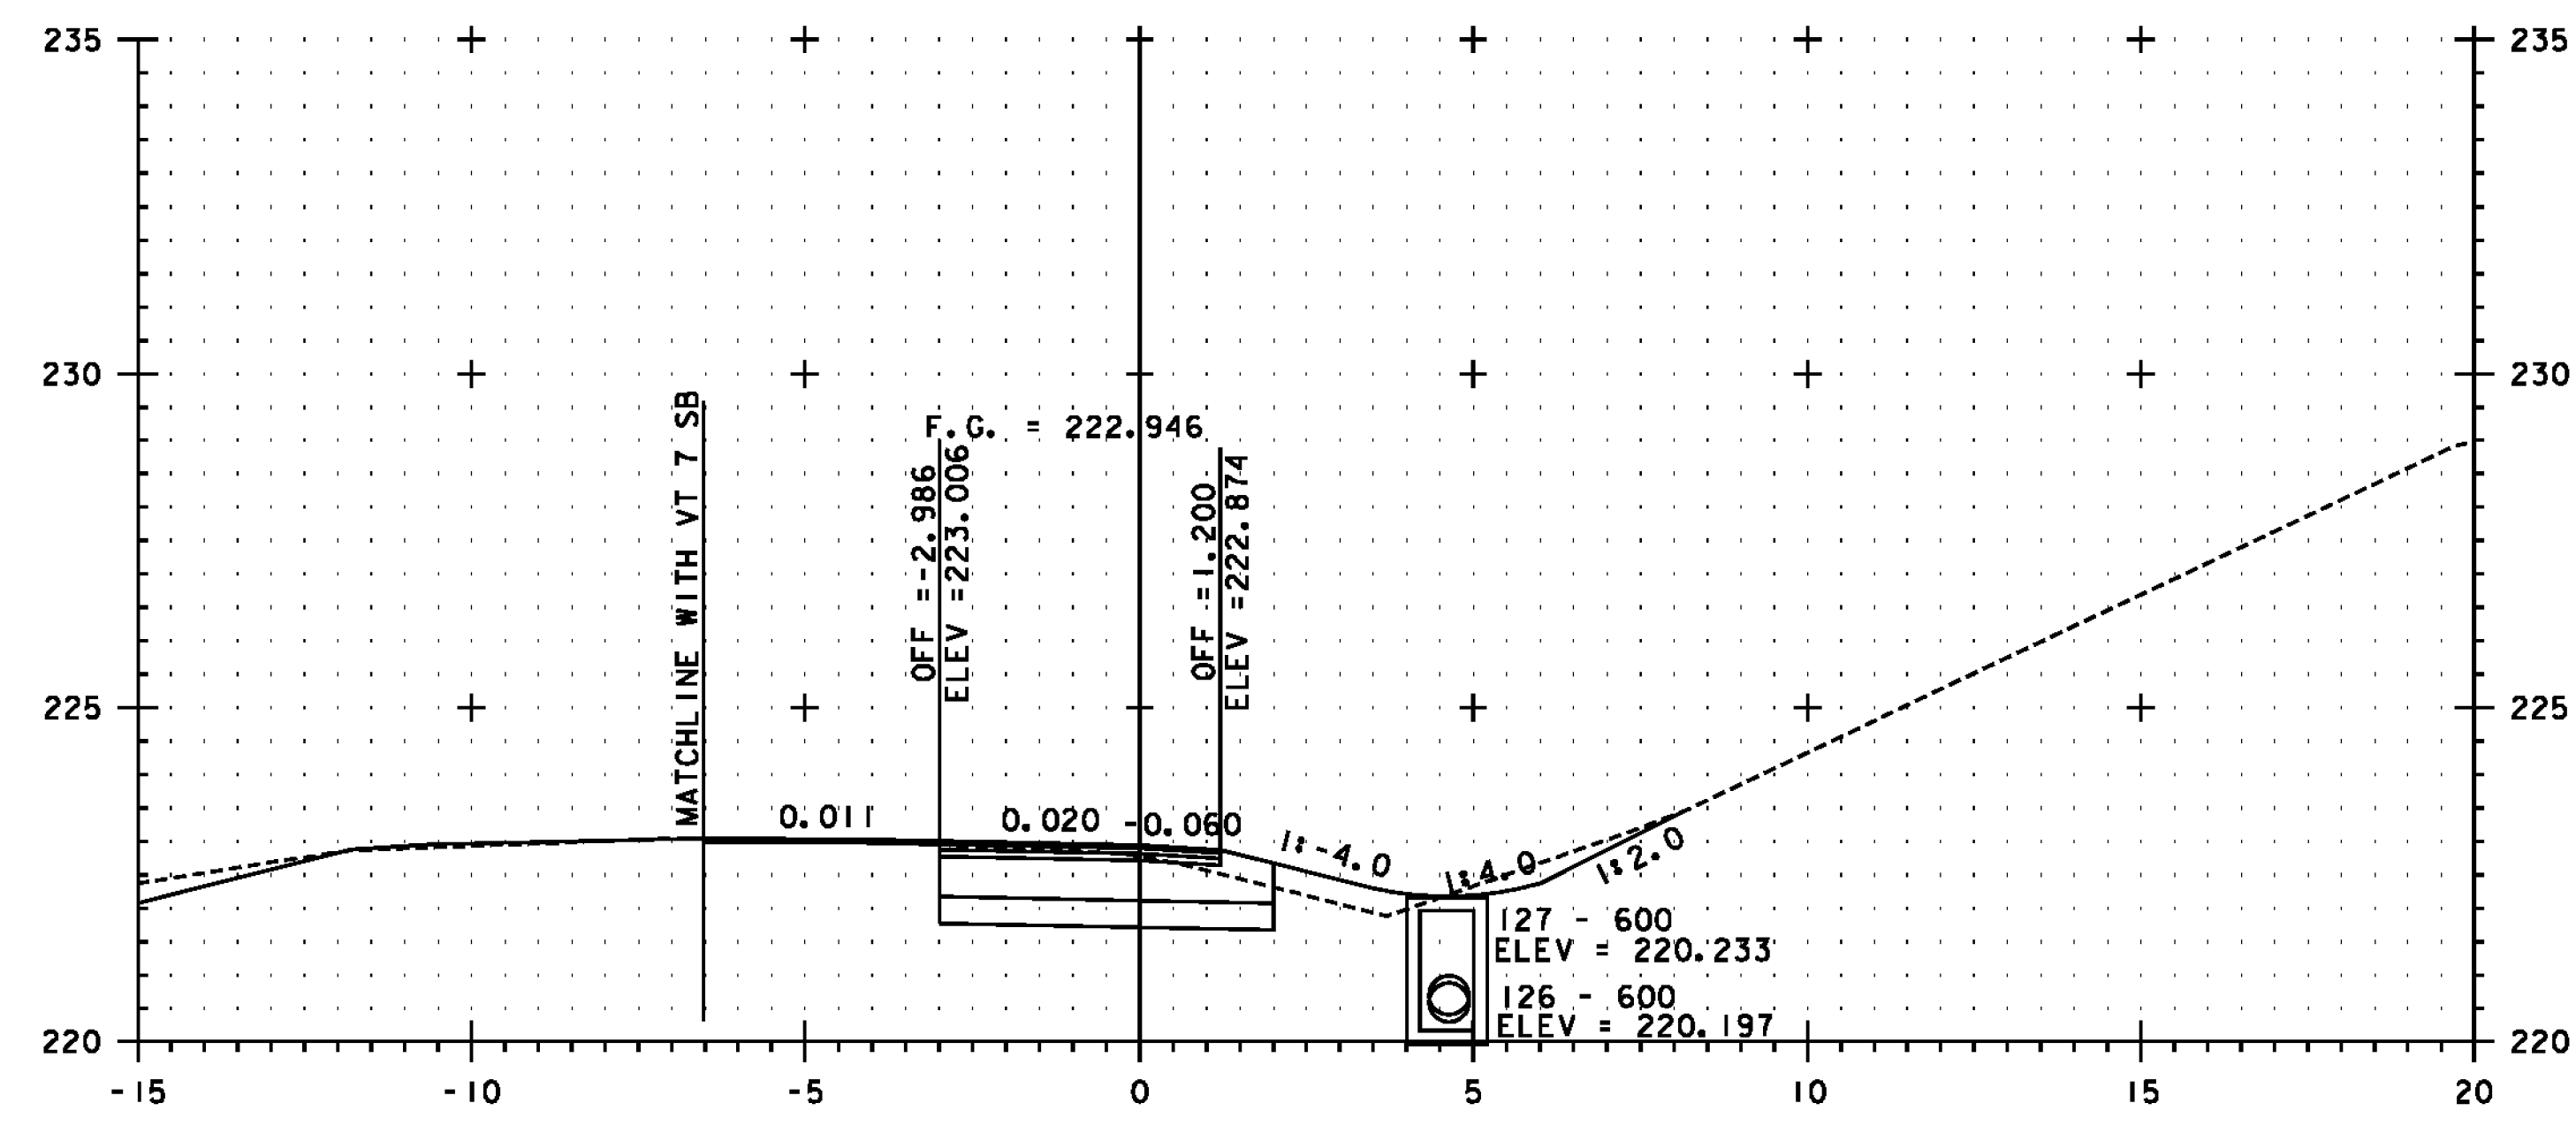


I+080

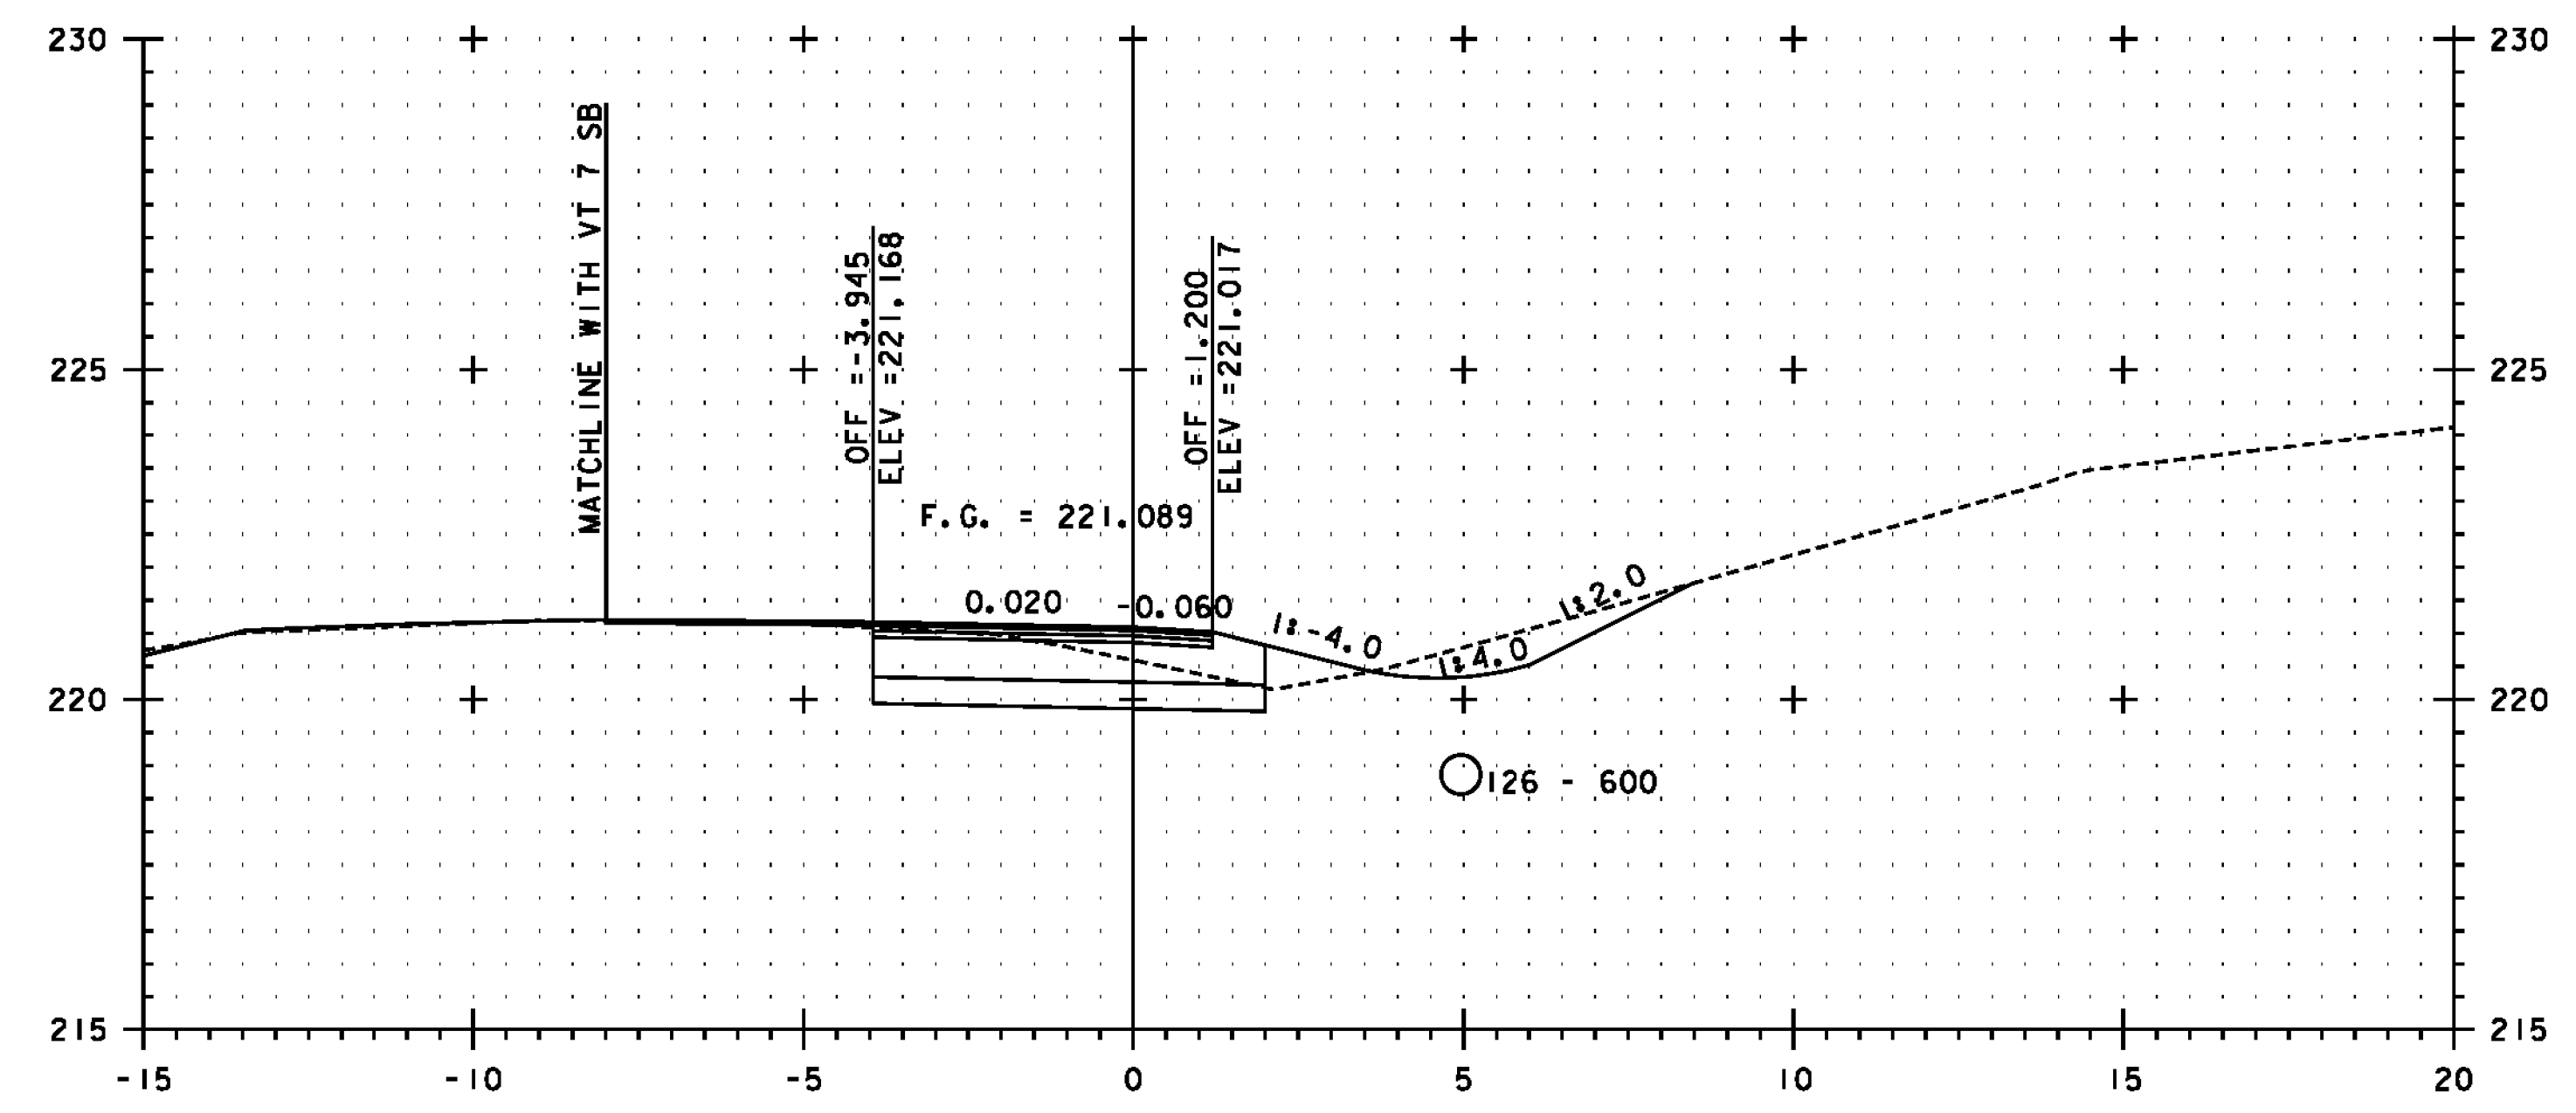

I+120

SEE NOTE ON SHEET 382

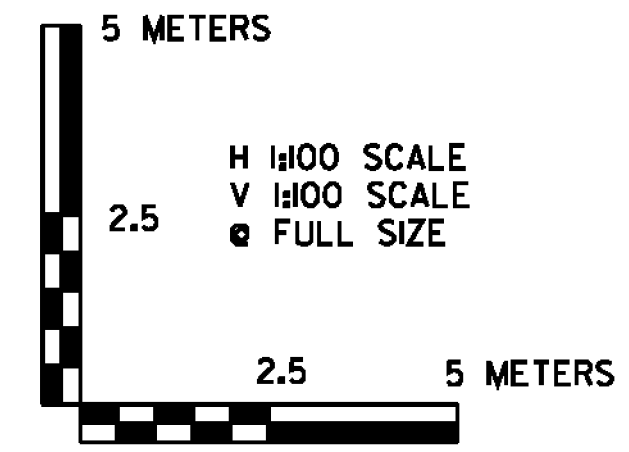

PROJECT NAME:	BENNINGTON
PROJECT NUMBER:	NH 019-(154)
FILE NAME:	...plot_files\zd307c4xs.ramp1.tif
DESIGN SUPERVISOR:	GREG EDWARDS
DESIGNED BY:	MARC FOISY
RAMP I CROSS SECTION	IXS-02
PLOT DATE:	1/26/2010
DRAWN BY:	STANTEC
CHECKED BY:	GARY SANTY
SHEET	383 OF 468

1/26/2010 4:57:19 PM v:\1953\getlive\19530002\tr\anspor\ref\ion\dr\cm\ng\com\tr\cst\_4\p101\_files\zd307c4xs.ramp1.tif