




I+180

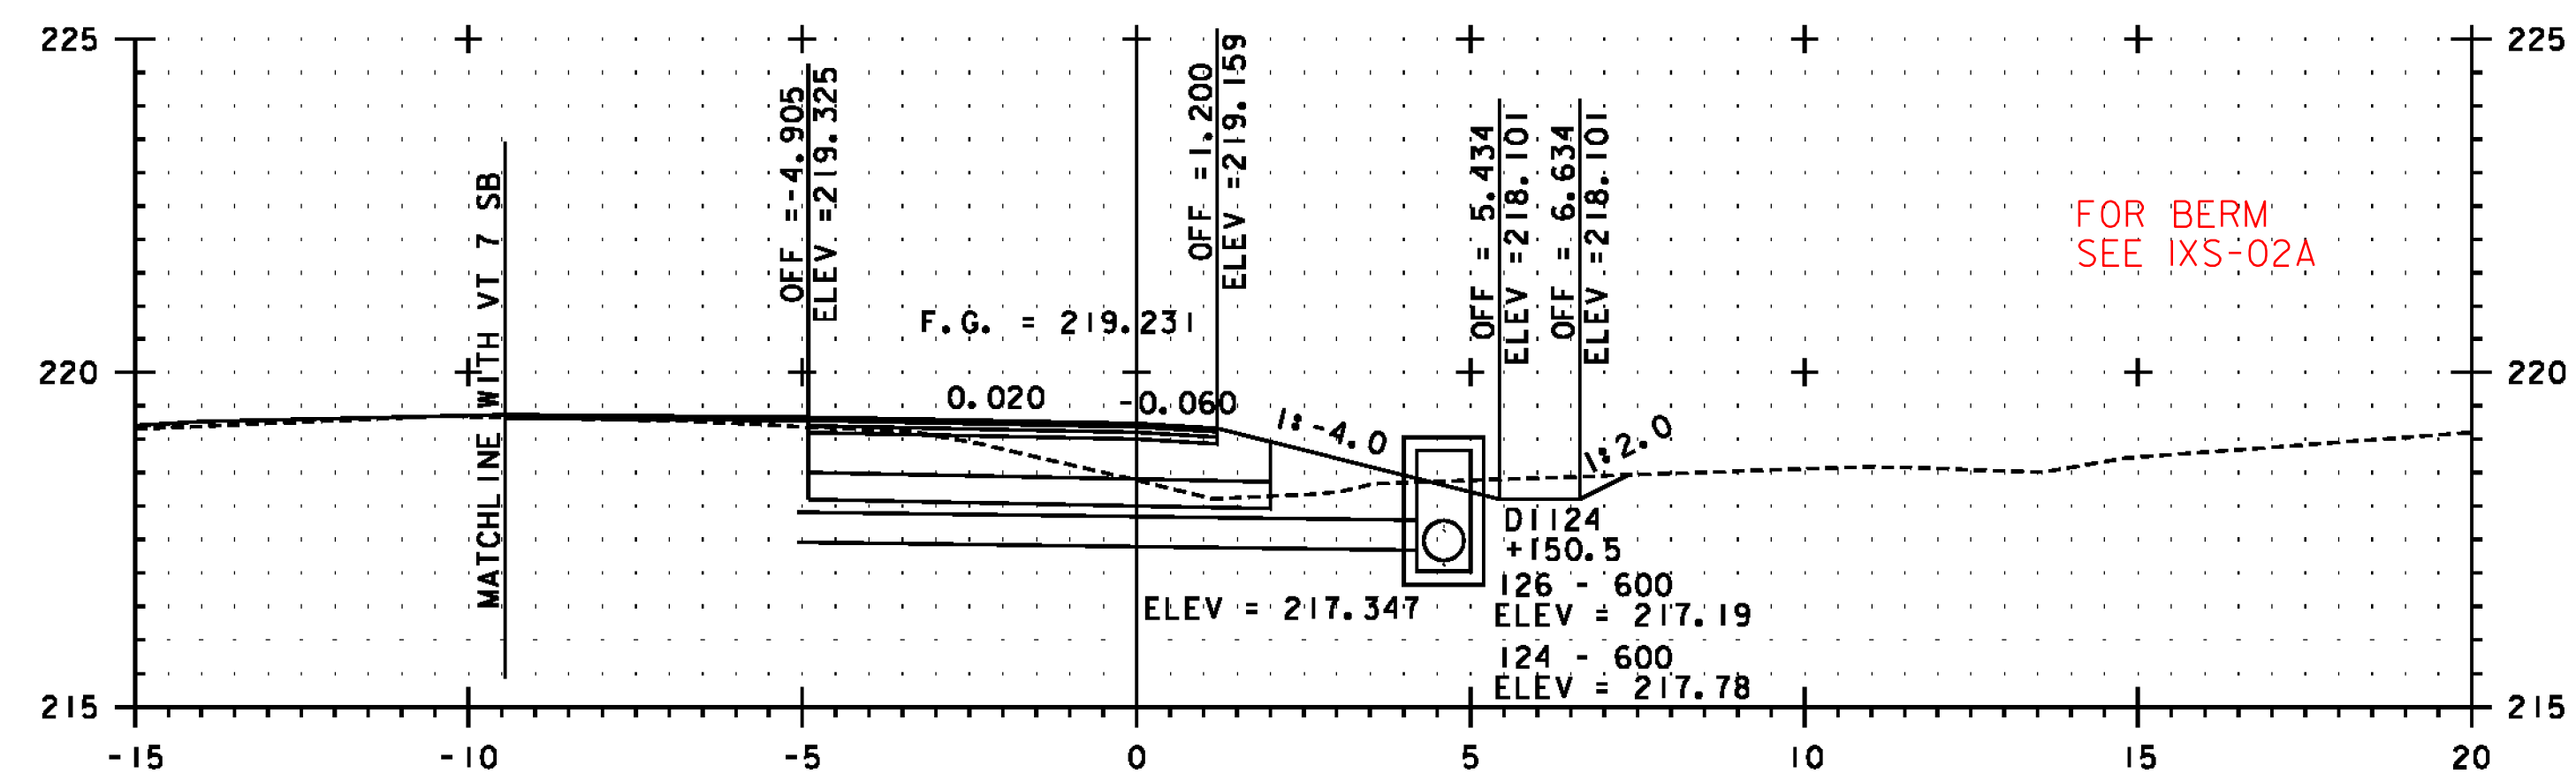

I+160

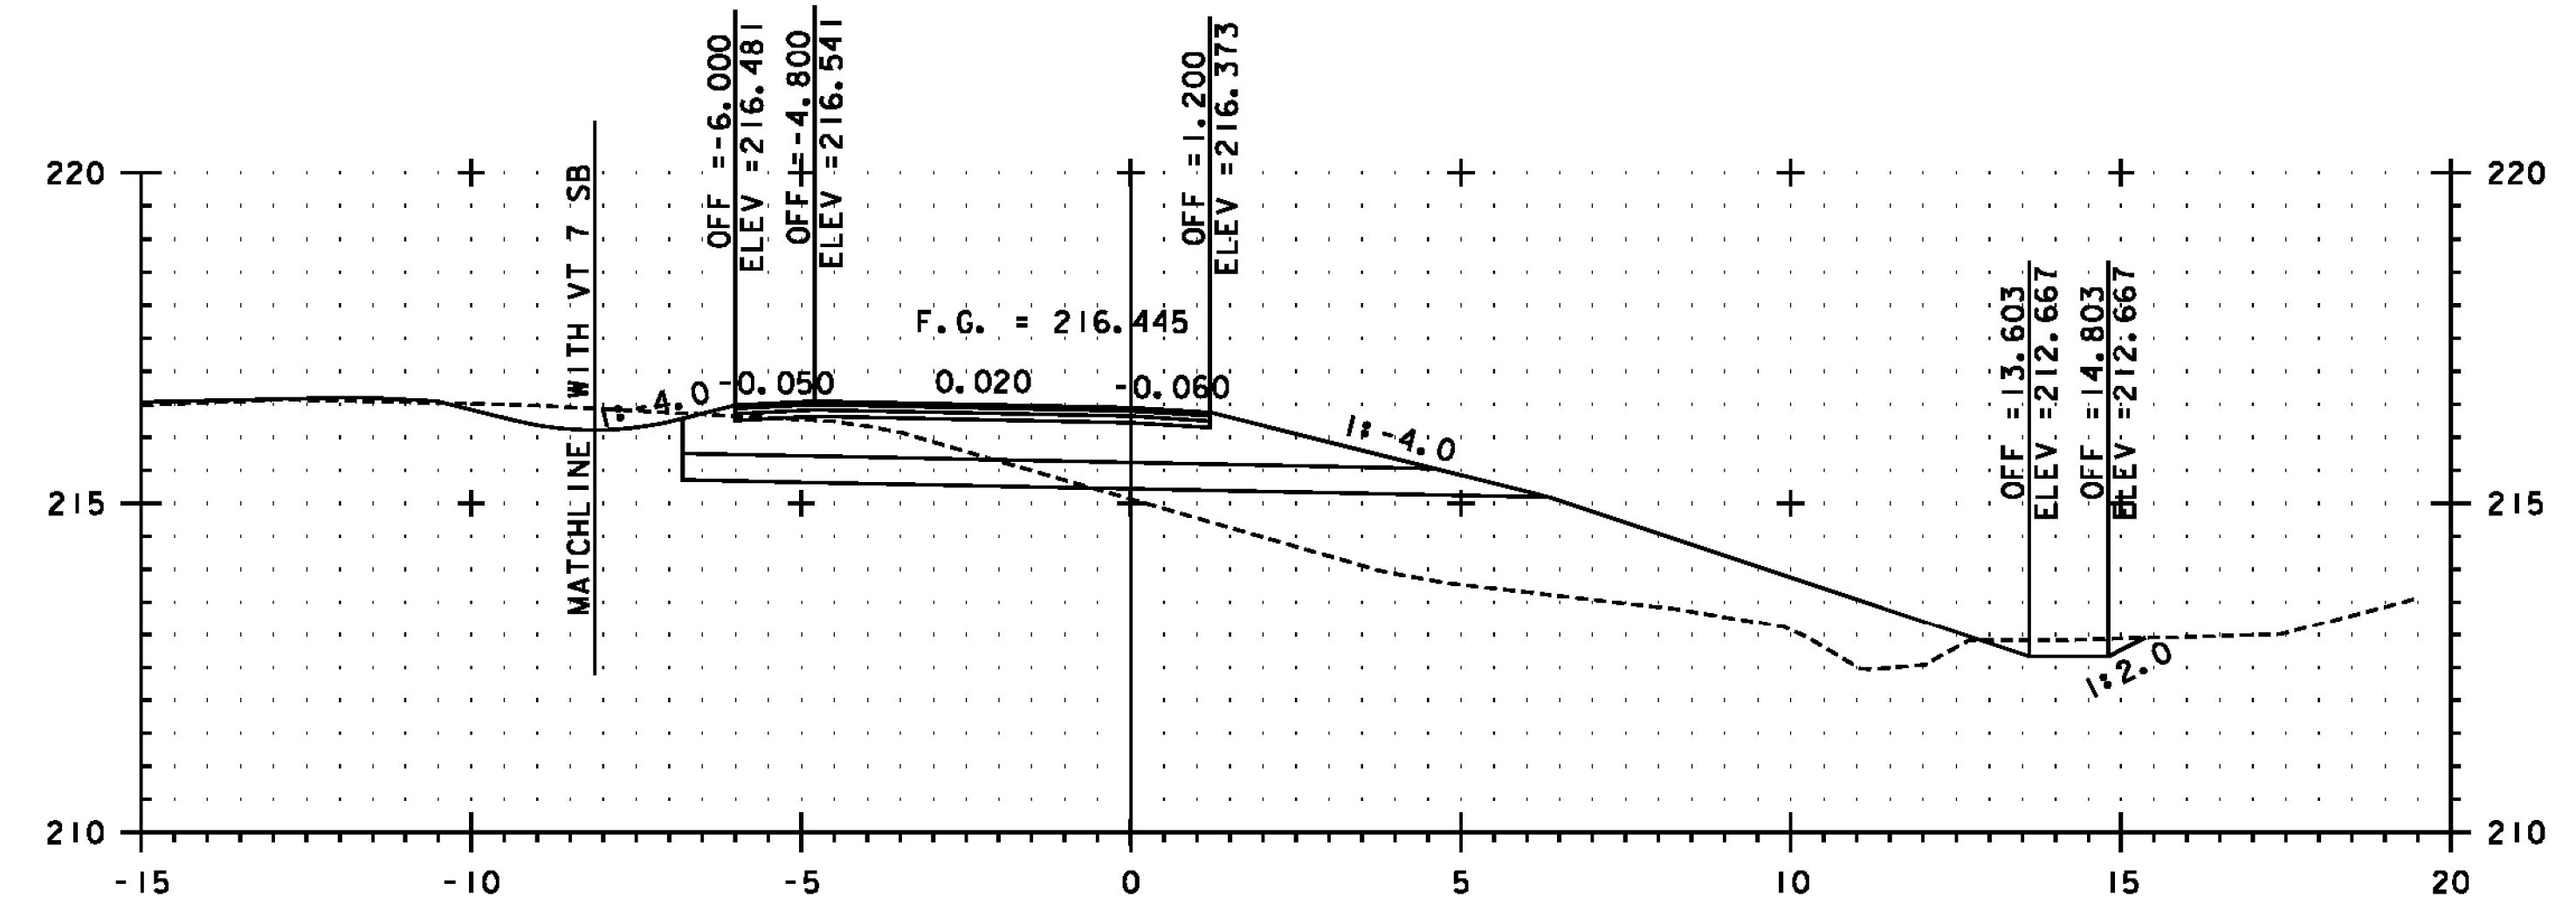


I+220

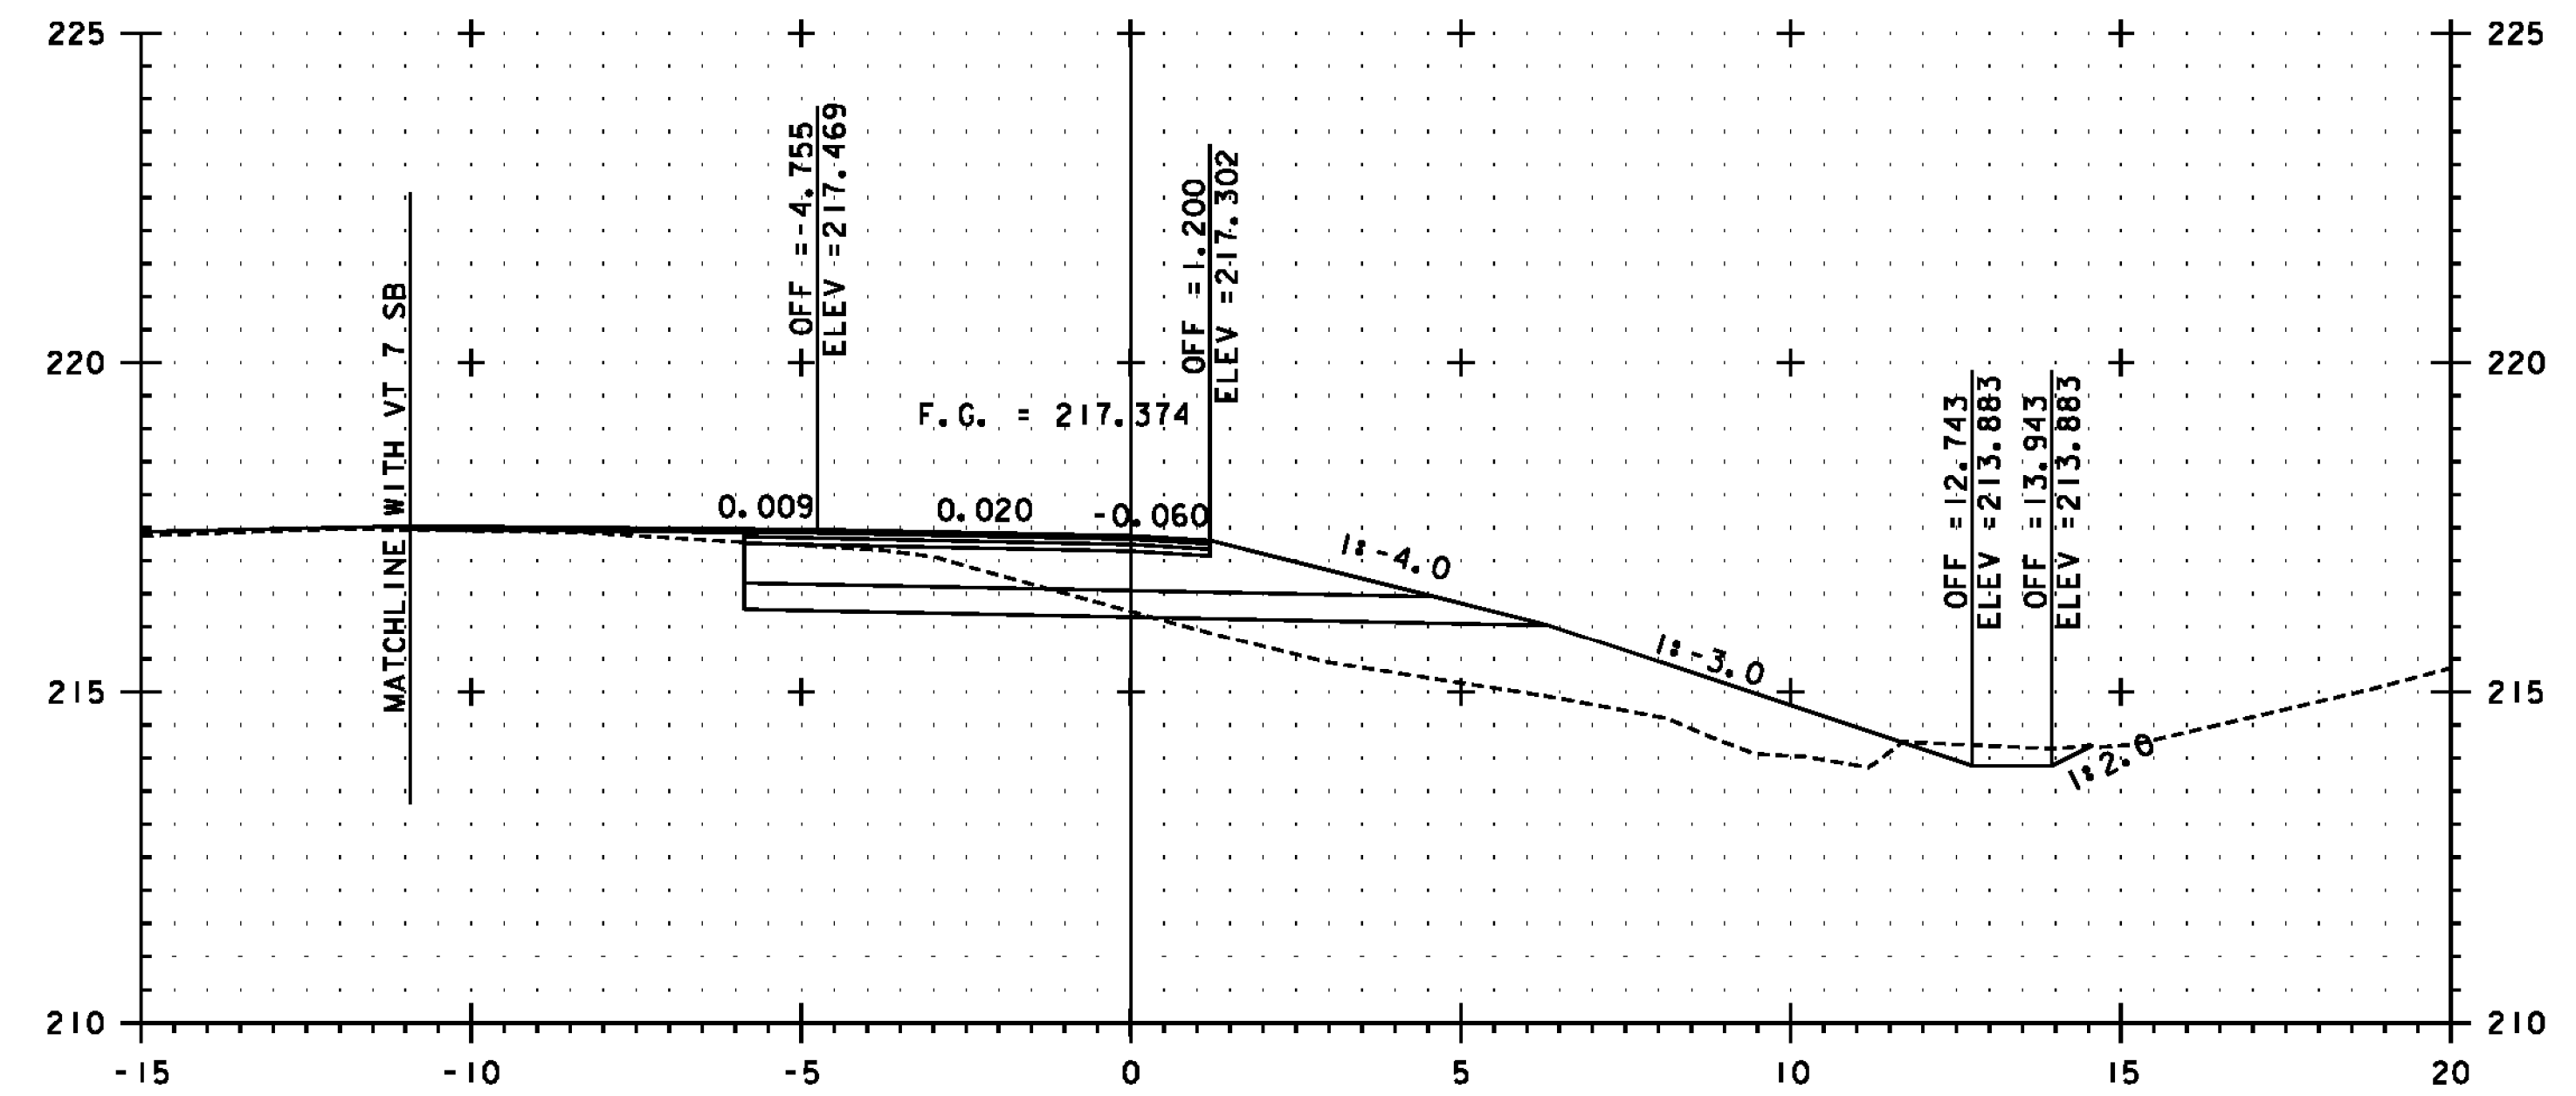

I+200

SEE NOTE ON SHEET 382

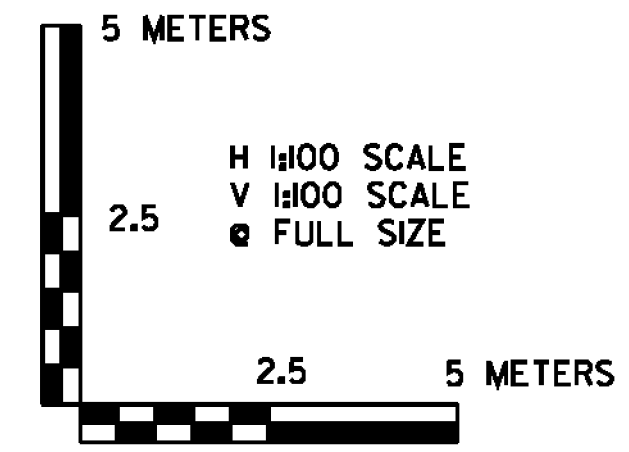

	PROJECT NAME: BENNINGTON
	PROJECT NUMBER: NH 019-(K54)
FILE NAME: ...\plot_files\zd307c4xs.ramp1.tif	PLOT DATE: 1/26/2010
DESIGN SUPERVISOR: GREG EDWARDS	DRAWN BY: STANTEC
DESIGNED BY: MARC FOISY	CHECKED BY: GARY SANTY
RAMP I CROSS SECTION IXS-03	SHEET 384 OF 468

1/26/2010 4:57:20 PM v:\1953\getlive\19530002A\tramsport\station\dr\w\ng\com\tr\cst_4\plot_files\zd307c4xs.ramp1.tif