




I+260

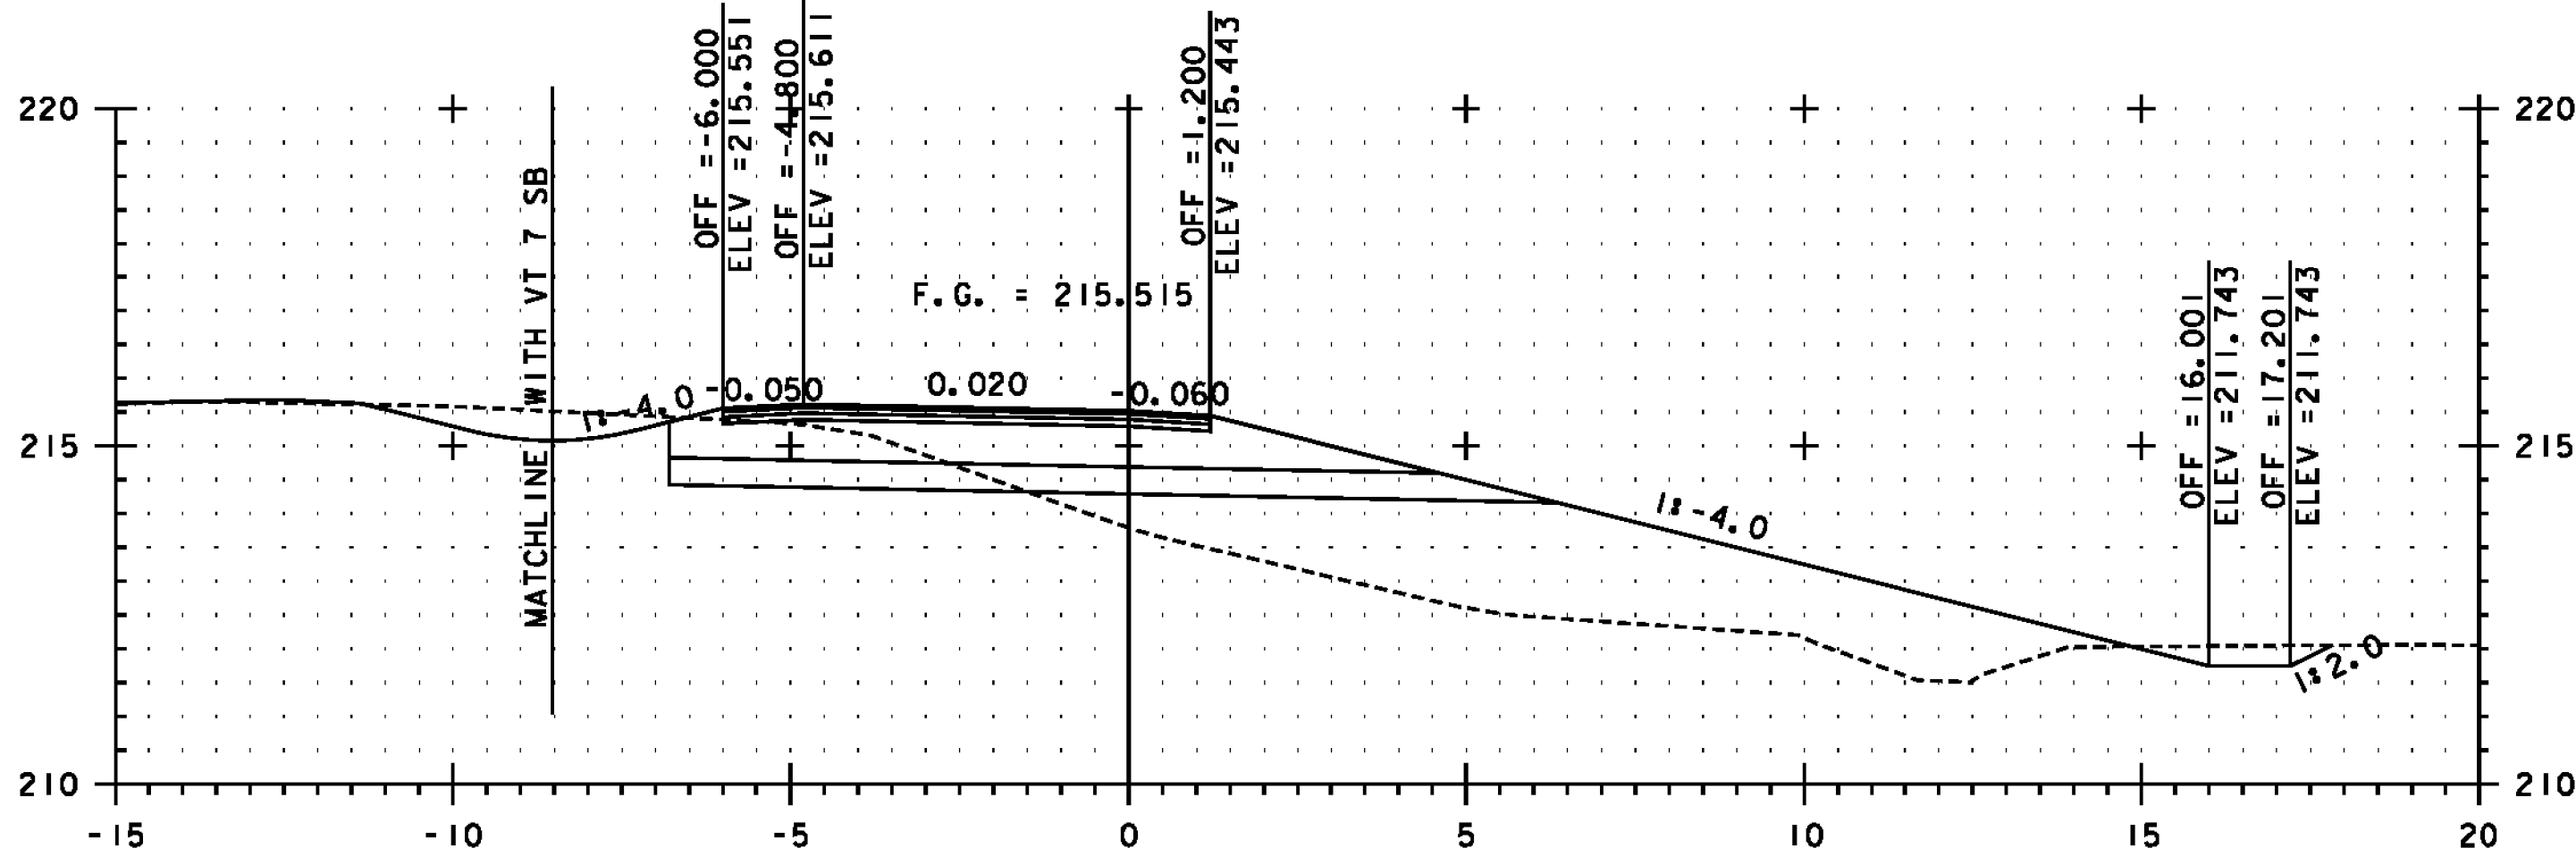

I+240

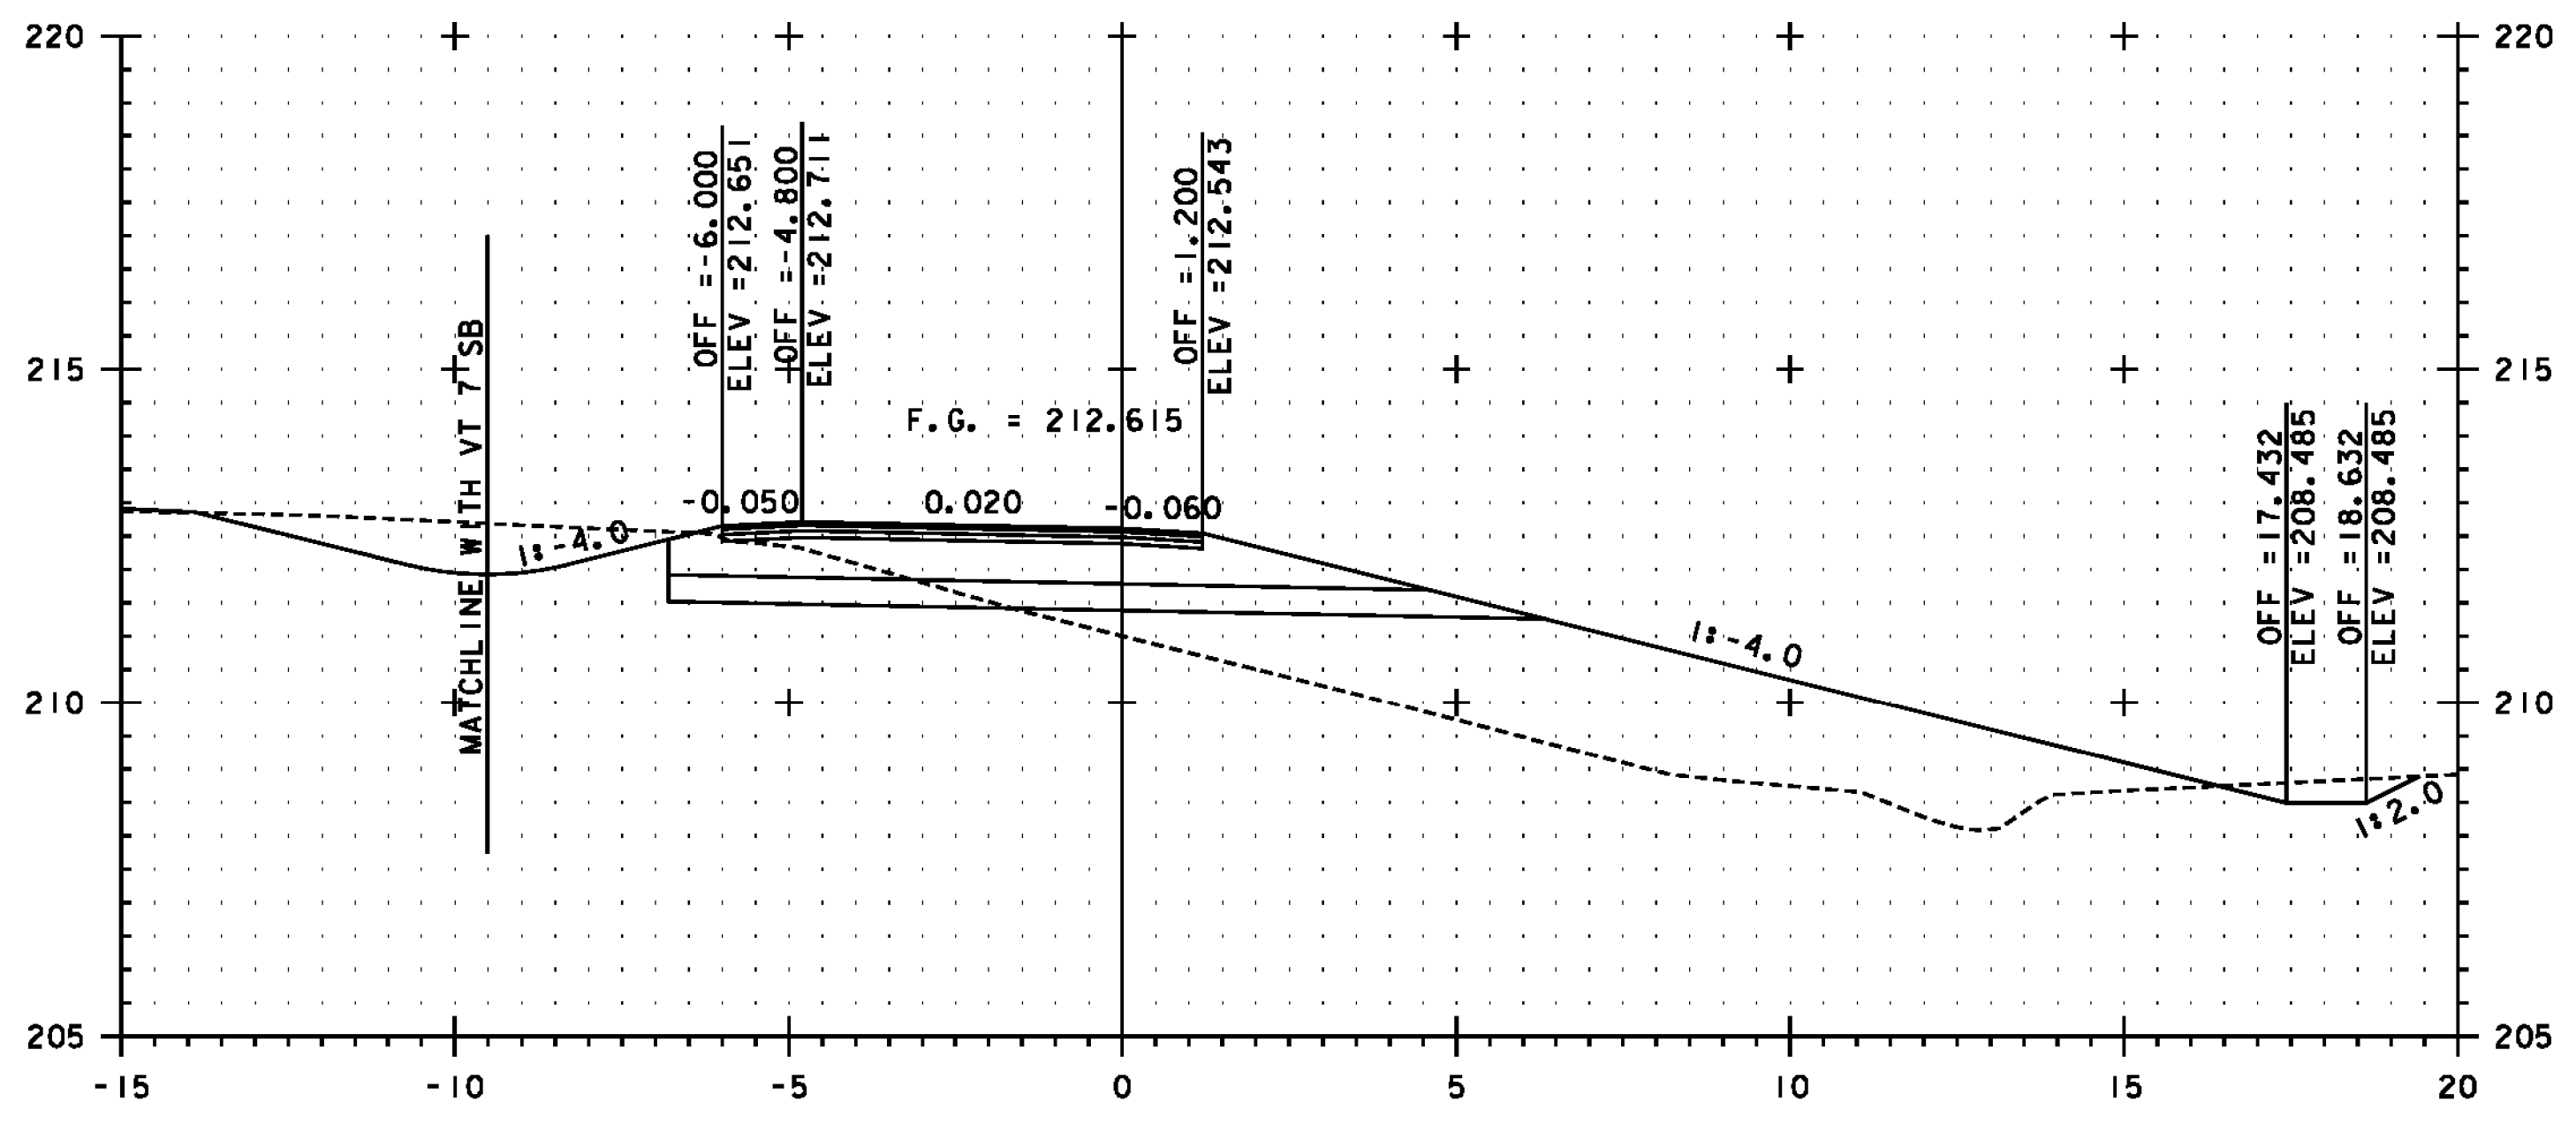


I+300

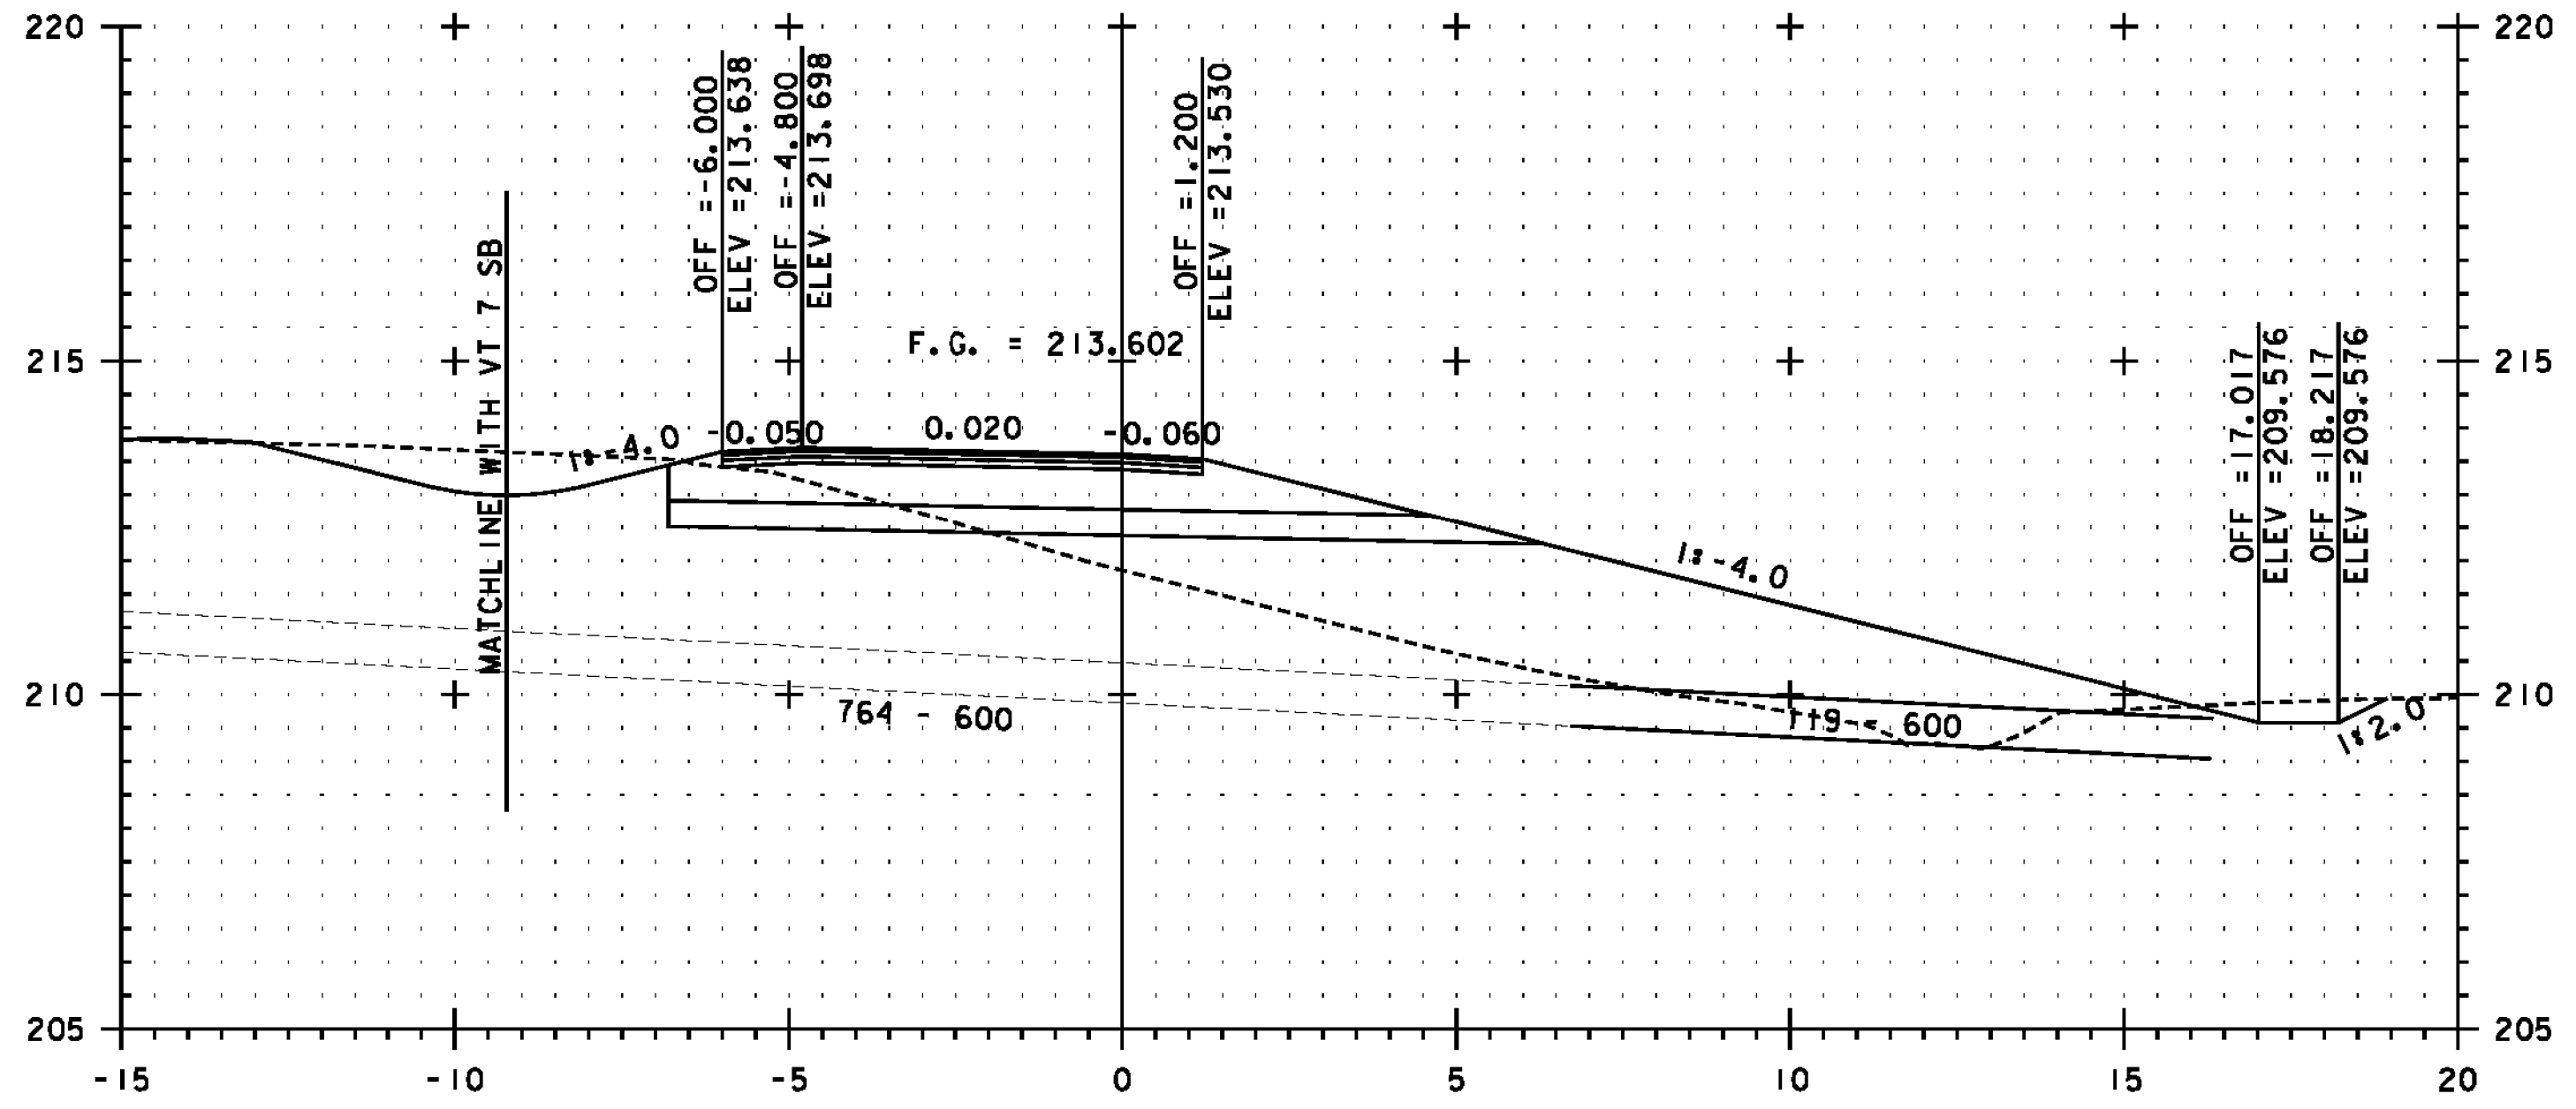

I+280

SEE NOTE ON SHEET 382

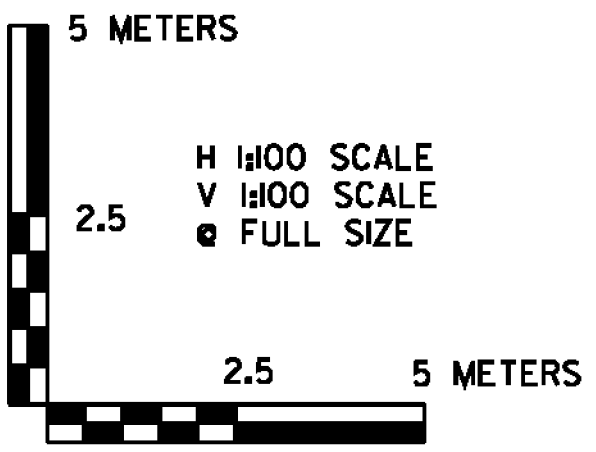

PROJECT NAME:	BENNINGTON
PROJECT NUMBER:	NH 019-(154)
FILE NAME:	...plot_files\zd307c4xs.ramp1.ptf
DESIGN SUPERVISOR:	GREG EDWARDS
DESIGNED BY:	MARC FOISY
RAMP I CROSS SECTION	IXS-04
PLOT DATE:	1/26/2010
DRAWN BY:	STANTEC
CHECKED BY:	GARY SANTY
SHEET	385 OF 468

1/26/2010 4:57:29 PM v:\1953\getlive\1953\0002\tr\anspor\101\dr\dwg\confr\01_4\p101_files\zd307c4xs.ramp1.ptf