

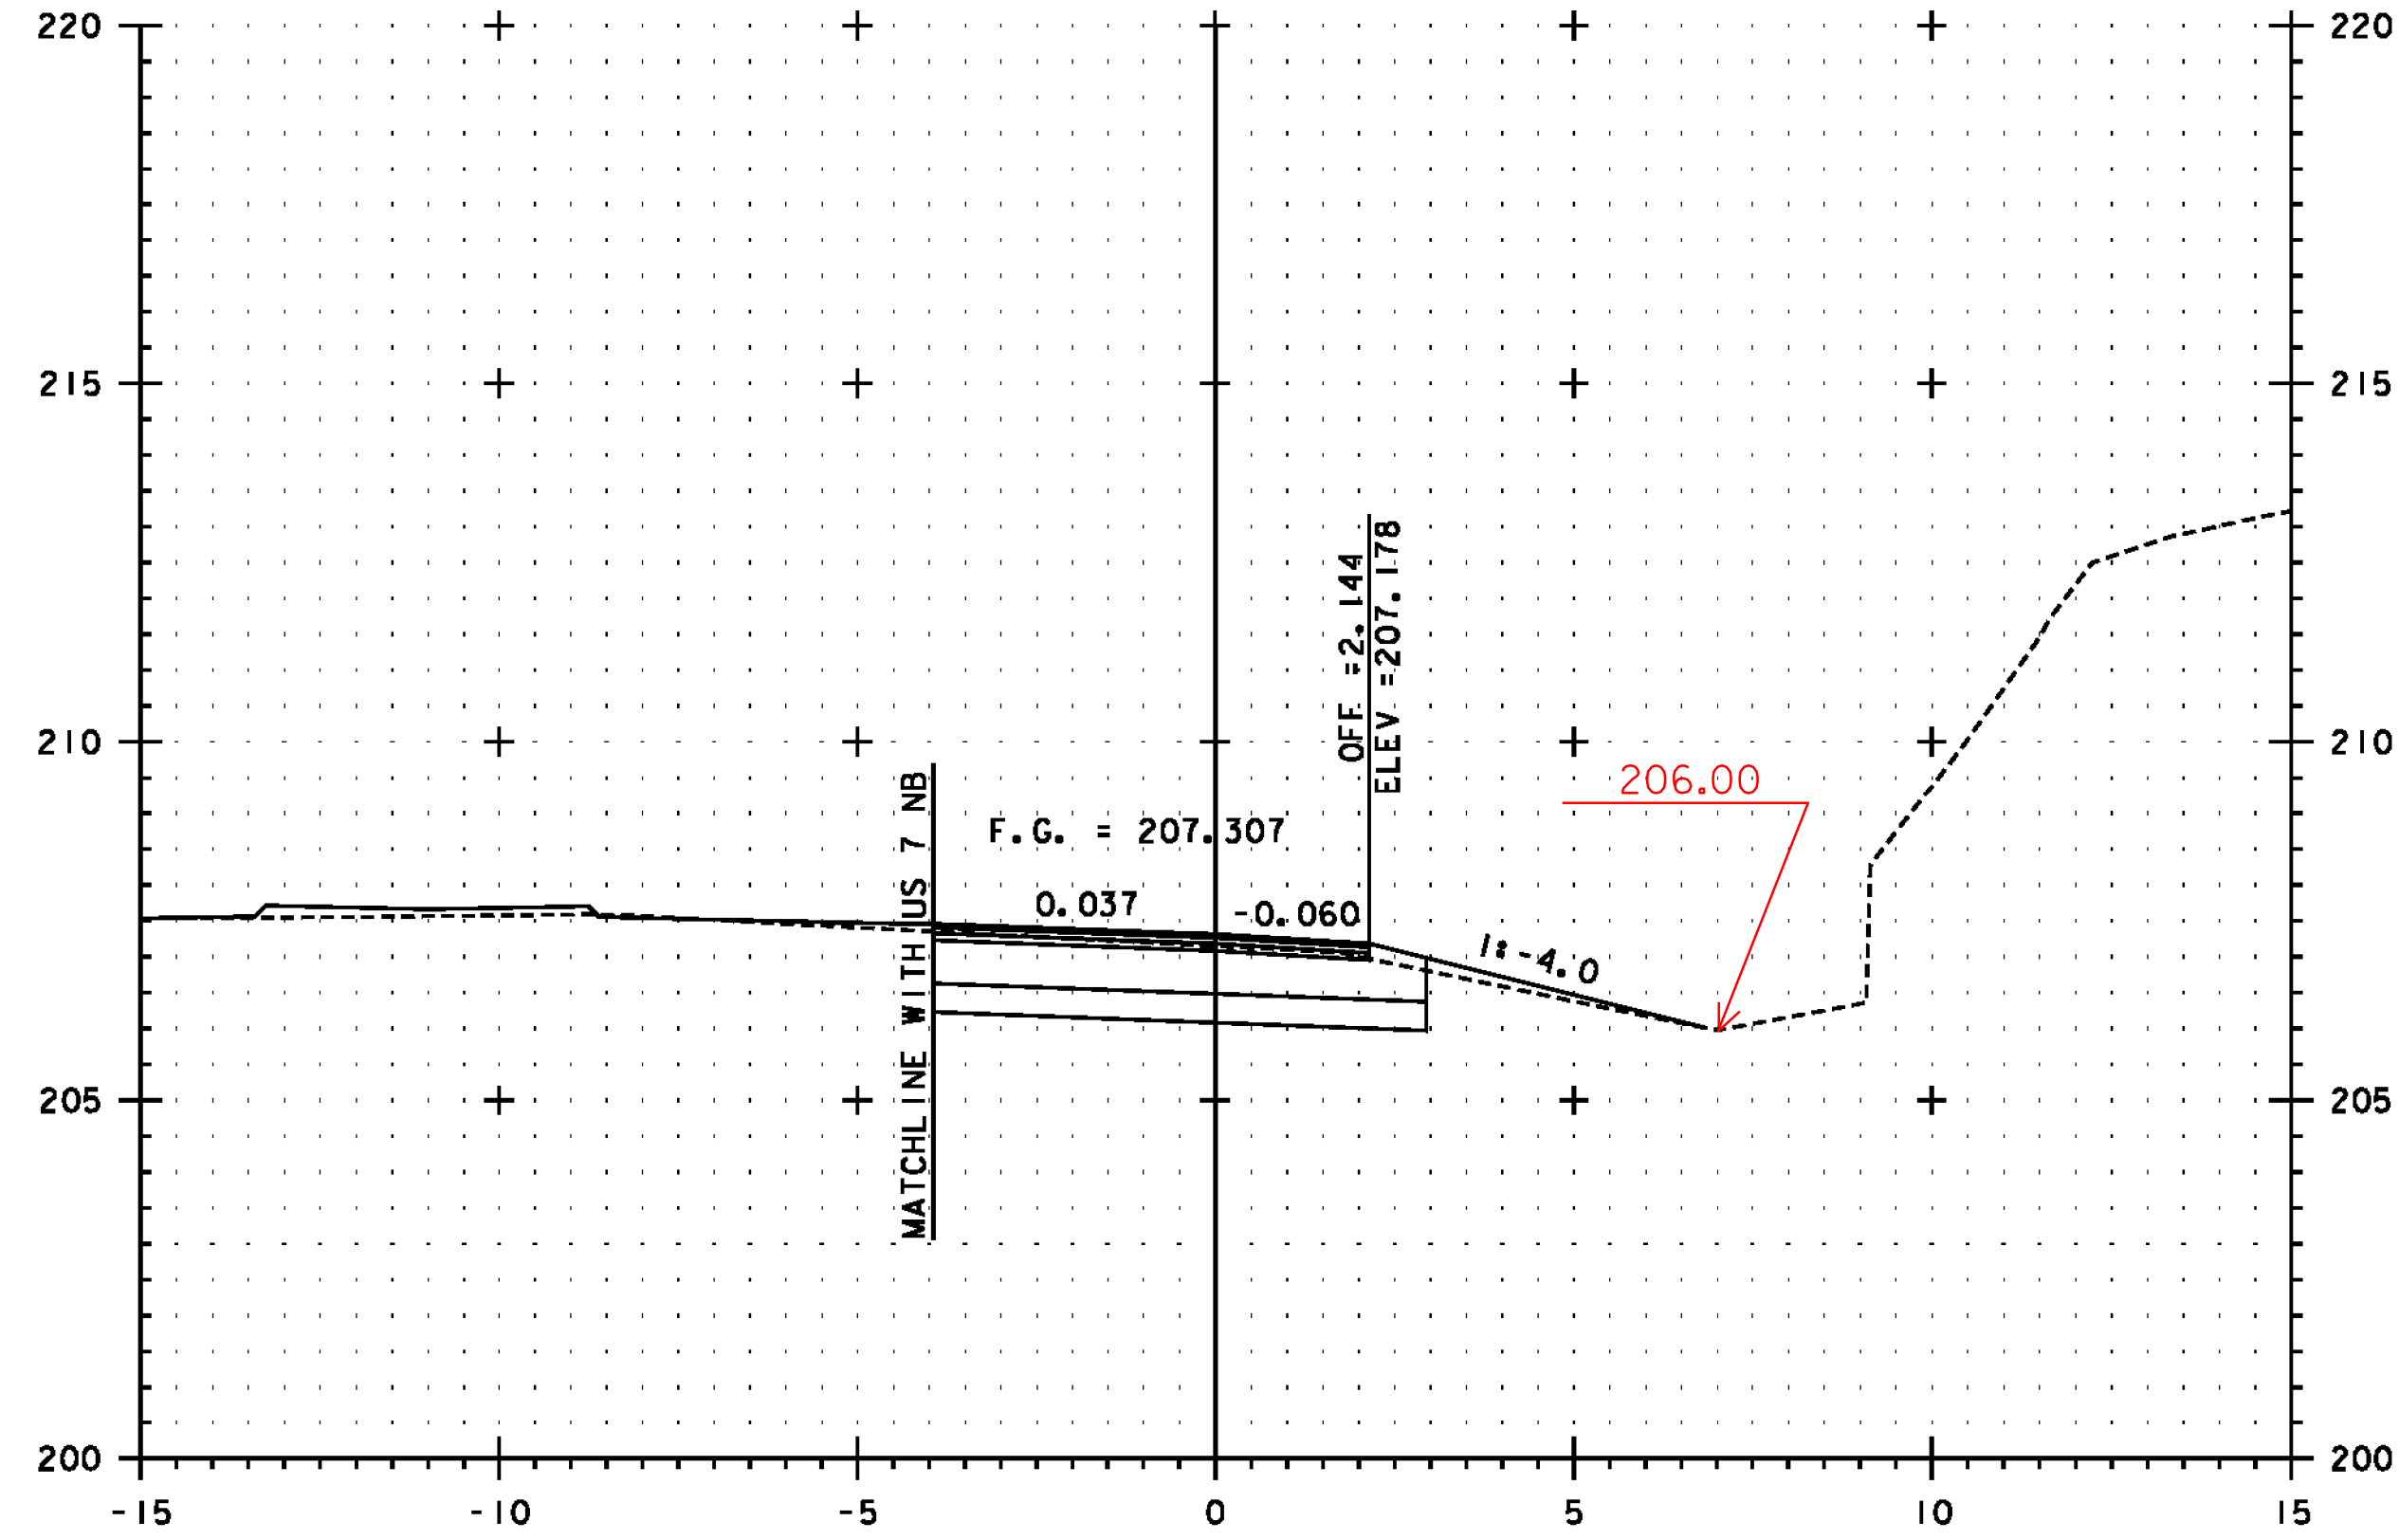


DITCH LINE REVISIONS

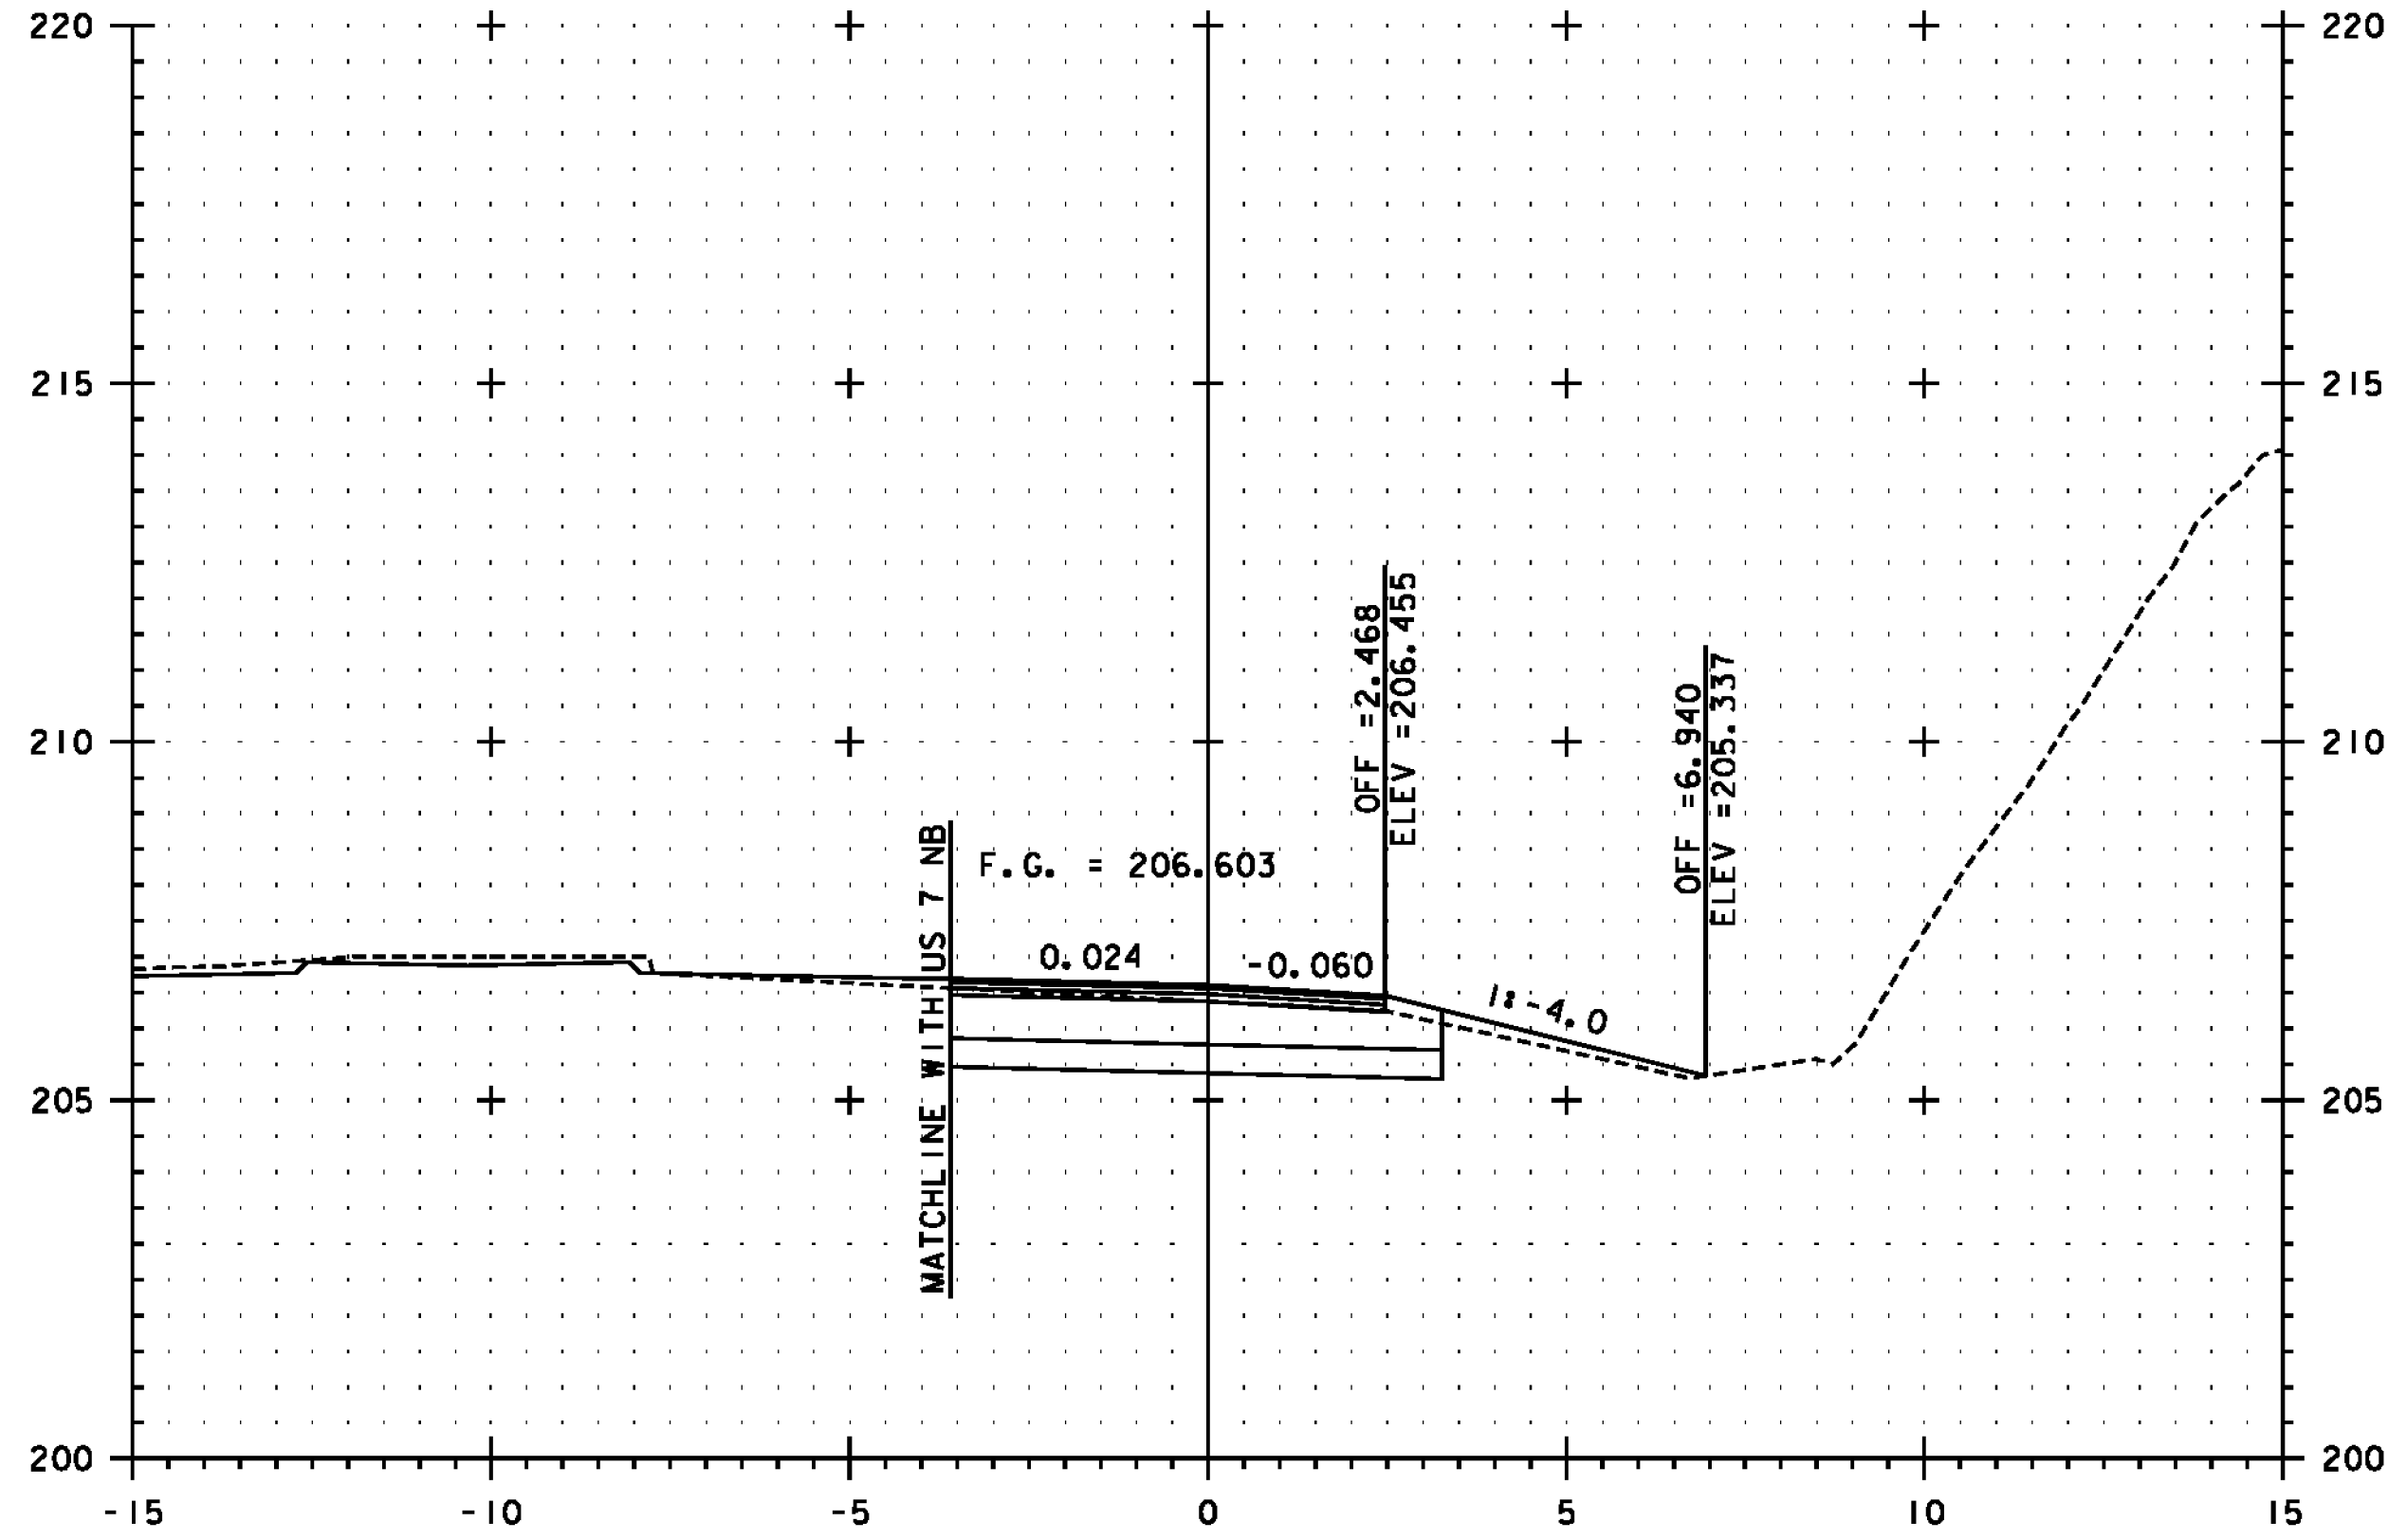

NOTE: FINAL CROSS SECTIONS FOR RAMP L ARE CONTAINED IN THE FINAL COMP BOOKS FOR ITEM 203.15 - COMMON EXCAVATION

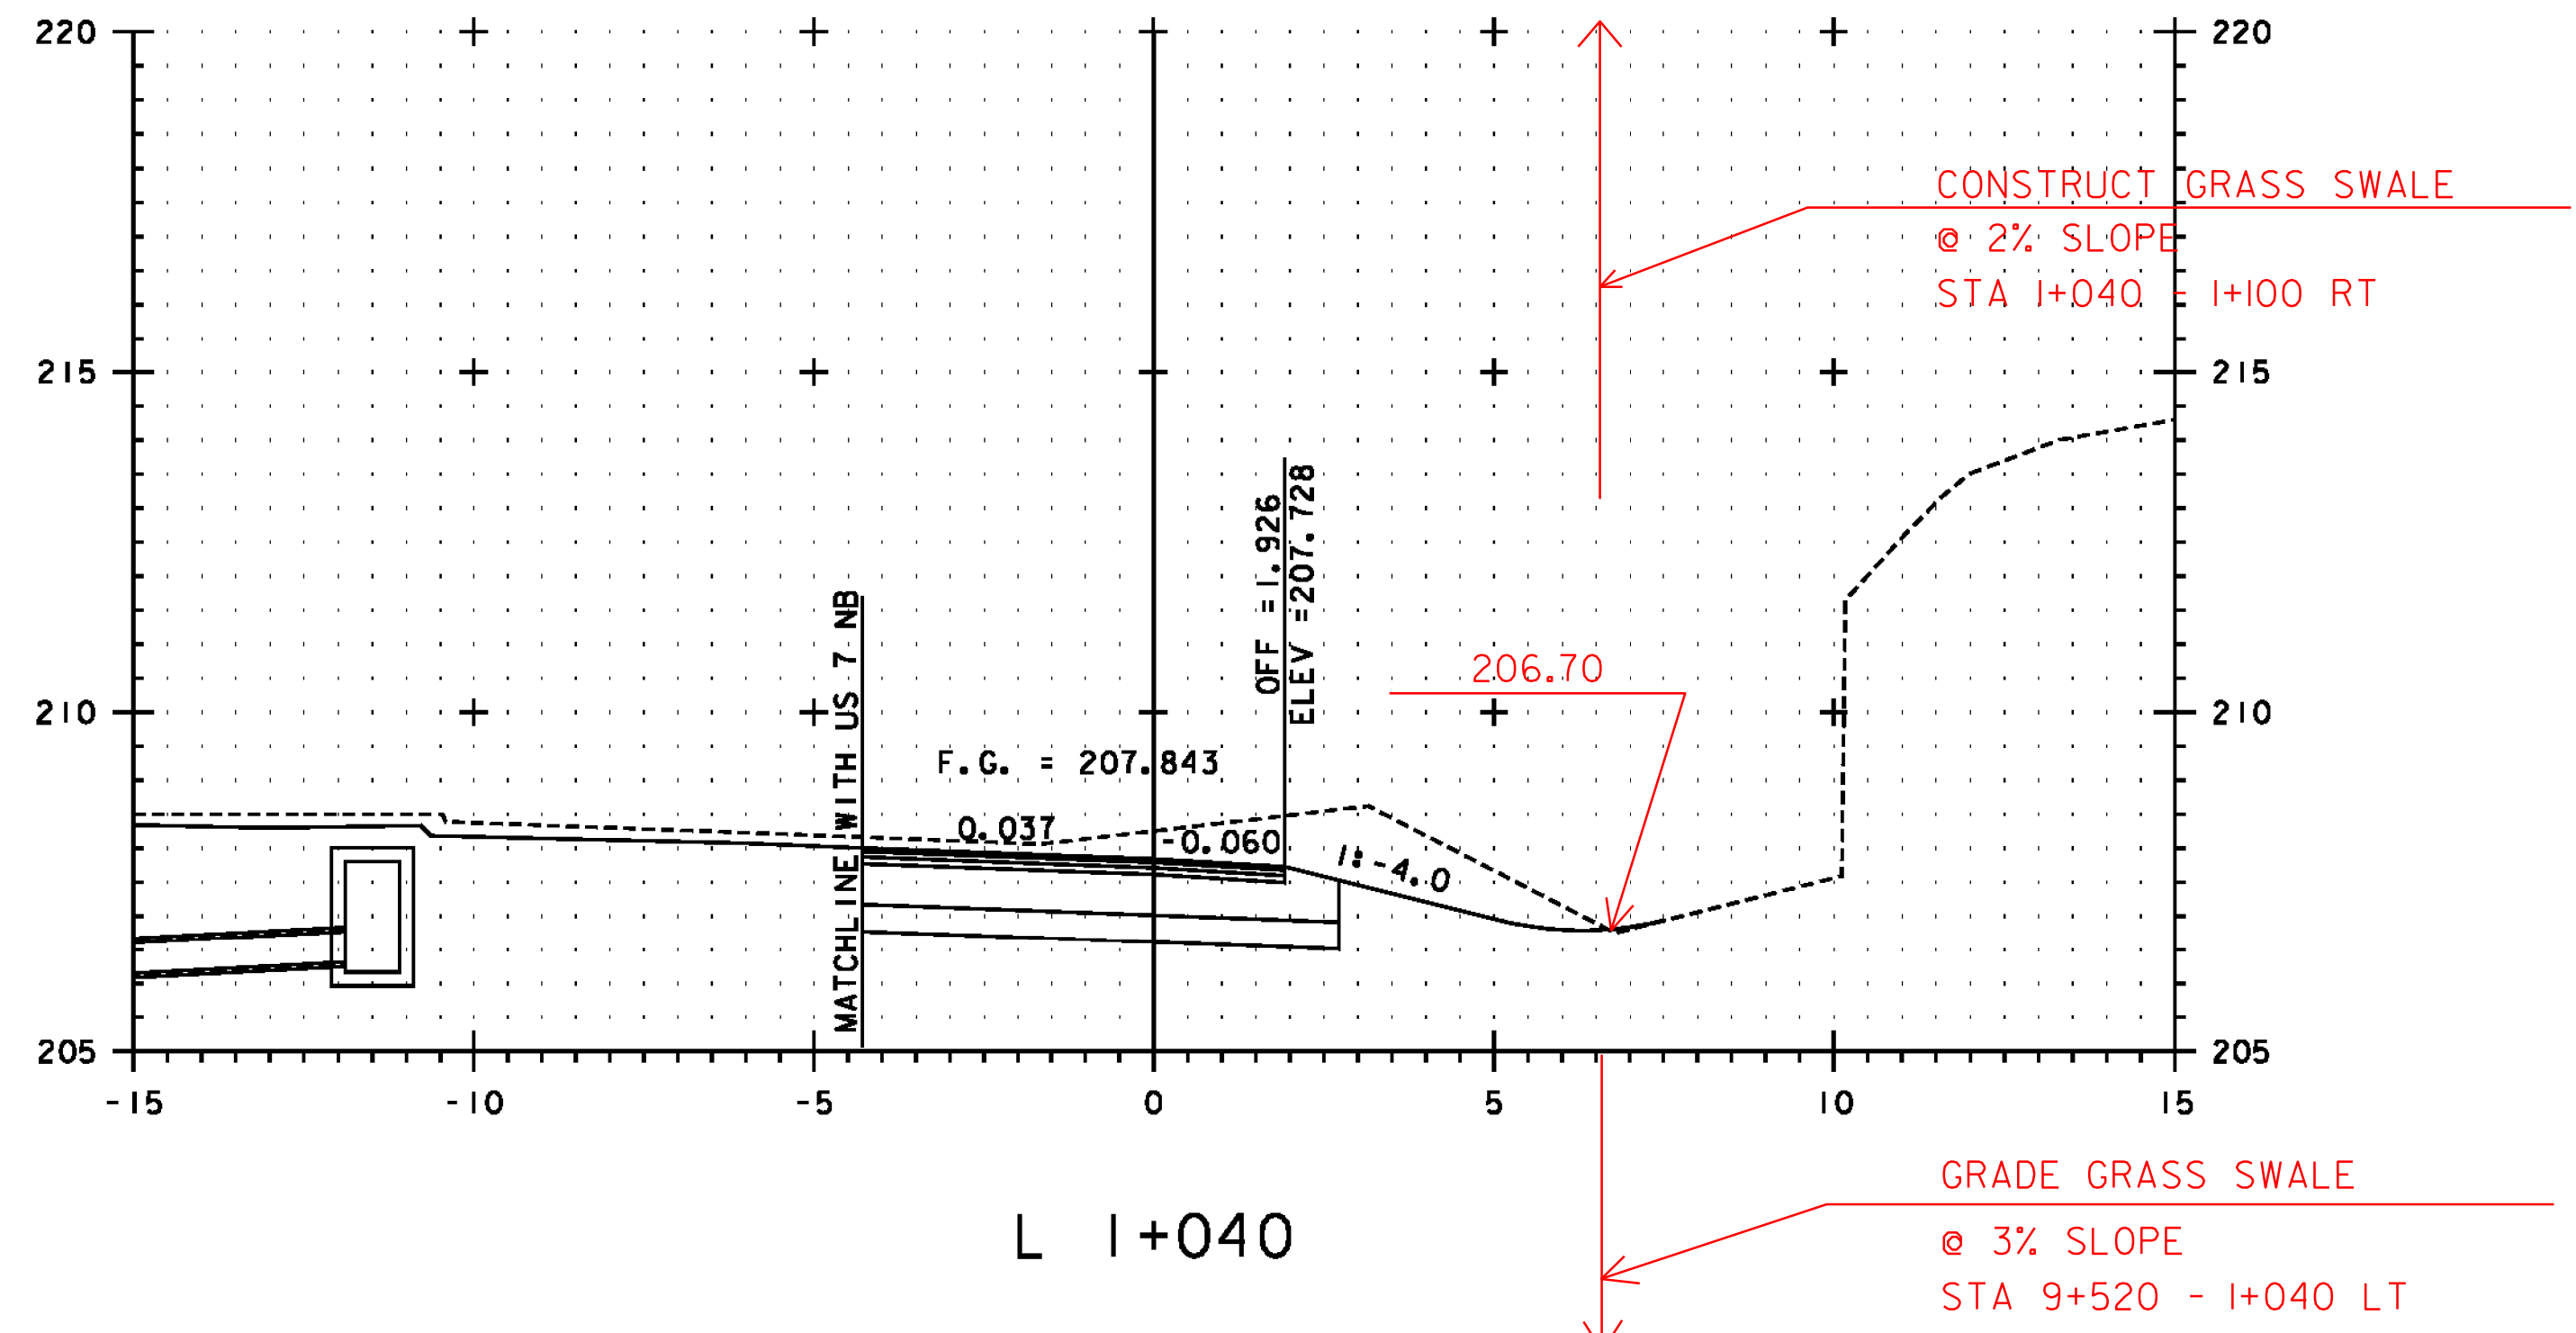

PROJECT NAME:	BENNINGTON
PROJECT NUMBER:	NH 019-(154)
FILE NAME:	...plot_files\zd307c4xs.rampL.pptf
PLOT DATE:	1/26/2010
DESIGN SUPERVISOR:	GREG EDWARDS
DESIGNED BY:	MARC FOISY
DRAWN BY:	STANTEC
CHECKED BY:	GARY SANTY
RAMP L CROSS SECTION	LXS-01
SHEET	388 OF 468

1/26/2010 4:57:25 PM v:\1953\getlive\1953\002\transportation\drw\ng\comp\tr\cp1_4\plot_files\zd307c4xs.rampL.pptf