

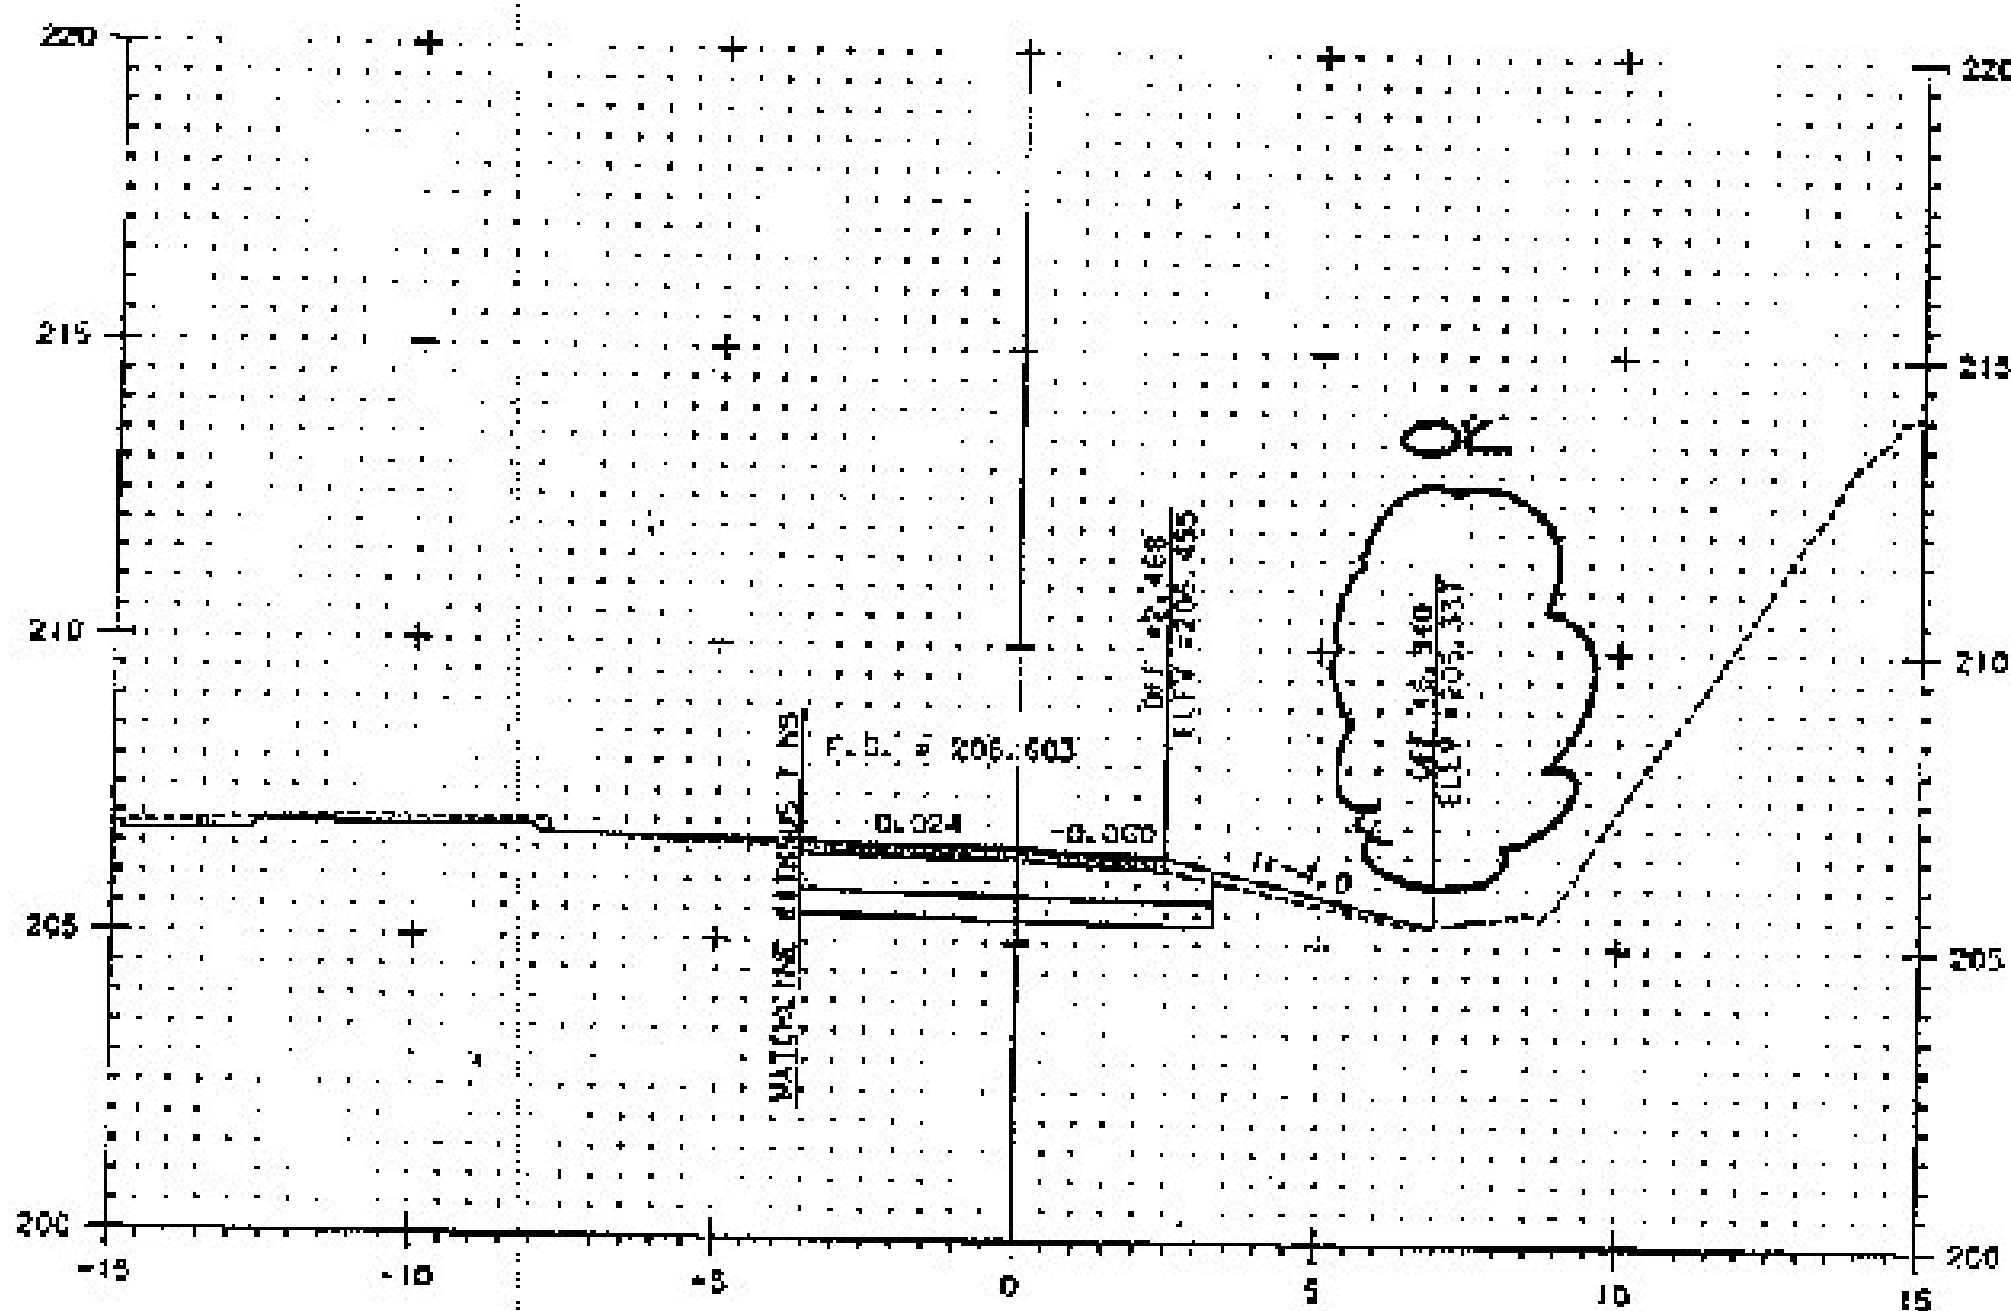



RECORD PLANS  
DITCH LINE REVISIONS

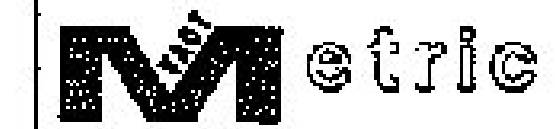


L 1+000.000 = NB 9+566.820, 7.2m RT.

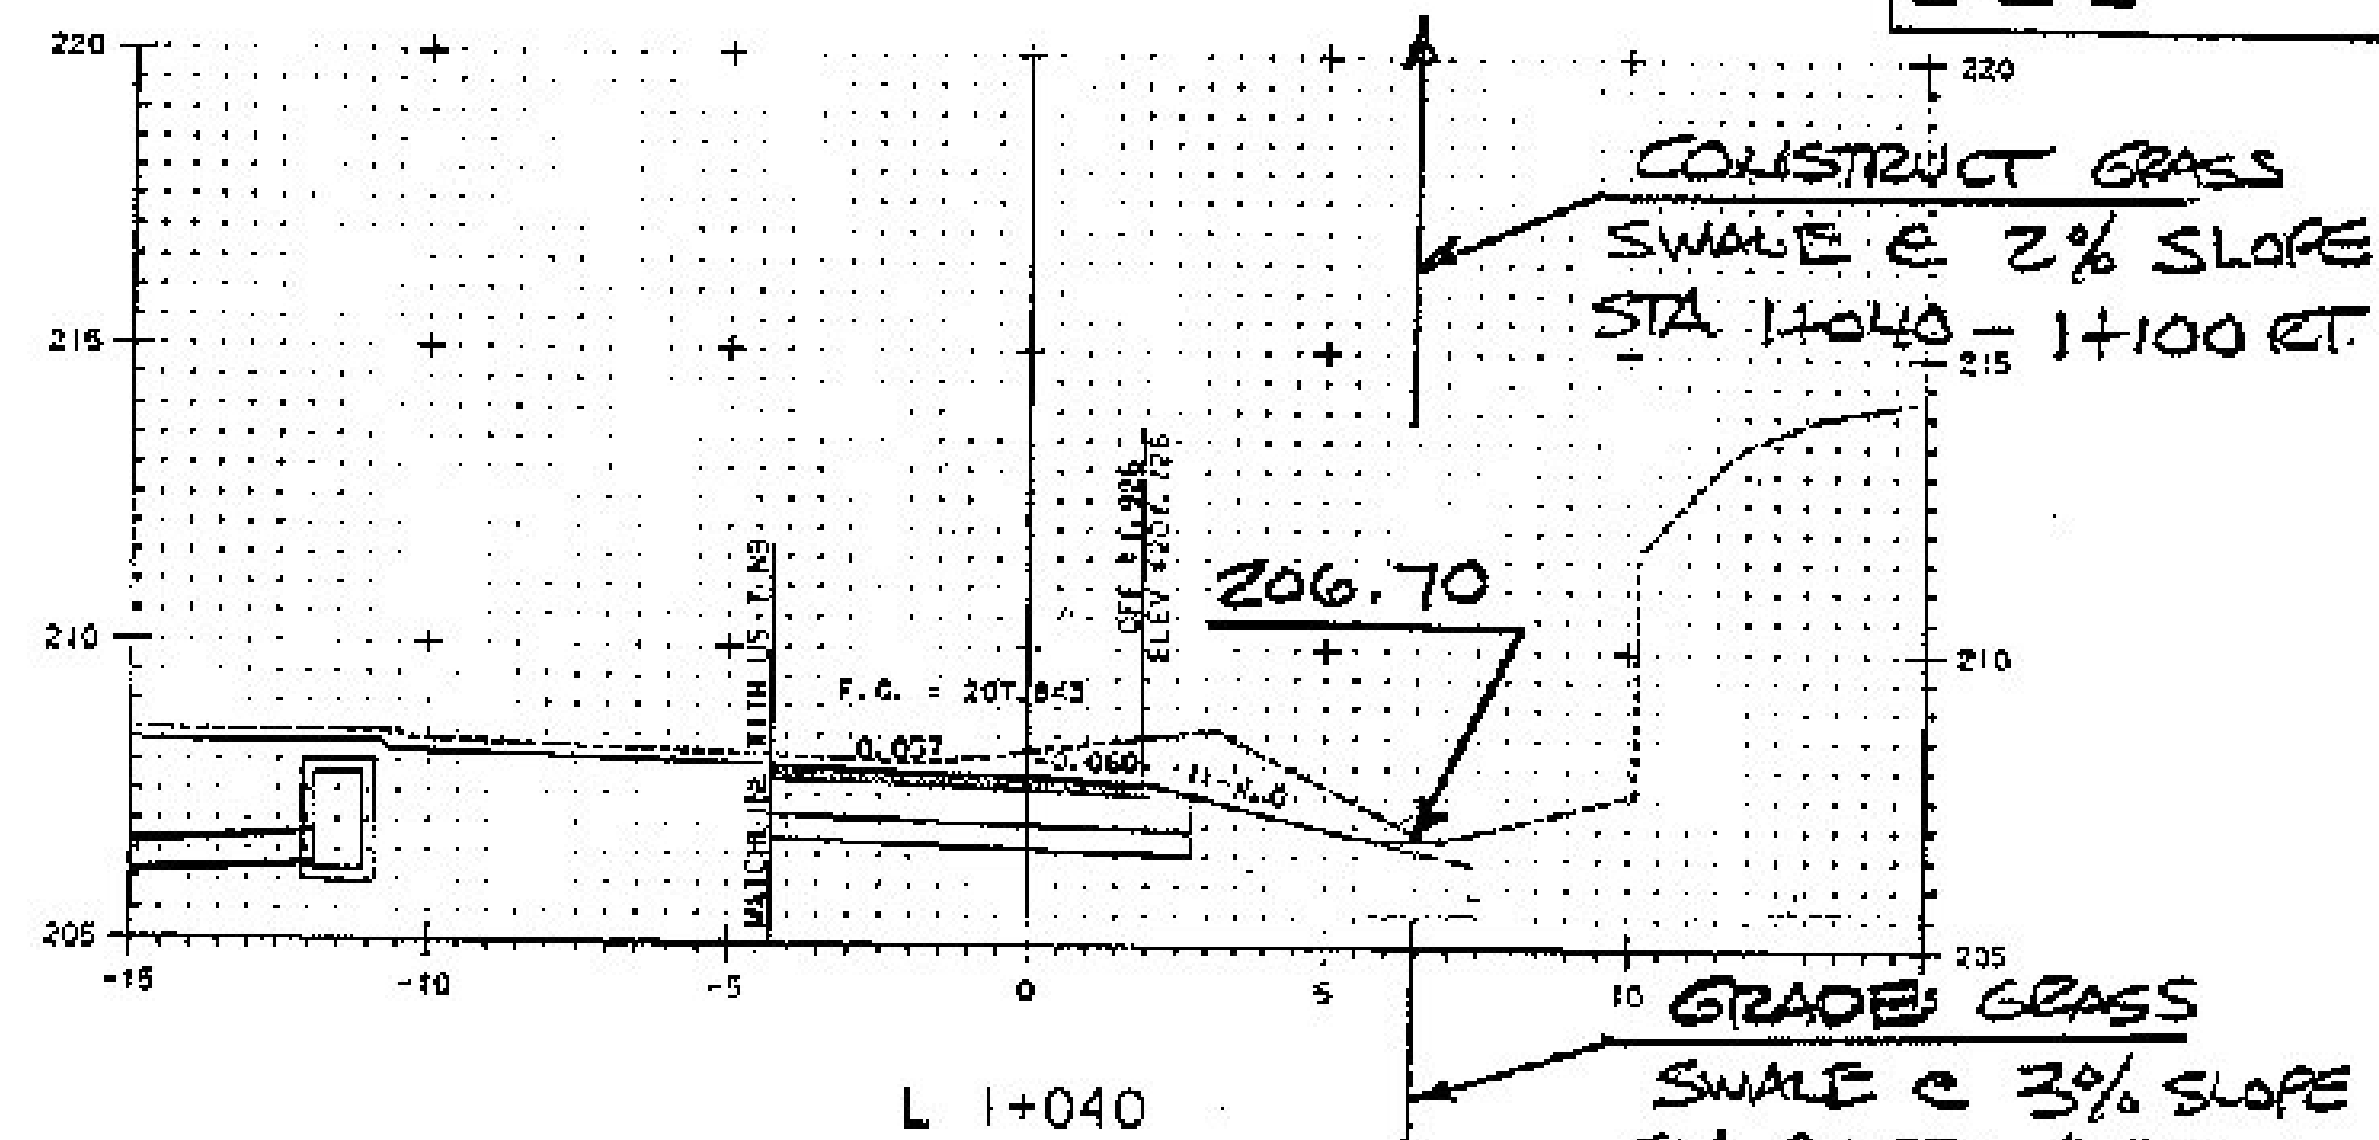

L 1+040

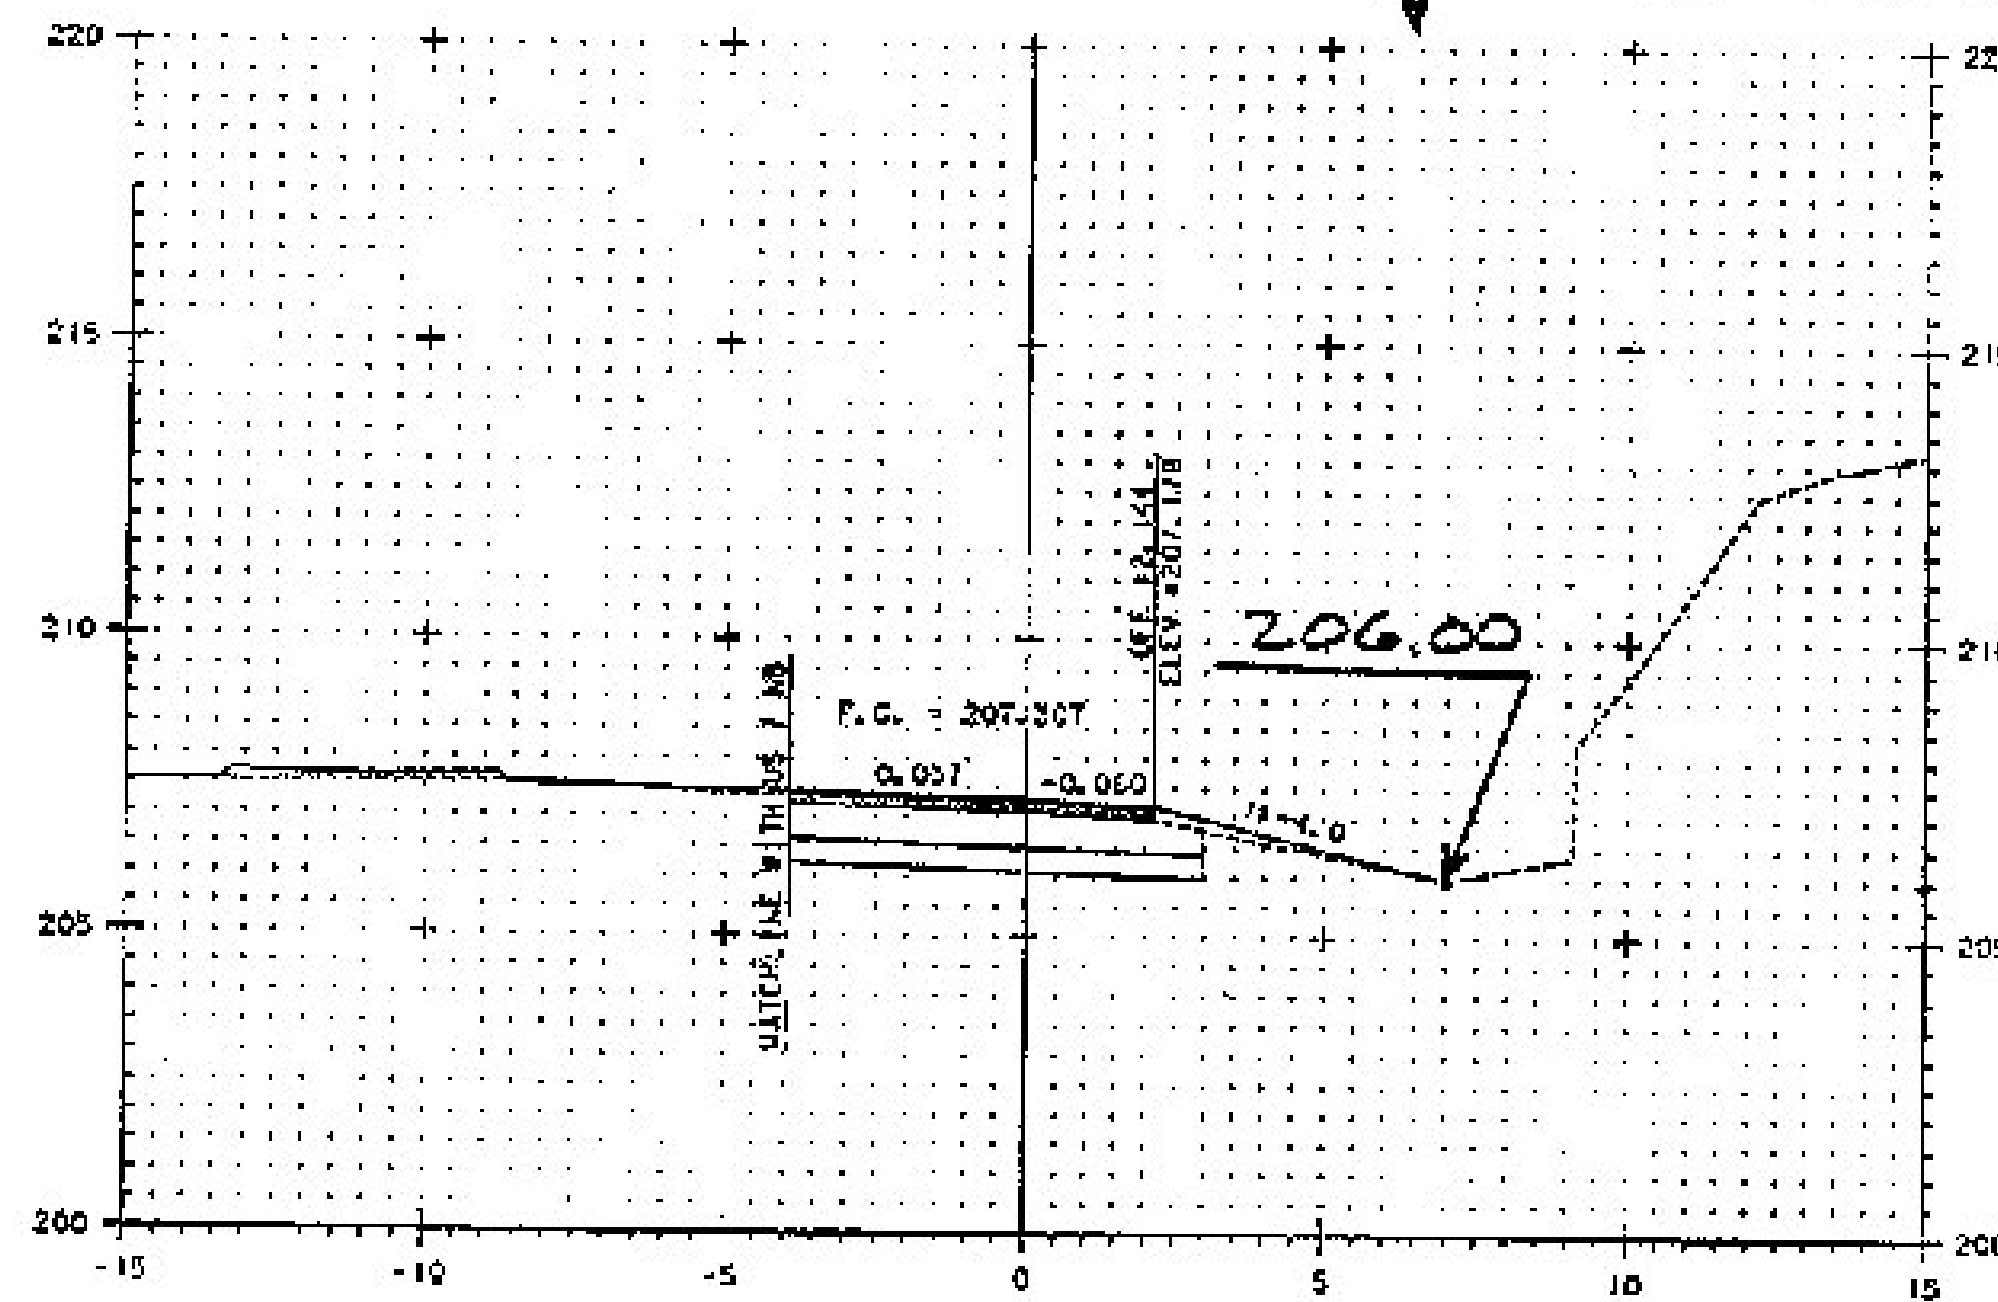

L 1+020

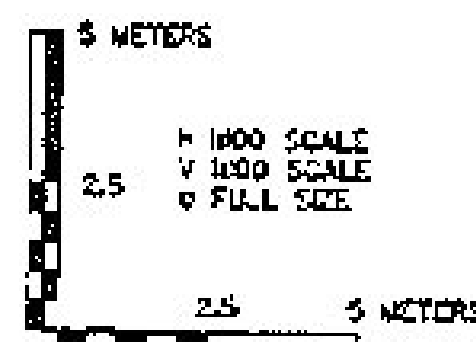

PROJECT NAME: BENNINGTON  
 PROJECT NUMBER: NH 019-(54)  
 FILE NAME: \\ndot...  
 DESIGN SUPERVISOR: ORED EDWARDS  
 DESIGNED BY: MARC FORSY  
 PLOT DATE: 1/26/2010  
 DRAWN BY: STANLEY  
 CHECKED BY: GARY SMYTH