




L 1+340

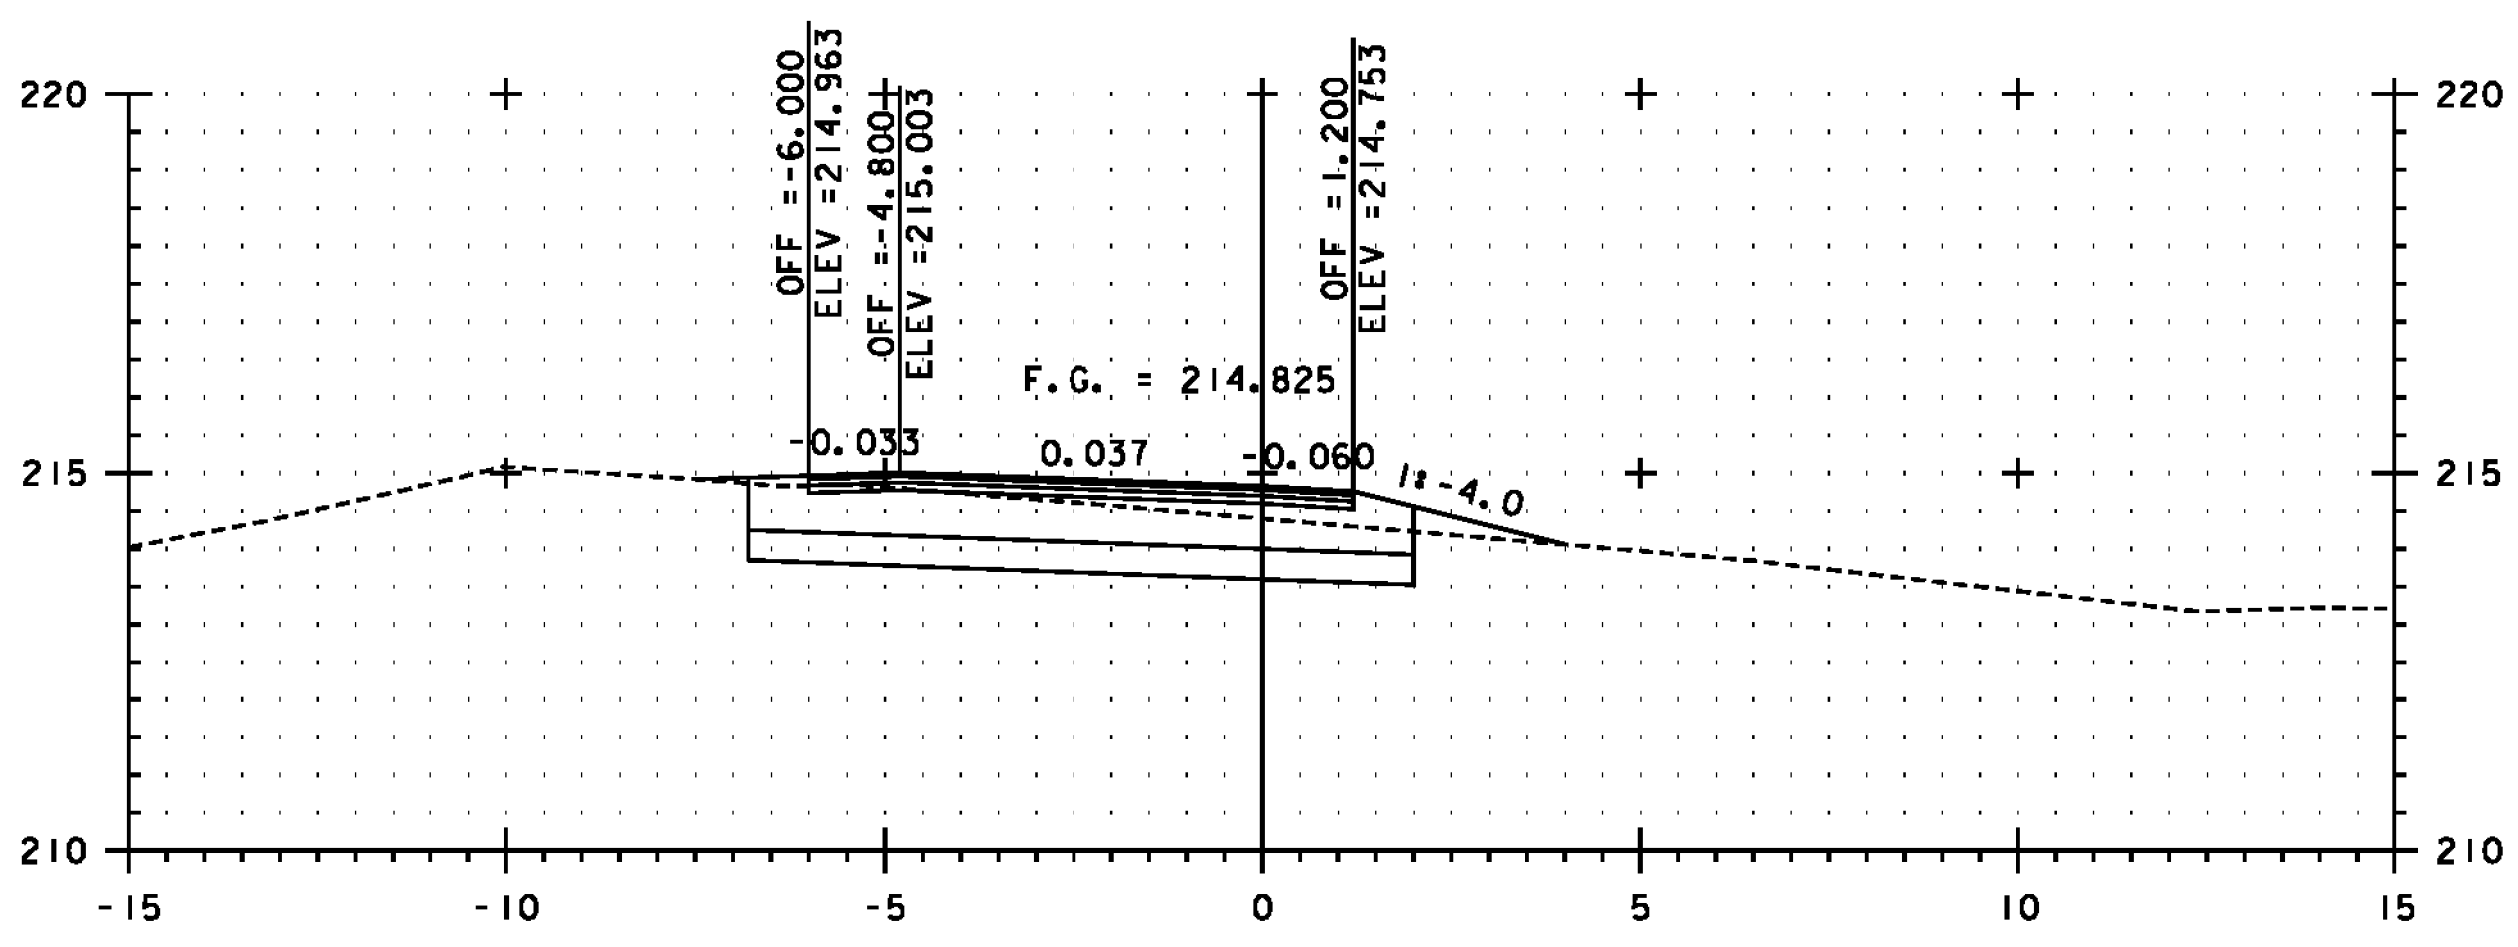


L 1+320

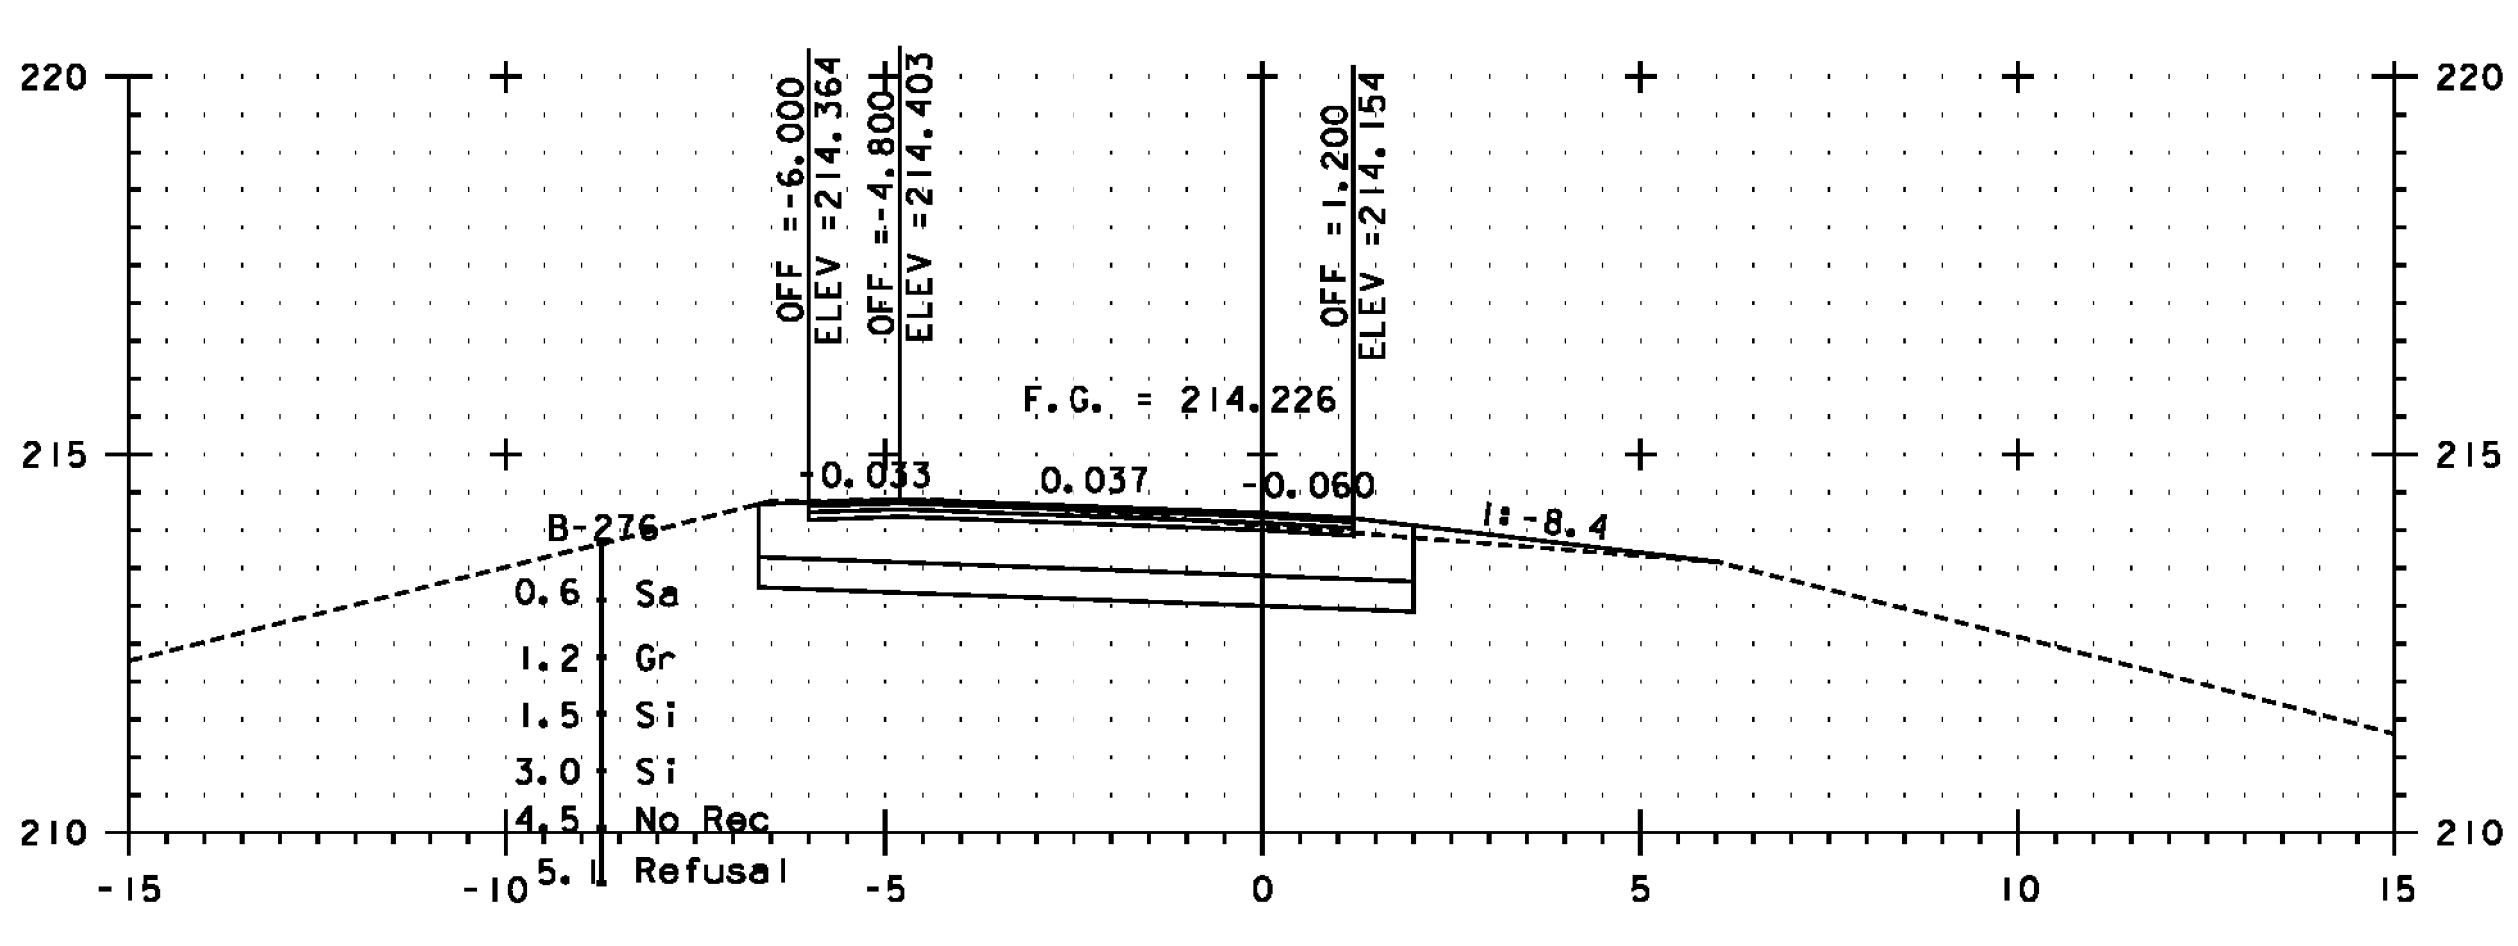

L 1+300

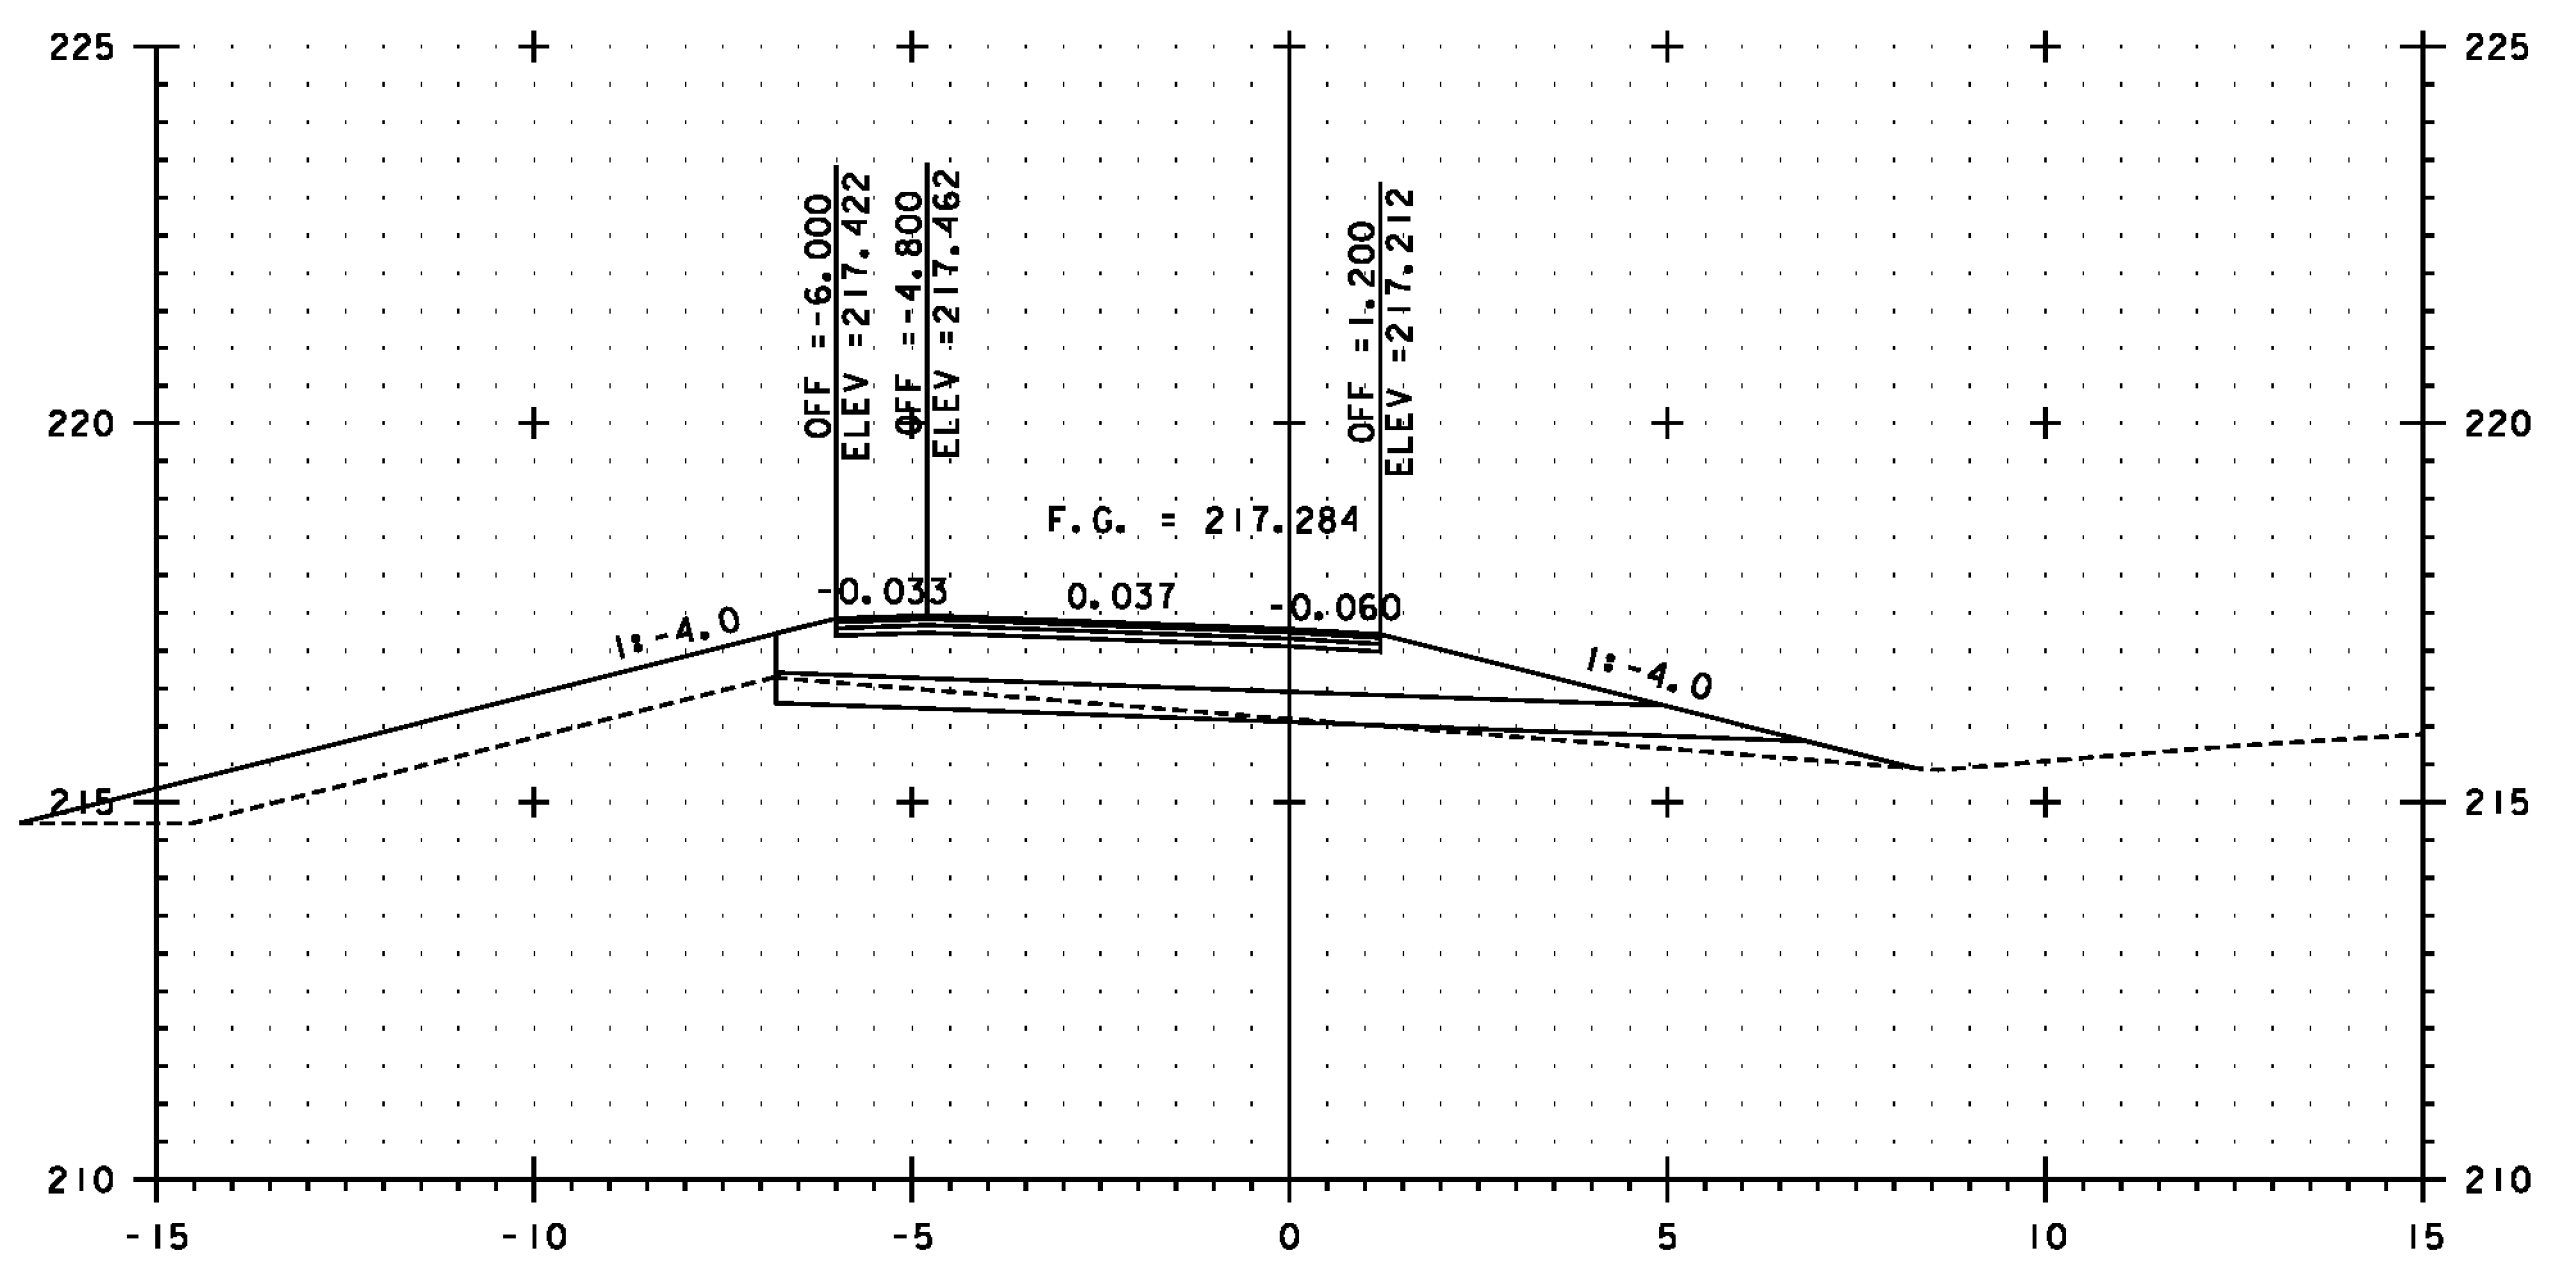


L 1+380

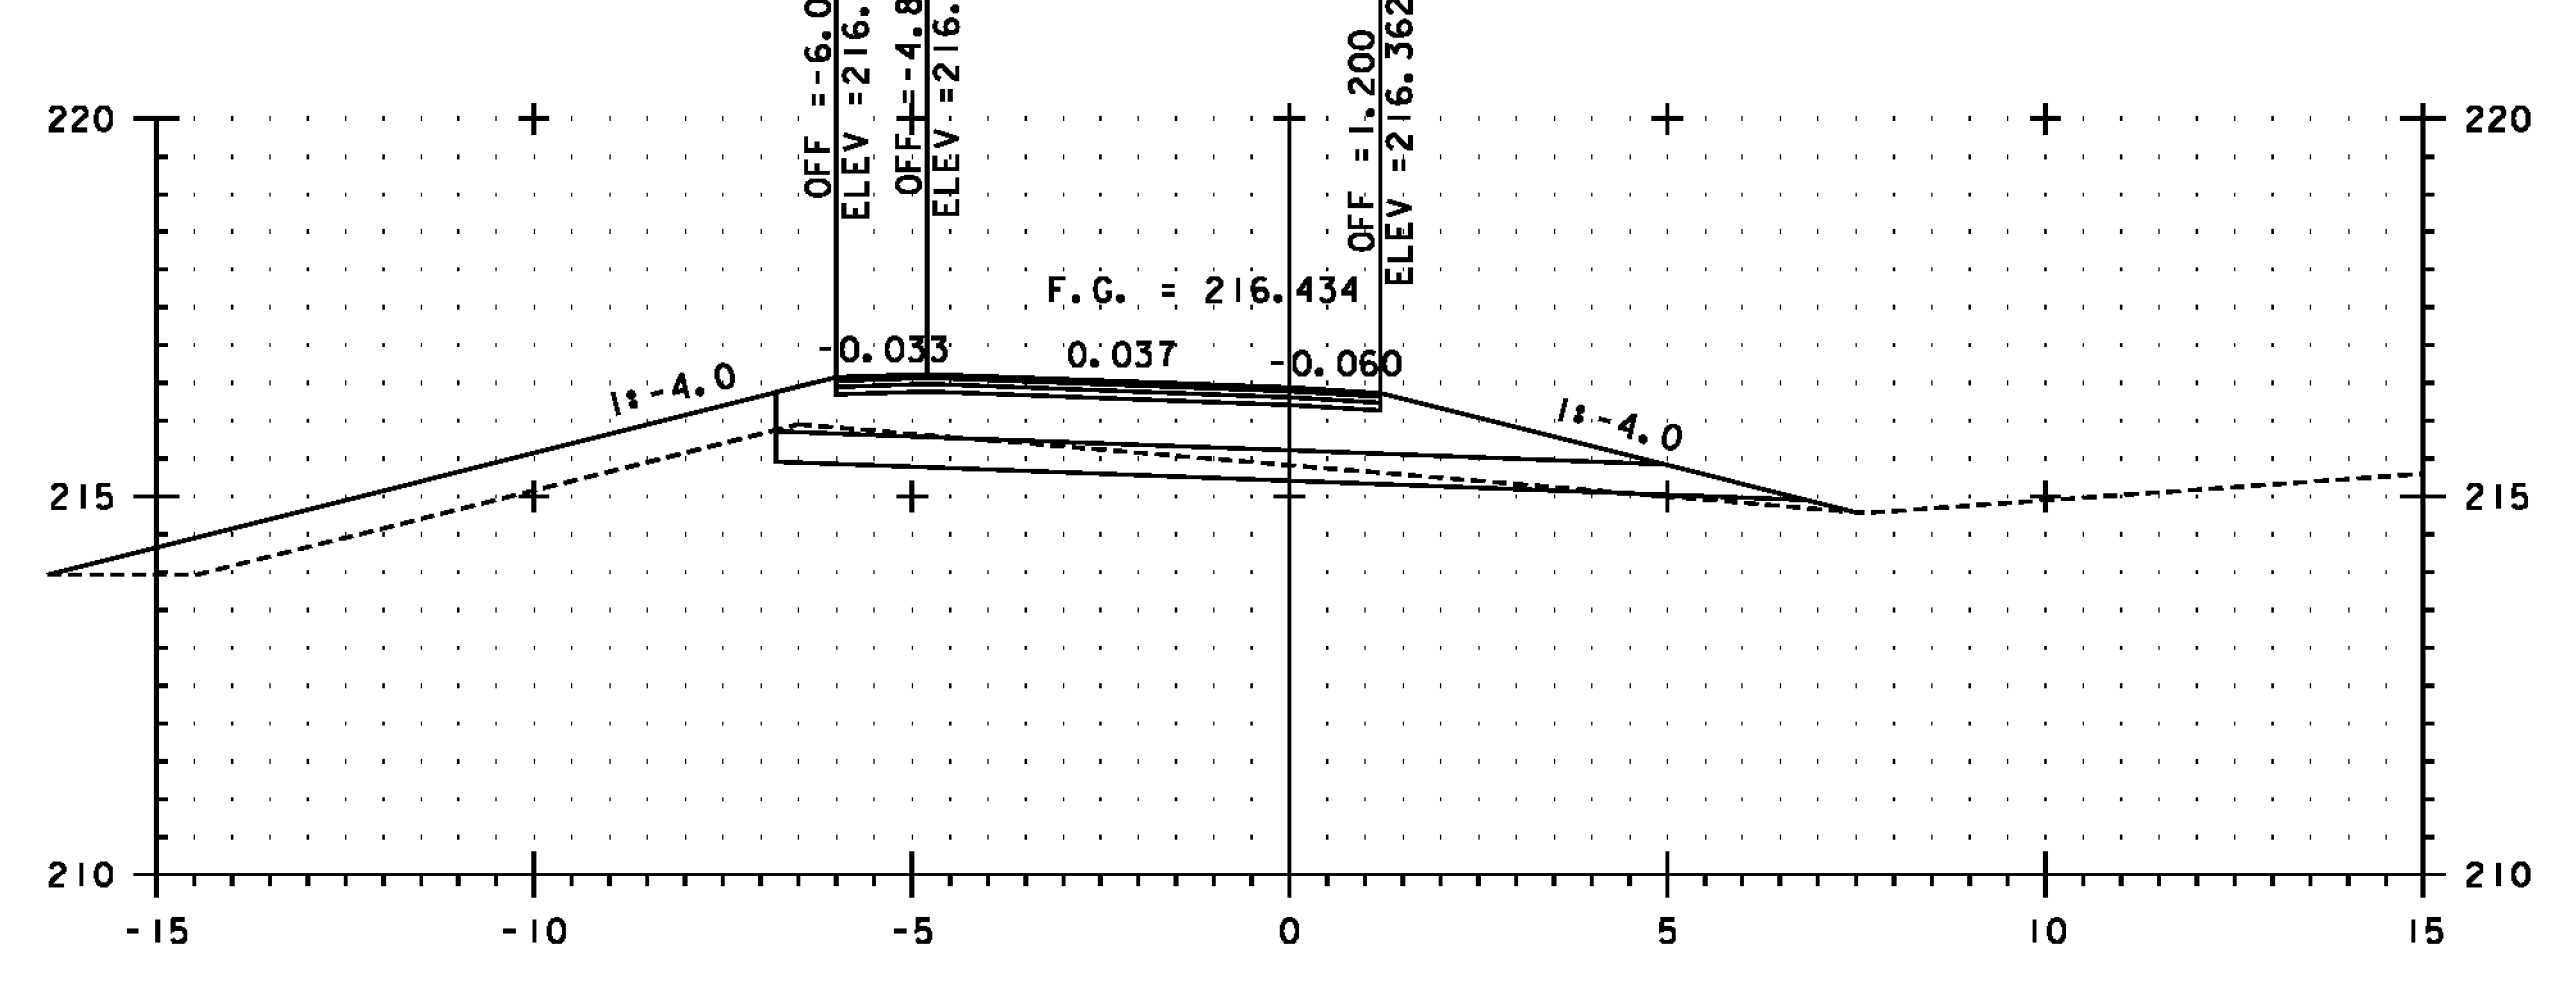

L 1+360

SEE NOTE ON SHEET 382

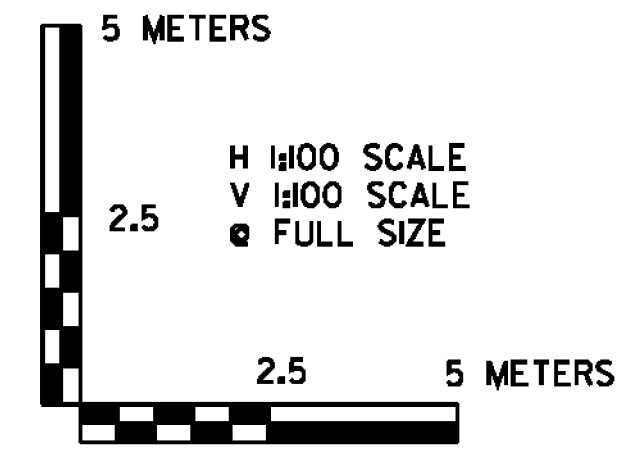

PROJECT NAME:	BENNINGTON
PROJECT NUMBER:	NH 019-(54)
FILE NAME:	...plot_files\zd307c4xs.rampL.ptf
PLOT DATE:	1/26/2010
DESIGN SUPERVISOR:	GREG EDWARDS
DRAWN BY:	STANTEC
DESIGNED BY:	MARC FOISY
CHECKED BY:	GARY SANTY
RAMP L CROSS SECTION	LXS-05
SHEET	392 OF 468

1/26/2010 4:57:30 PM v:\1953\getlive\19530002\transport\ref1on\dr\dwg\comp\tr\ref1\_4\plot\_files\zd307c4xs.rampL.ptf