




L 1+440

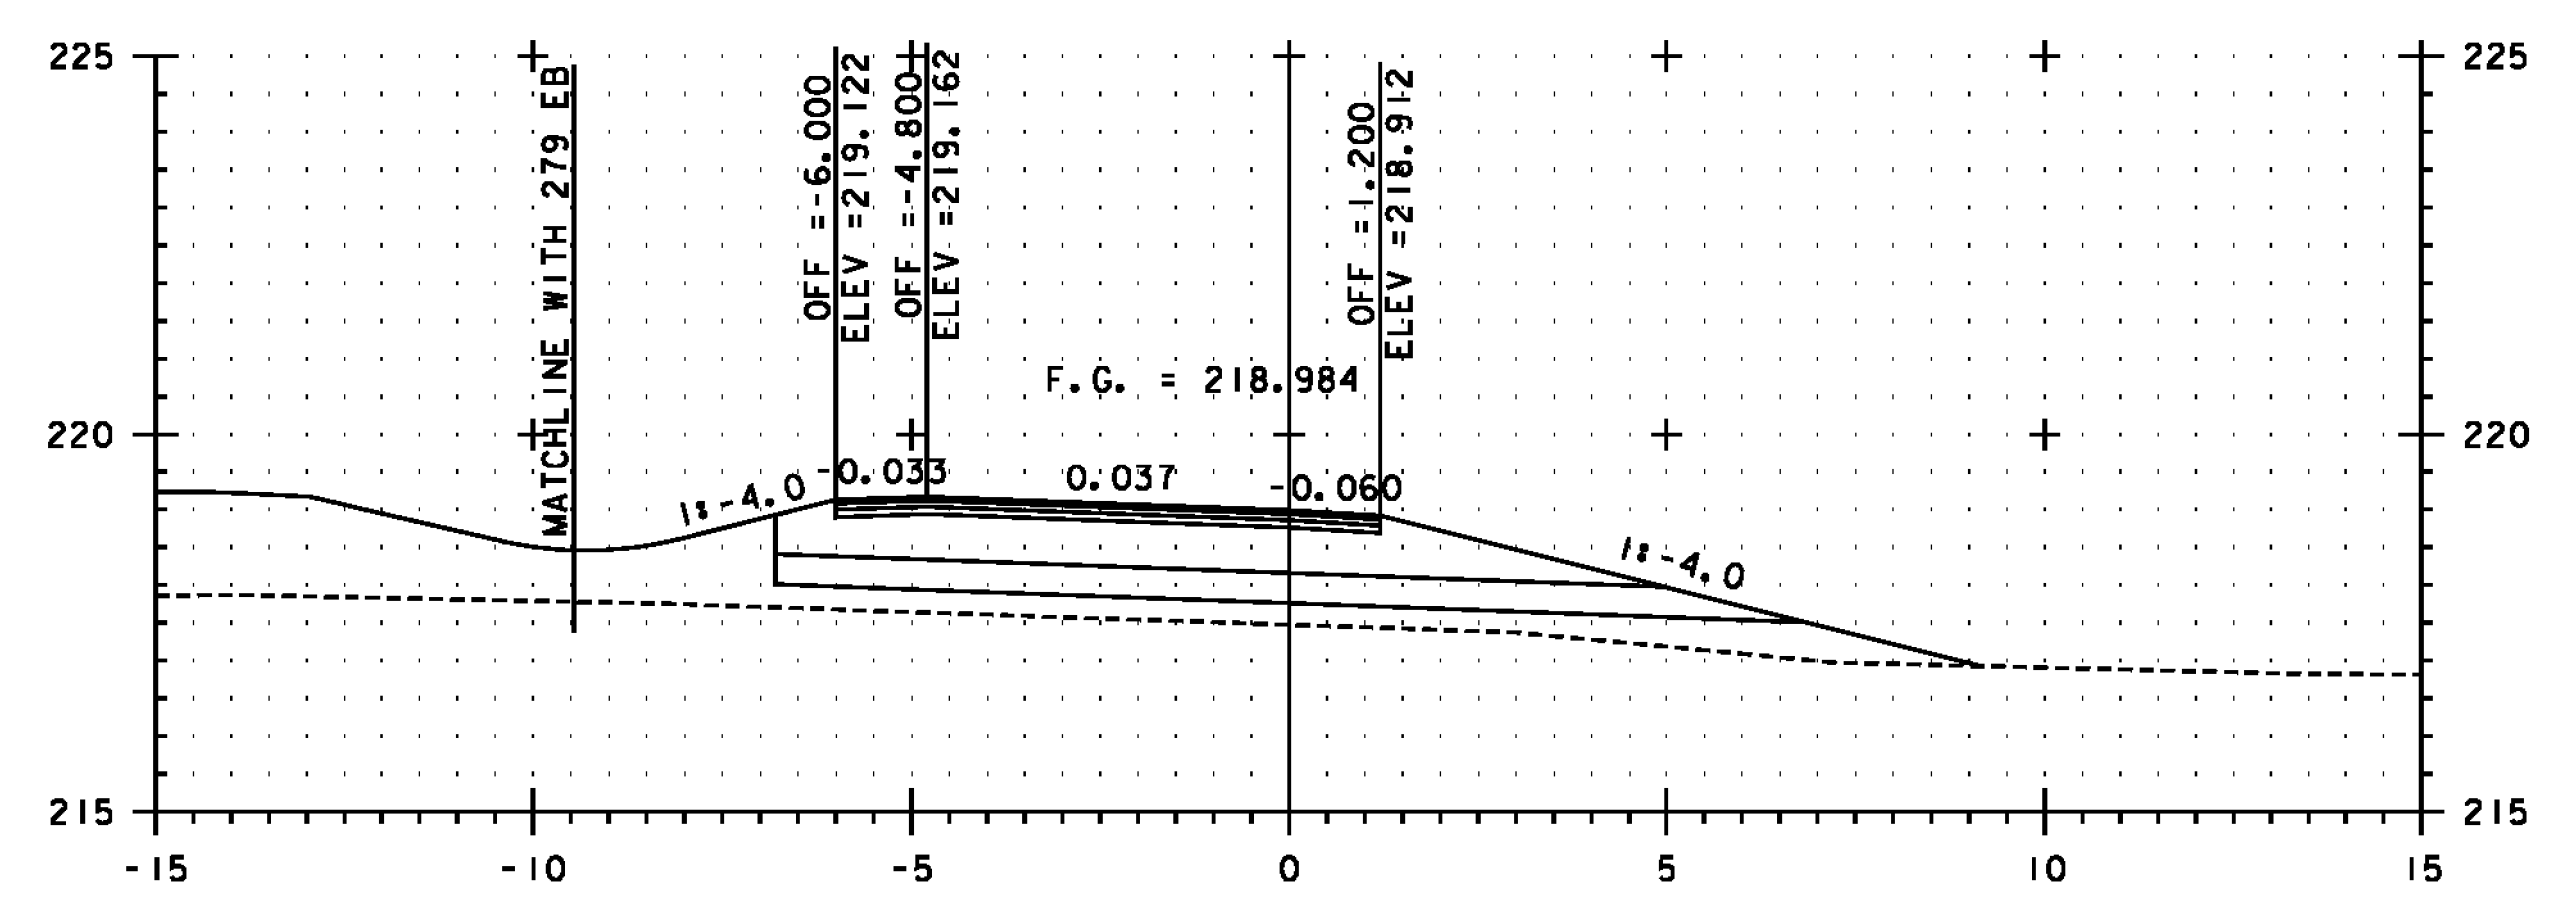


L 1+420

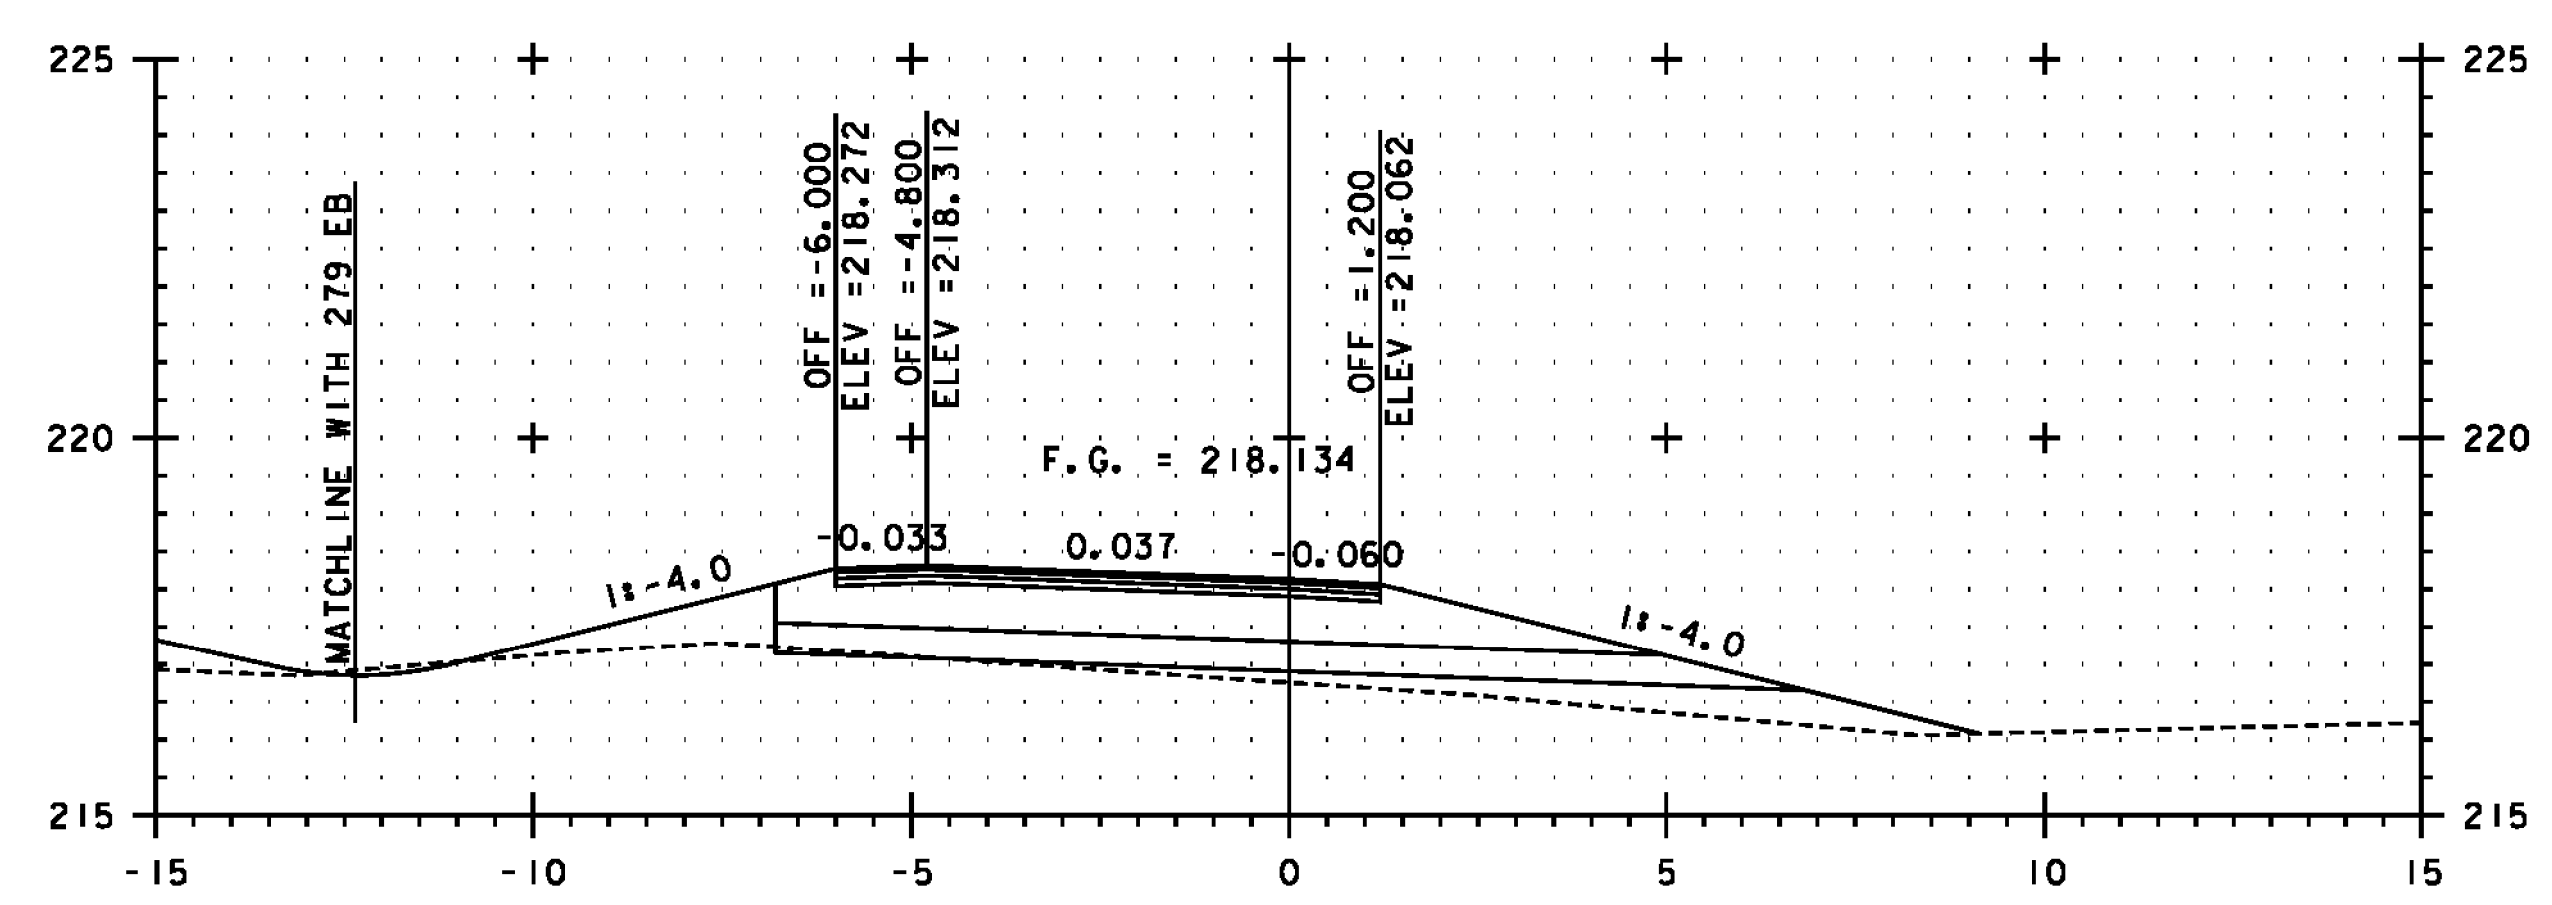

L 1+400

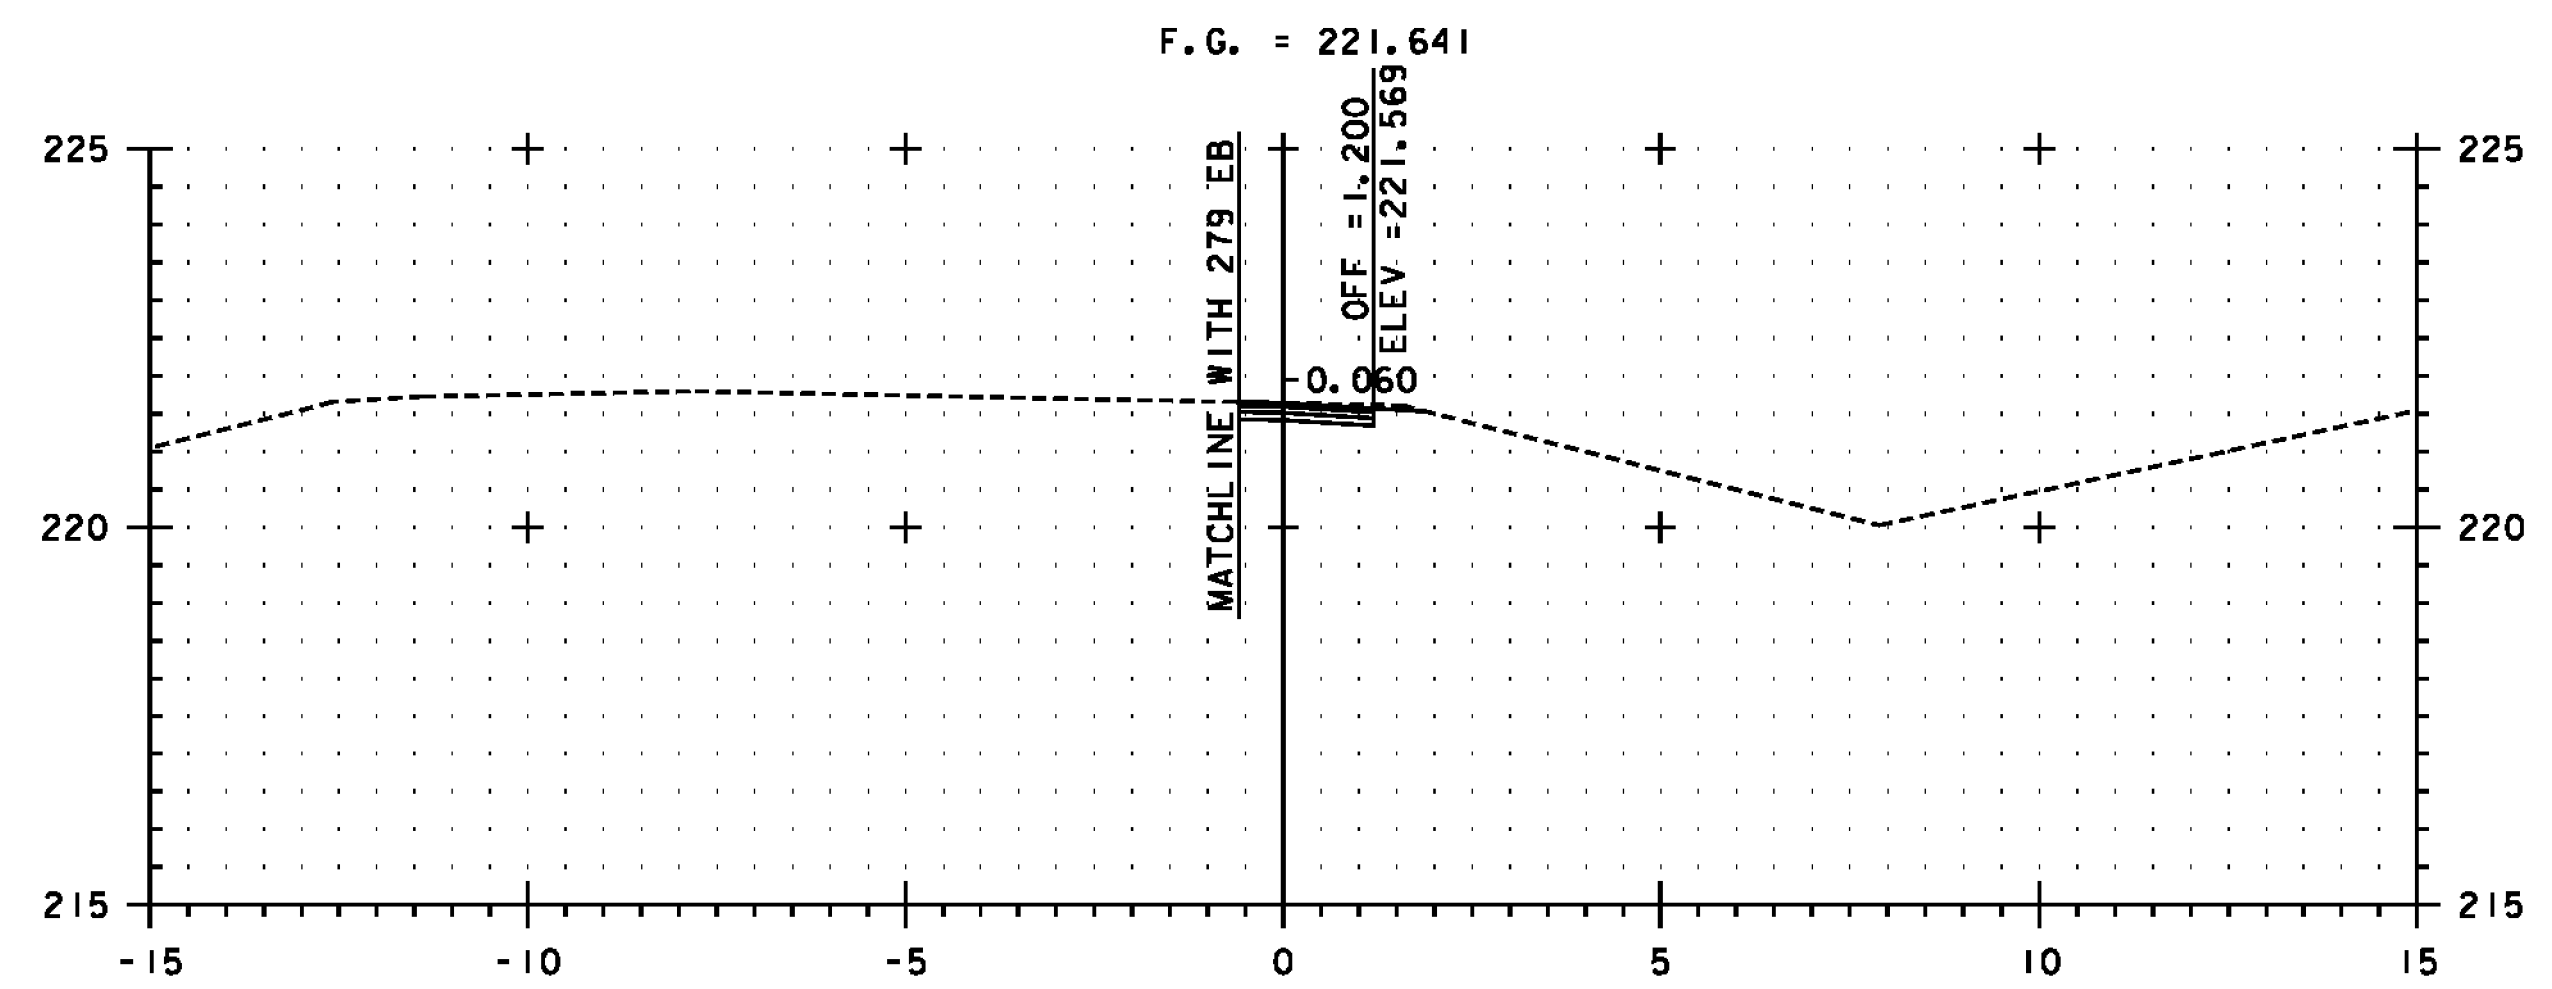


L 1+480

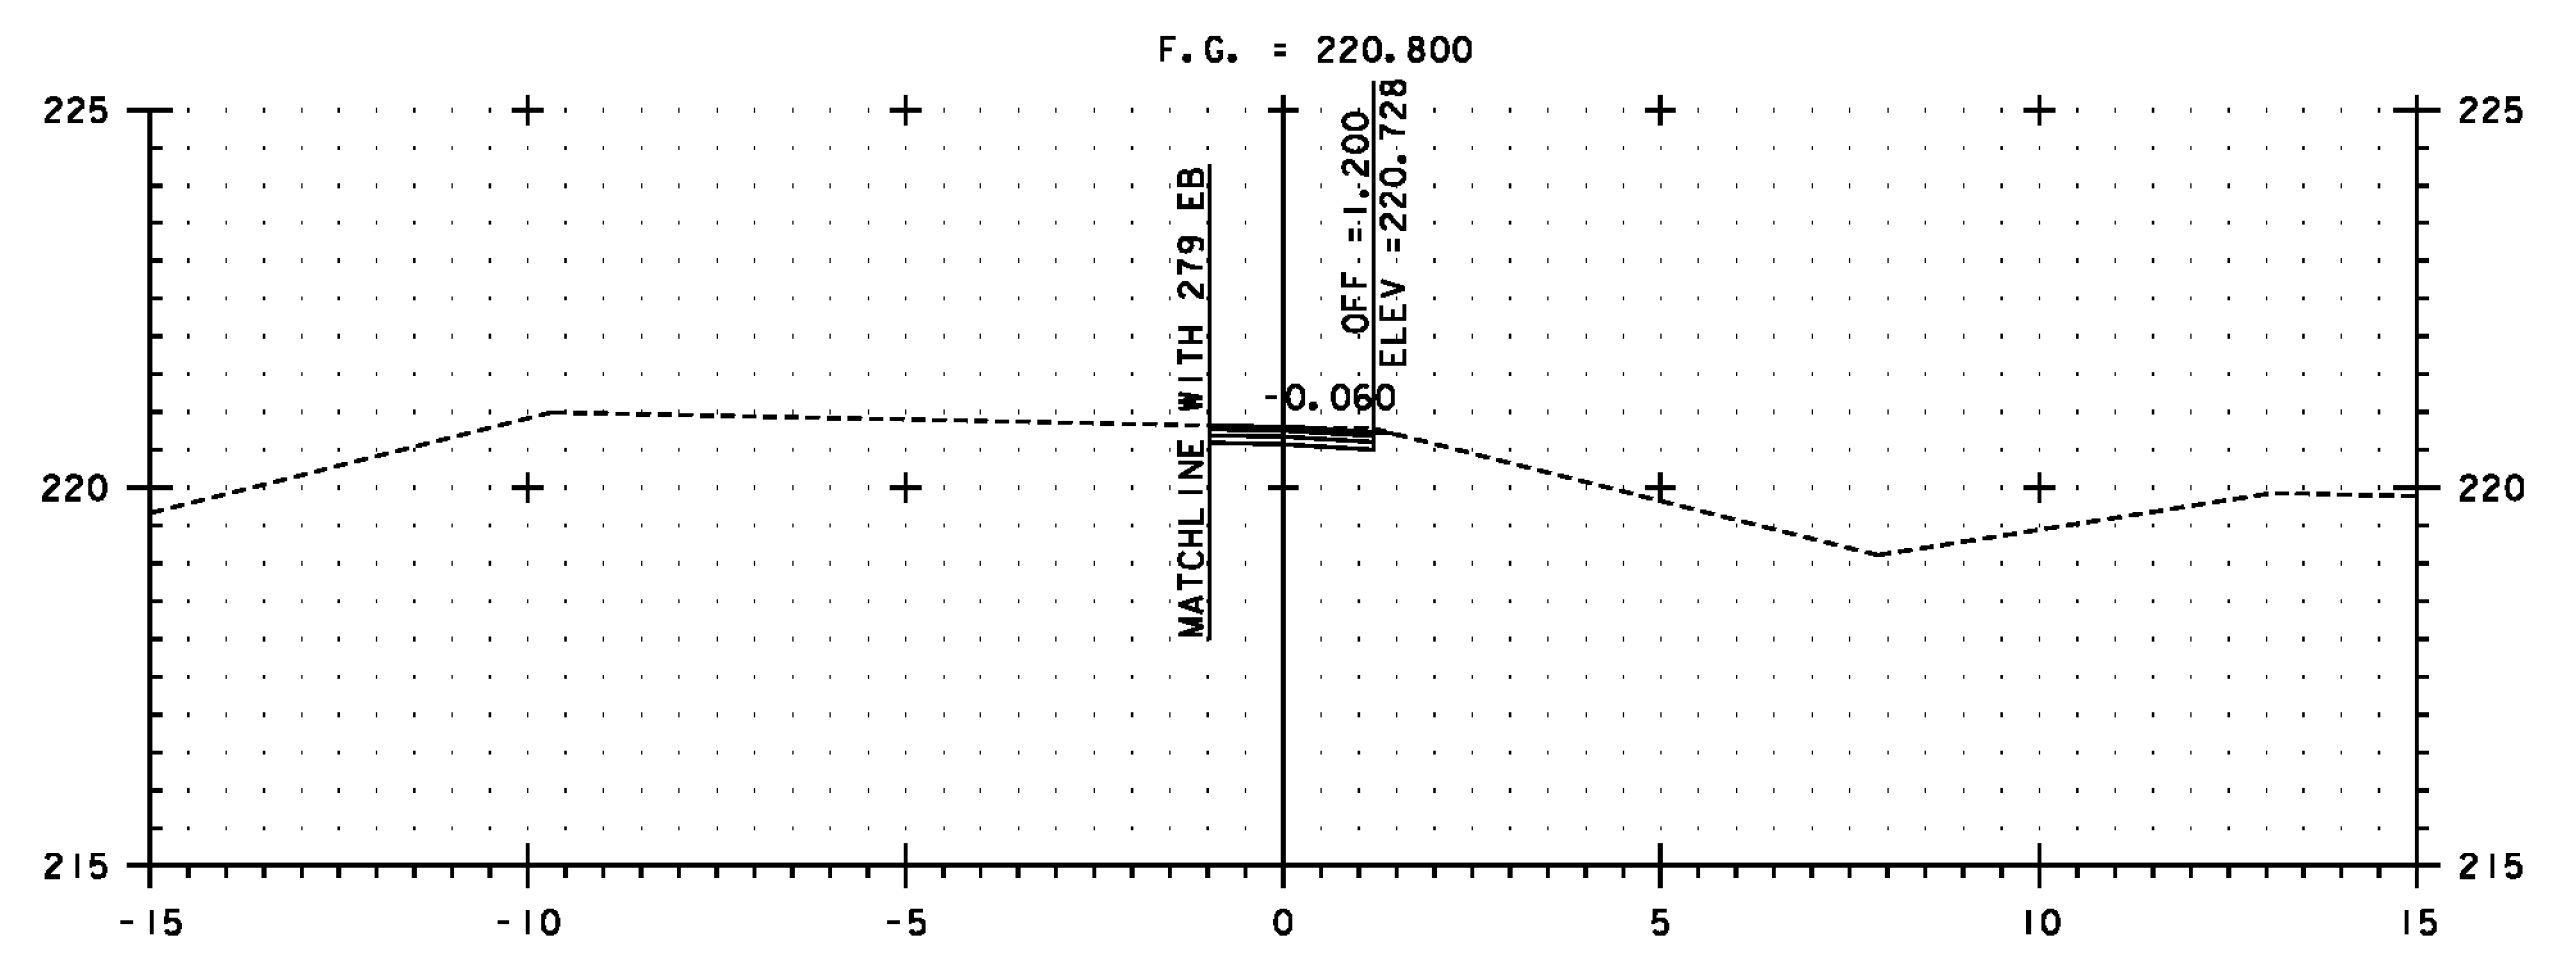

L 1+460

SEE NOTE ON SHEET 382

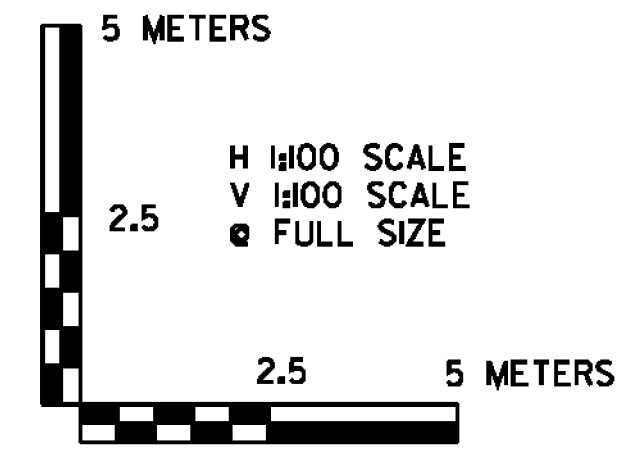

PROJECT NAME:	BENNINGTON
PROJECT NUMBER:	NH 019-(154)
FILE NAME:	...\\plot_files\zd307c4xs.rampL.ptf
DESIGN SUPERVISOR:	GREG EDWARDS
DESIGNED BY:	MARC FOISY
RAMP L CROSS SECTION	LXS-06
PLOT DATE:	1/26/2010
DRAWN BY:	STANTEC
CHECKED BY:	GARY SANTY
SHEET	393 OF 468

1/26/2010 4:57:31 PM V:\1953\getlive\1953\002A\transportation\dwg\conform\conform.dwg 4\plot_files\zd307c4xs.rampL.ptf