




N 1+020

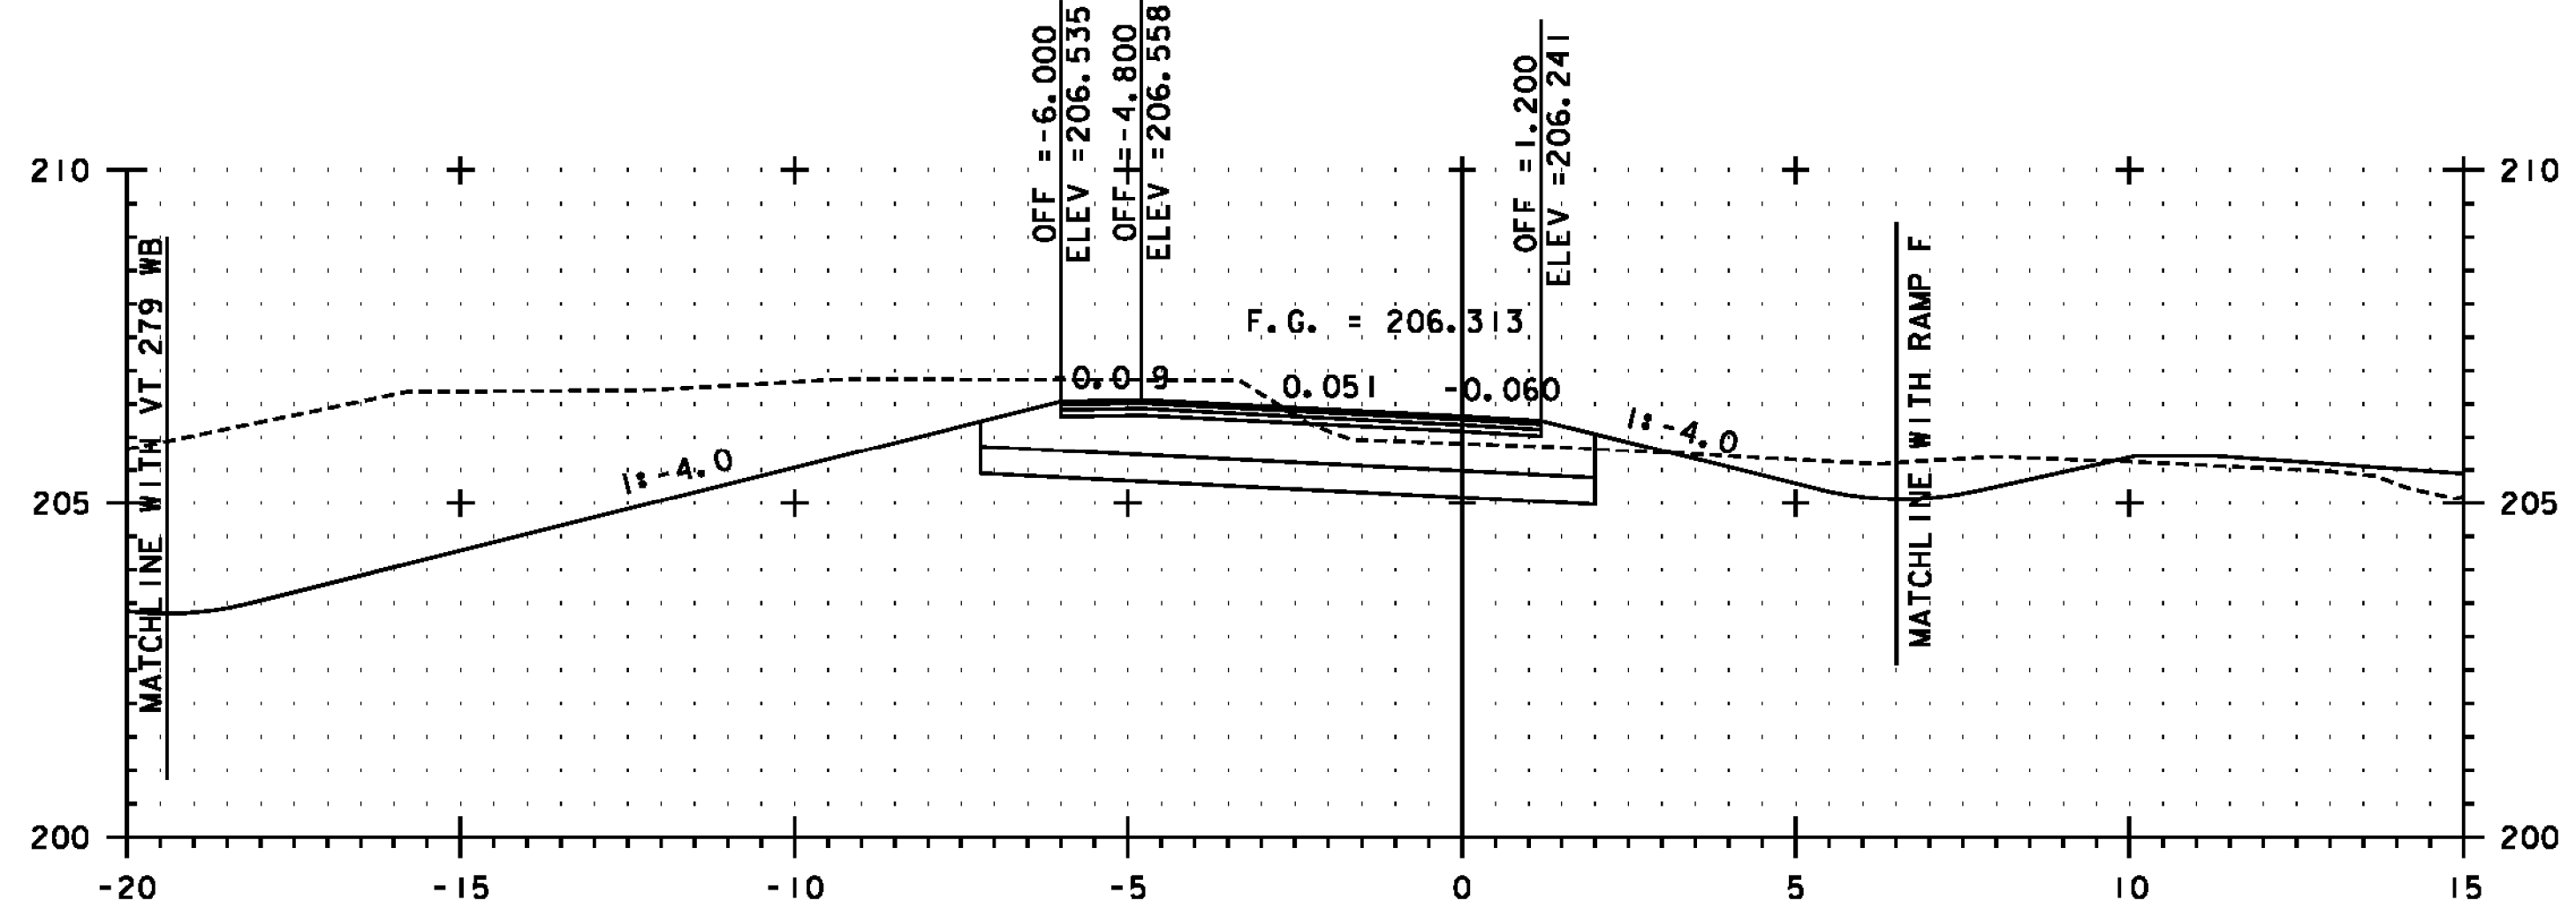

N 1+060

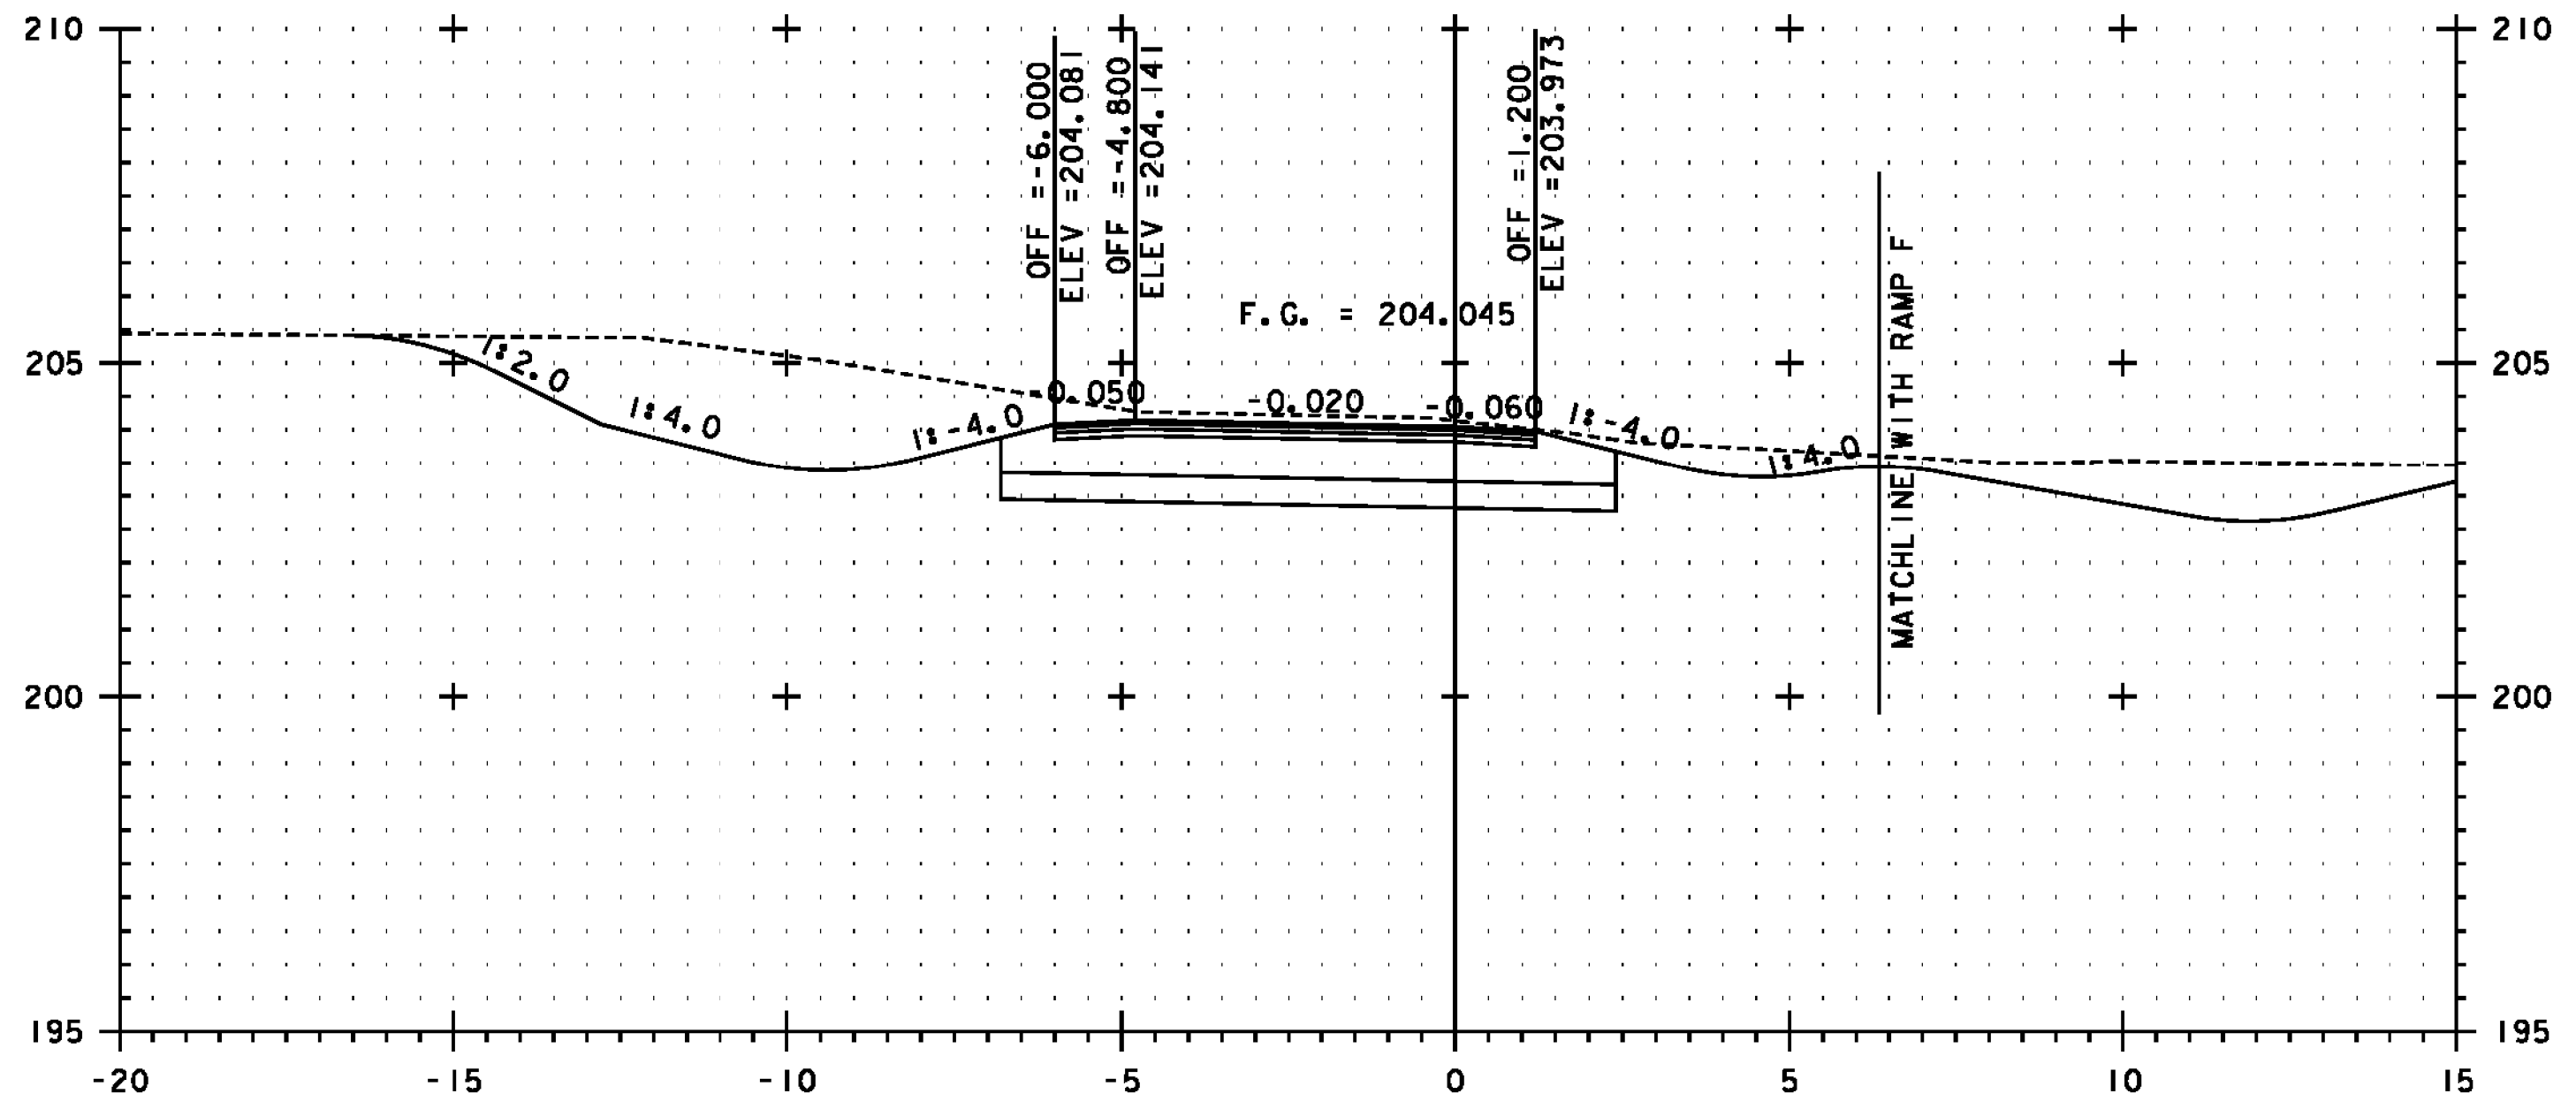


N 1+000

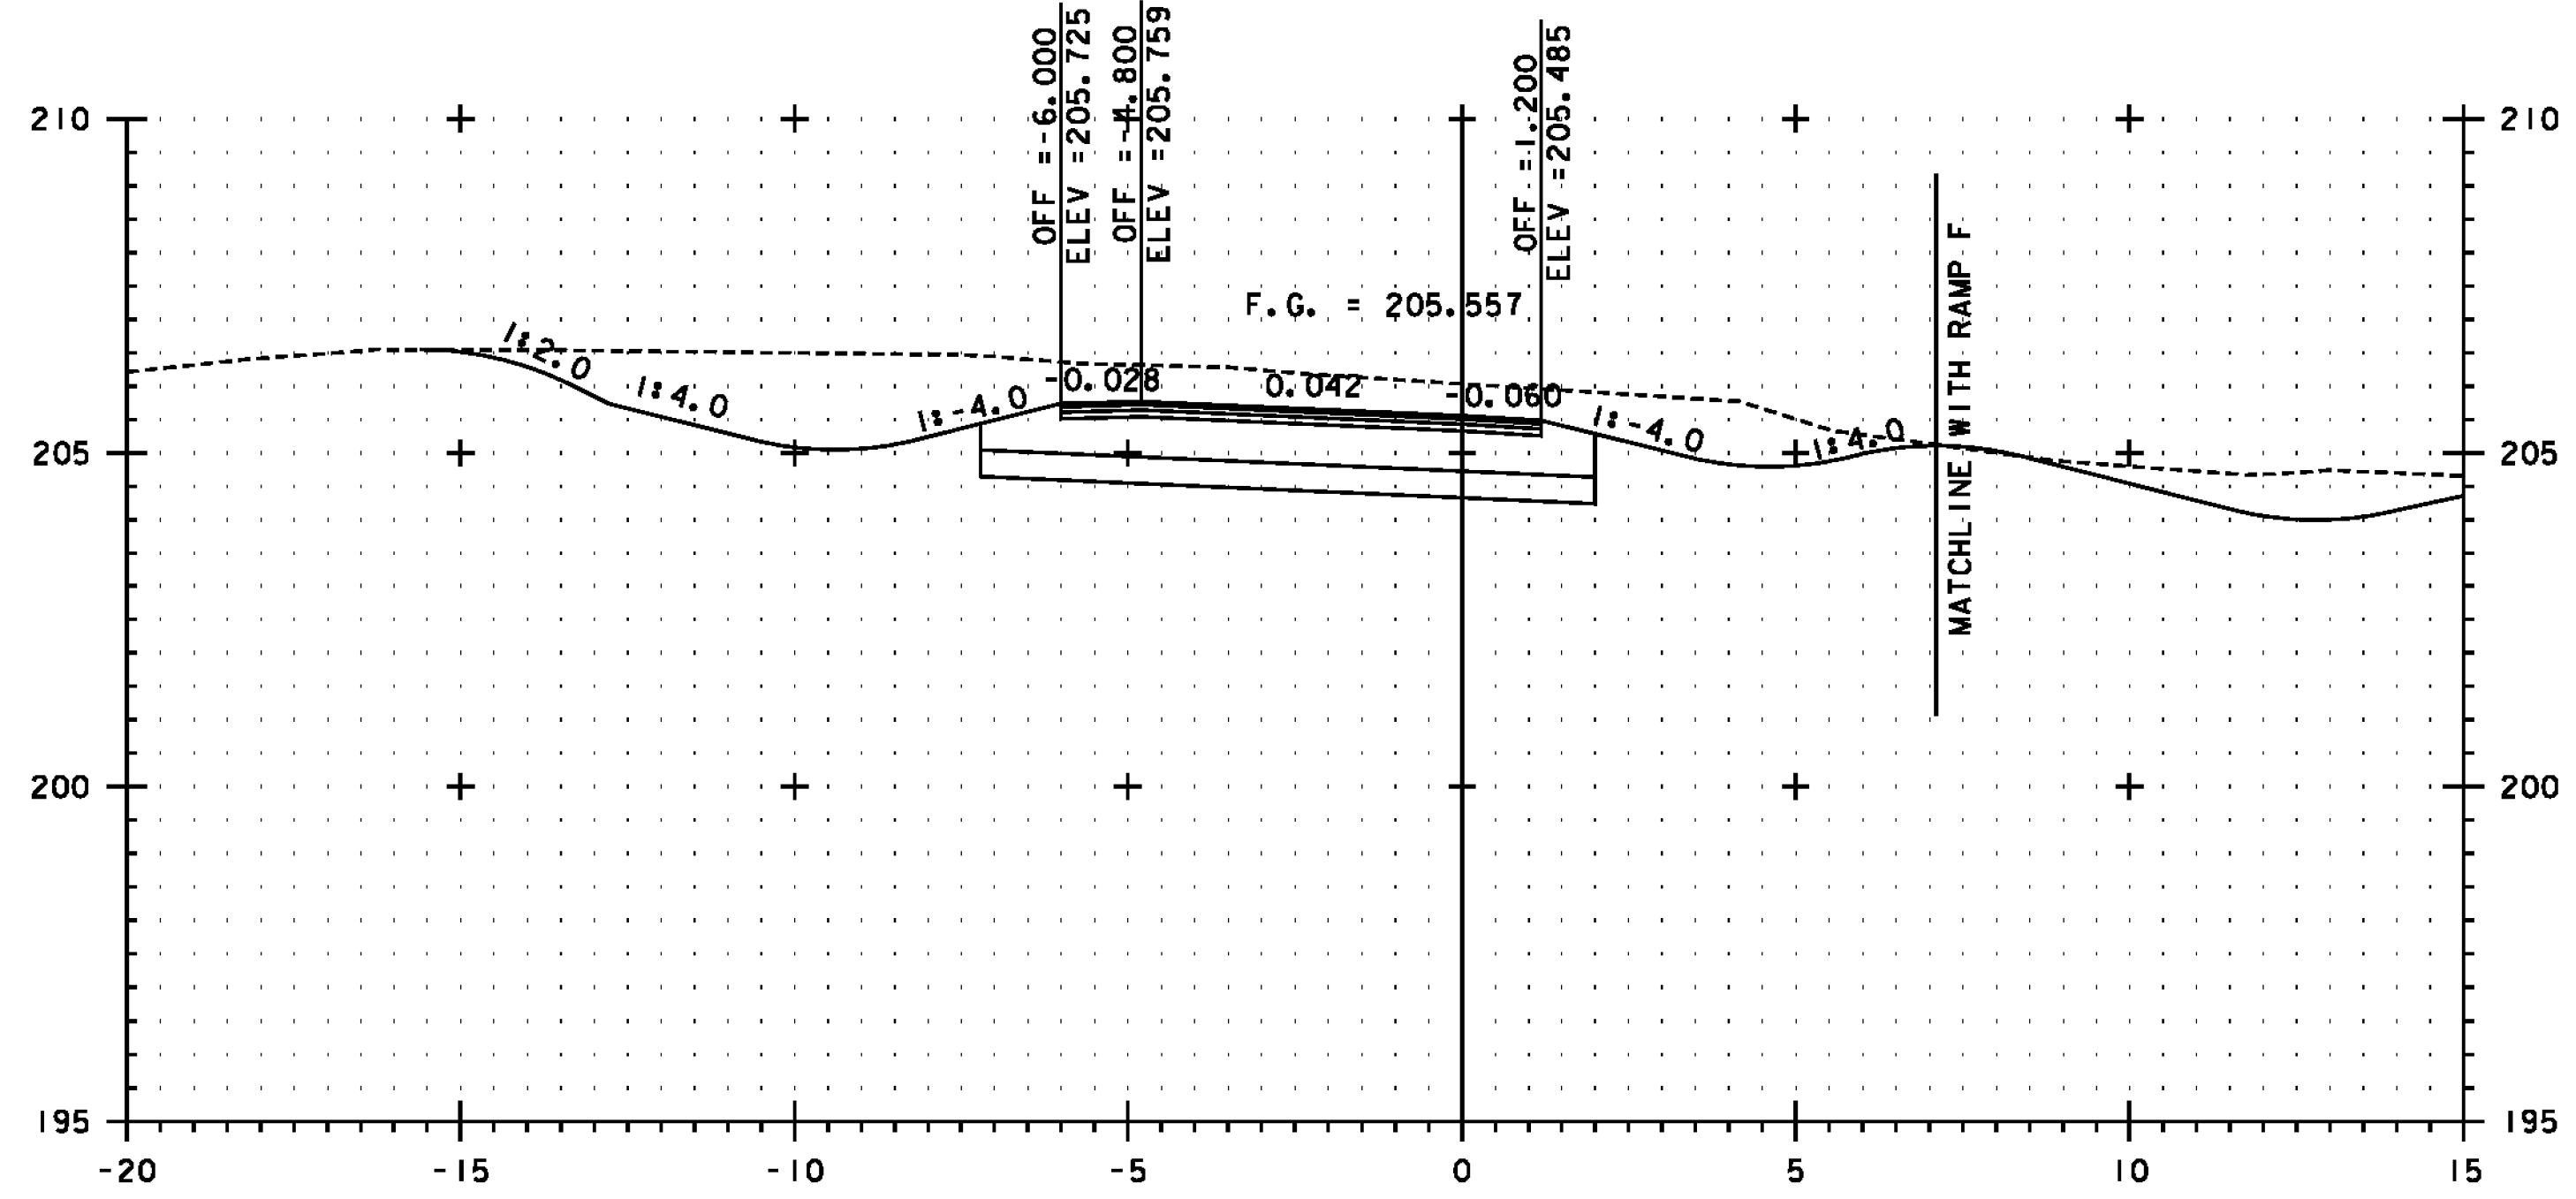

N 1+040

NOTE: FINAL CROSS SECTIONS FOR RAMP N ARE CONTAINED IN THE FINAL COMP BOOKS FOR ITEM 203.15 - COMMON EXCAVATION

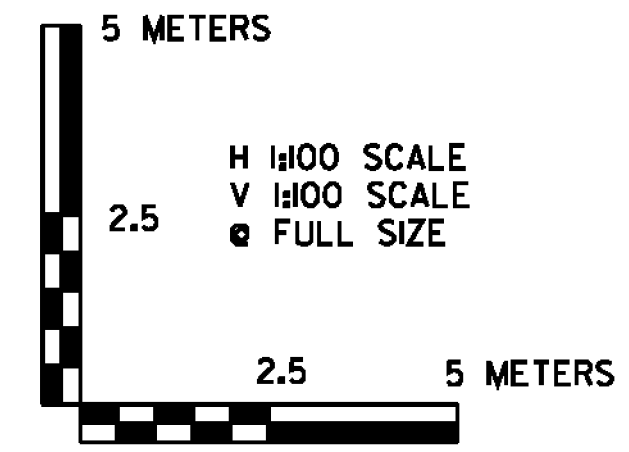

SEE REVISED SHEET

PROJECT NAME:	BENNINGTON
PROJECT NUMBER:	NH 019-(154)
FILE NAME:	...plot_files\zd307c4xs.rampN.ptf
DESIGN SUPERVISOR:	GREG EDWARDS
DESIGNED BY:	MARC FOISY
RAMP N CROSS SECTION	NXS-01
PLOT DATE:	1/26/2010
DRAWN BY:	STANTEC
CHECKED BY:	GARY SANTY
SHEET	395 OF 468

1/26/2010 4:57:34 PM v:\1953\getlive\19530002\transportation\drw\ng\comp\tr\def\4\plot\_files\zd307c4xs.rampN.ptf