


NOTE:
REFER TO RAMP F CROSS SECTIONS FOR STA. N 1+120 CONSTRUCTION.

SEE NOTE ON SHEET 395

SEE REVISED SHEET

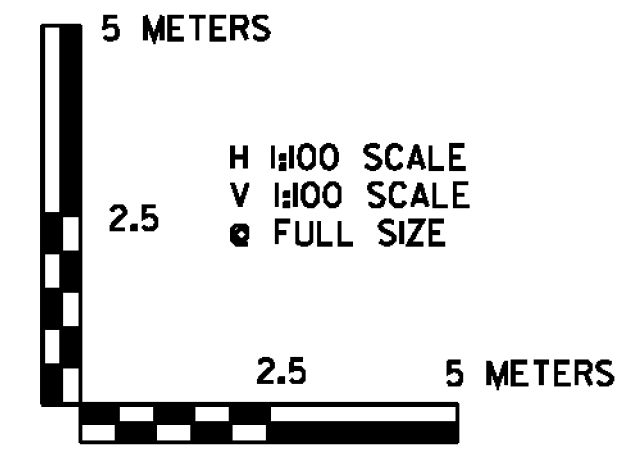

PROJECT NAME:	BENNINGTON
PROJECT NUMBER:	NH 019-(154)
FILE NAME:	...plot_files\zd307c4xs.rampN.ptf
DESIGN SUPERVISOR:	GREG EDWARDS
DESIGNED BY:	MARC FOISY
RAMP N CROSS SECTION	NXS-02
PLOT DATE:	1/26/2010
DRAWN BY:	STANTEC
CHECKED BY:	GARY SANTY
SHEET	396 OF 468

1/26/2010 4:57:35 PM v:\1953\getlive\19530002\transportation\drw\mg\comp\tr\def_4\plot_files\zd307c4xs.rampN.ptf