


NOTE:  
REFER TO RAMP F CROSS SECTIONS FOR STA.  
N 1+120 CONSTRUCTION.

See Note on  
Sheet 395 (Revised)

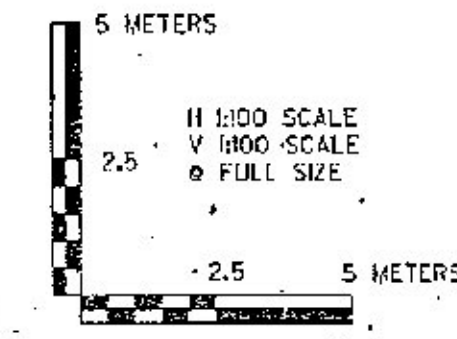

**Record Plans**

PROJECT NAME: BENNINGTON	PROJECT NUMBER: NH 019-1(54)
FILE NAME: \\z0301c4xs\p0301p11	PLOT DATE: 5/27/2010
DESIGN SUPERVISOR: GREG EDWARDS	DRAWN BY: STANTEC
DESIGNED BY: MARC FOISY	CHECKED BY: GARY SARTY
RAMP N CROSS SECTION NXS-02	SHEET OF
RAMP N CROSS SECTION NXS-02	SHEET 396 OF 468