




P I+280

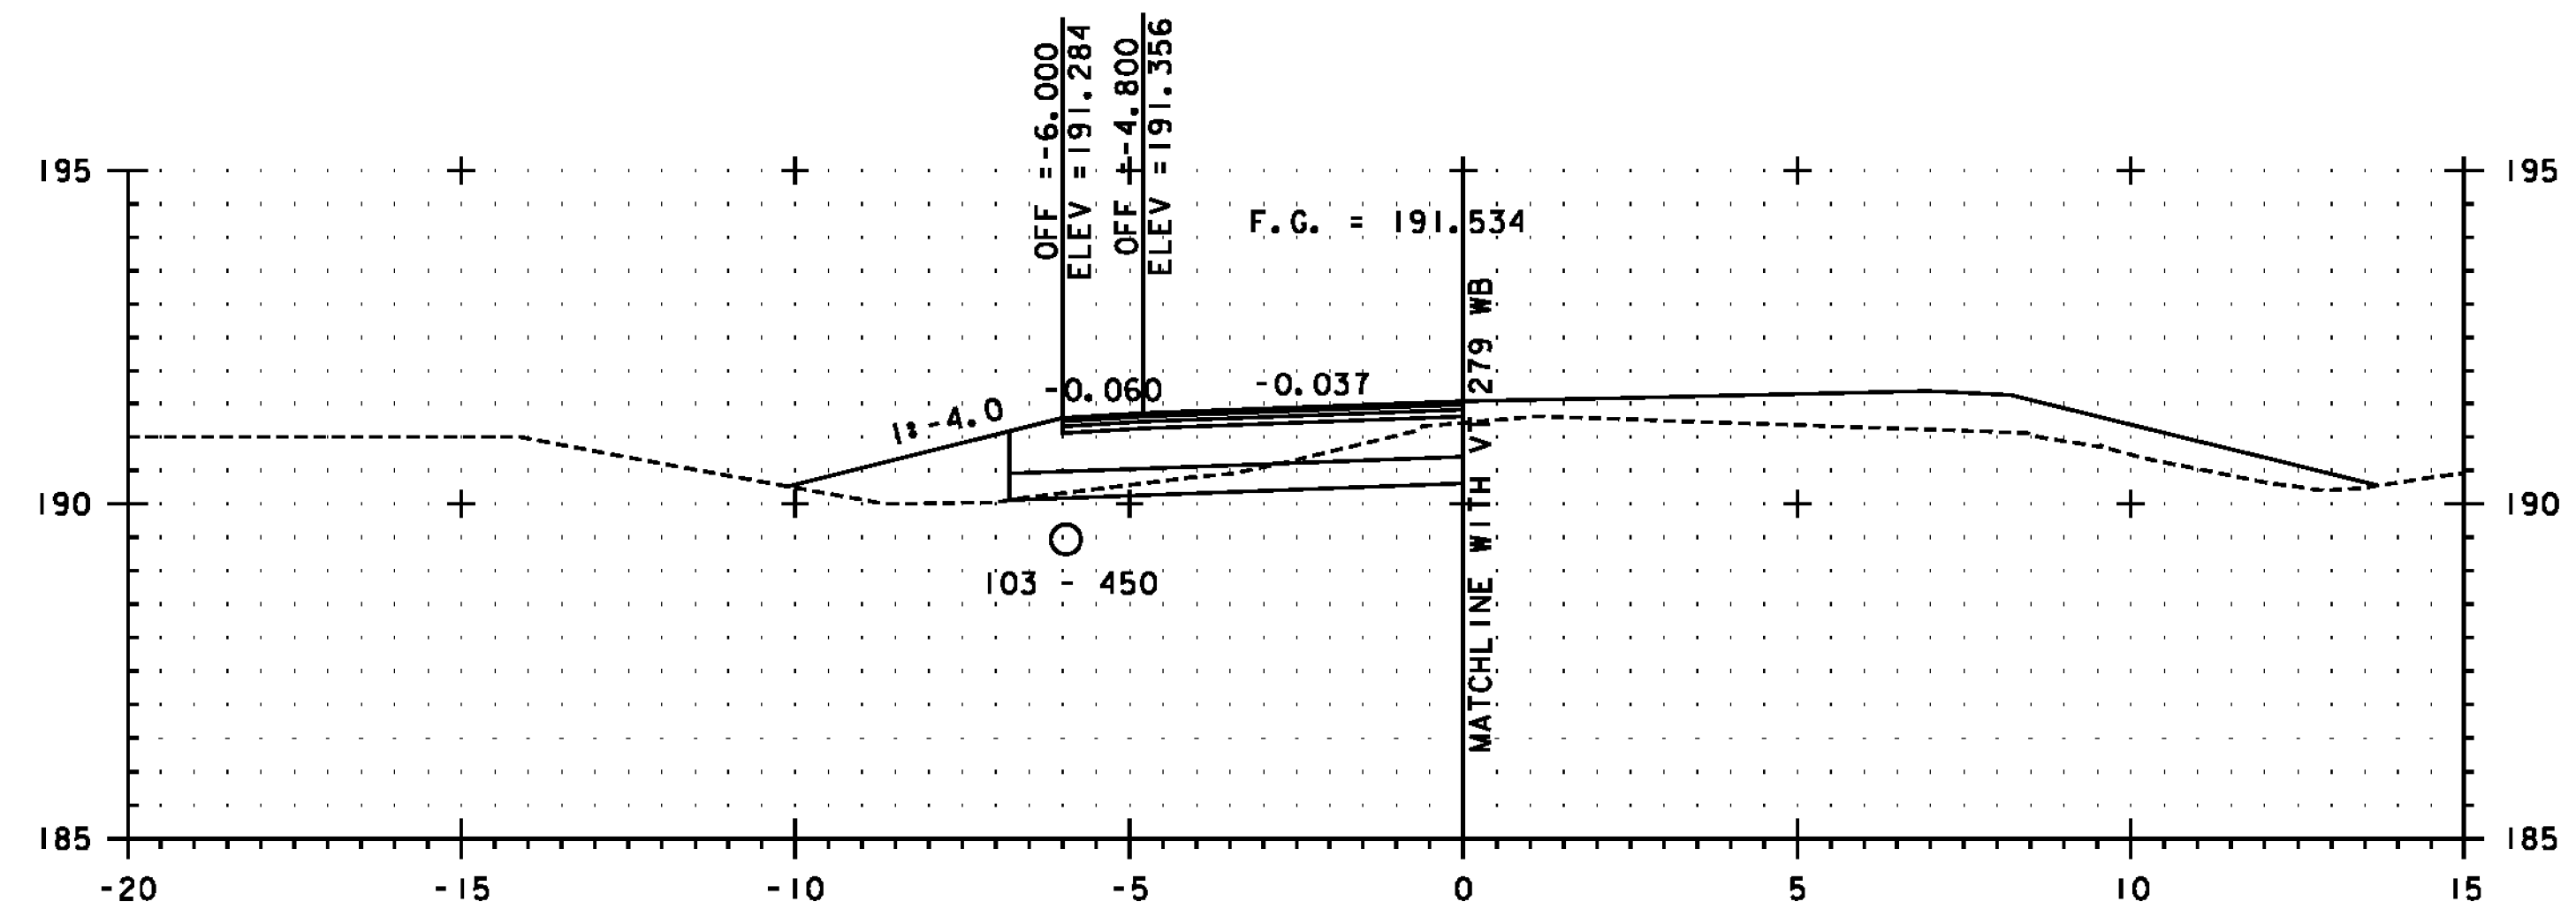

P I+260

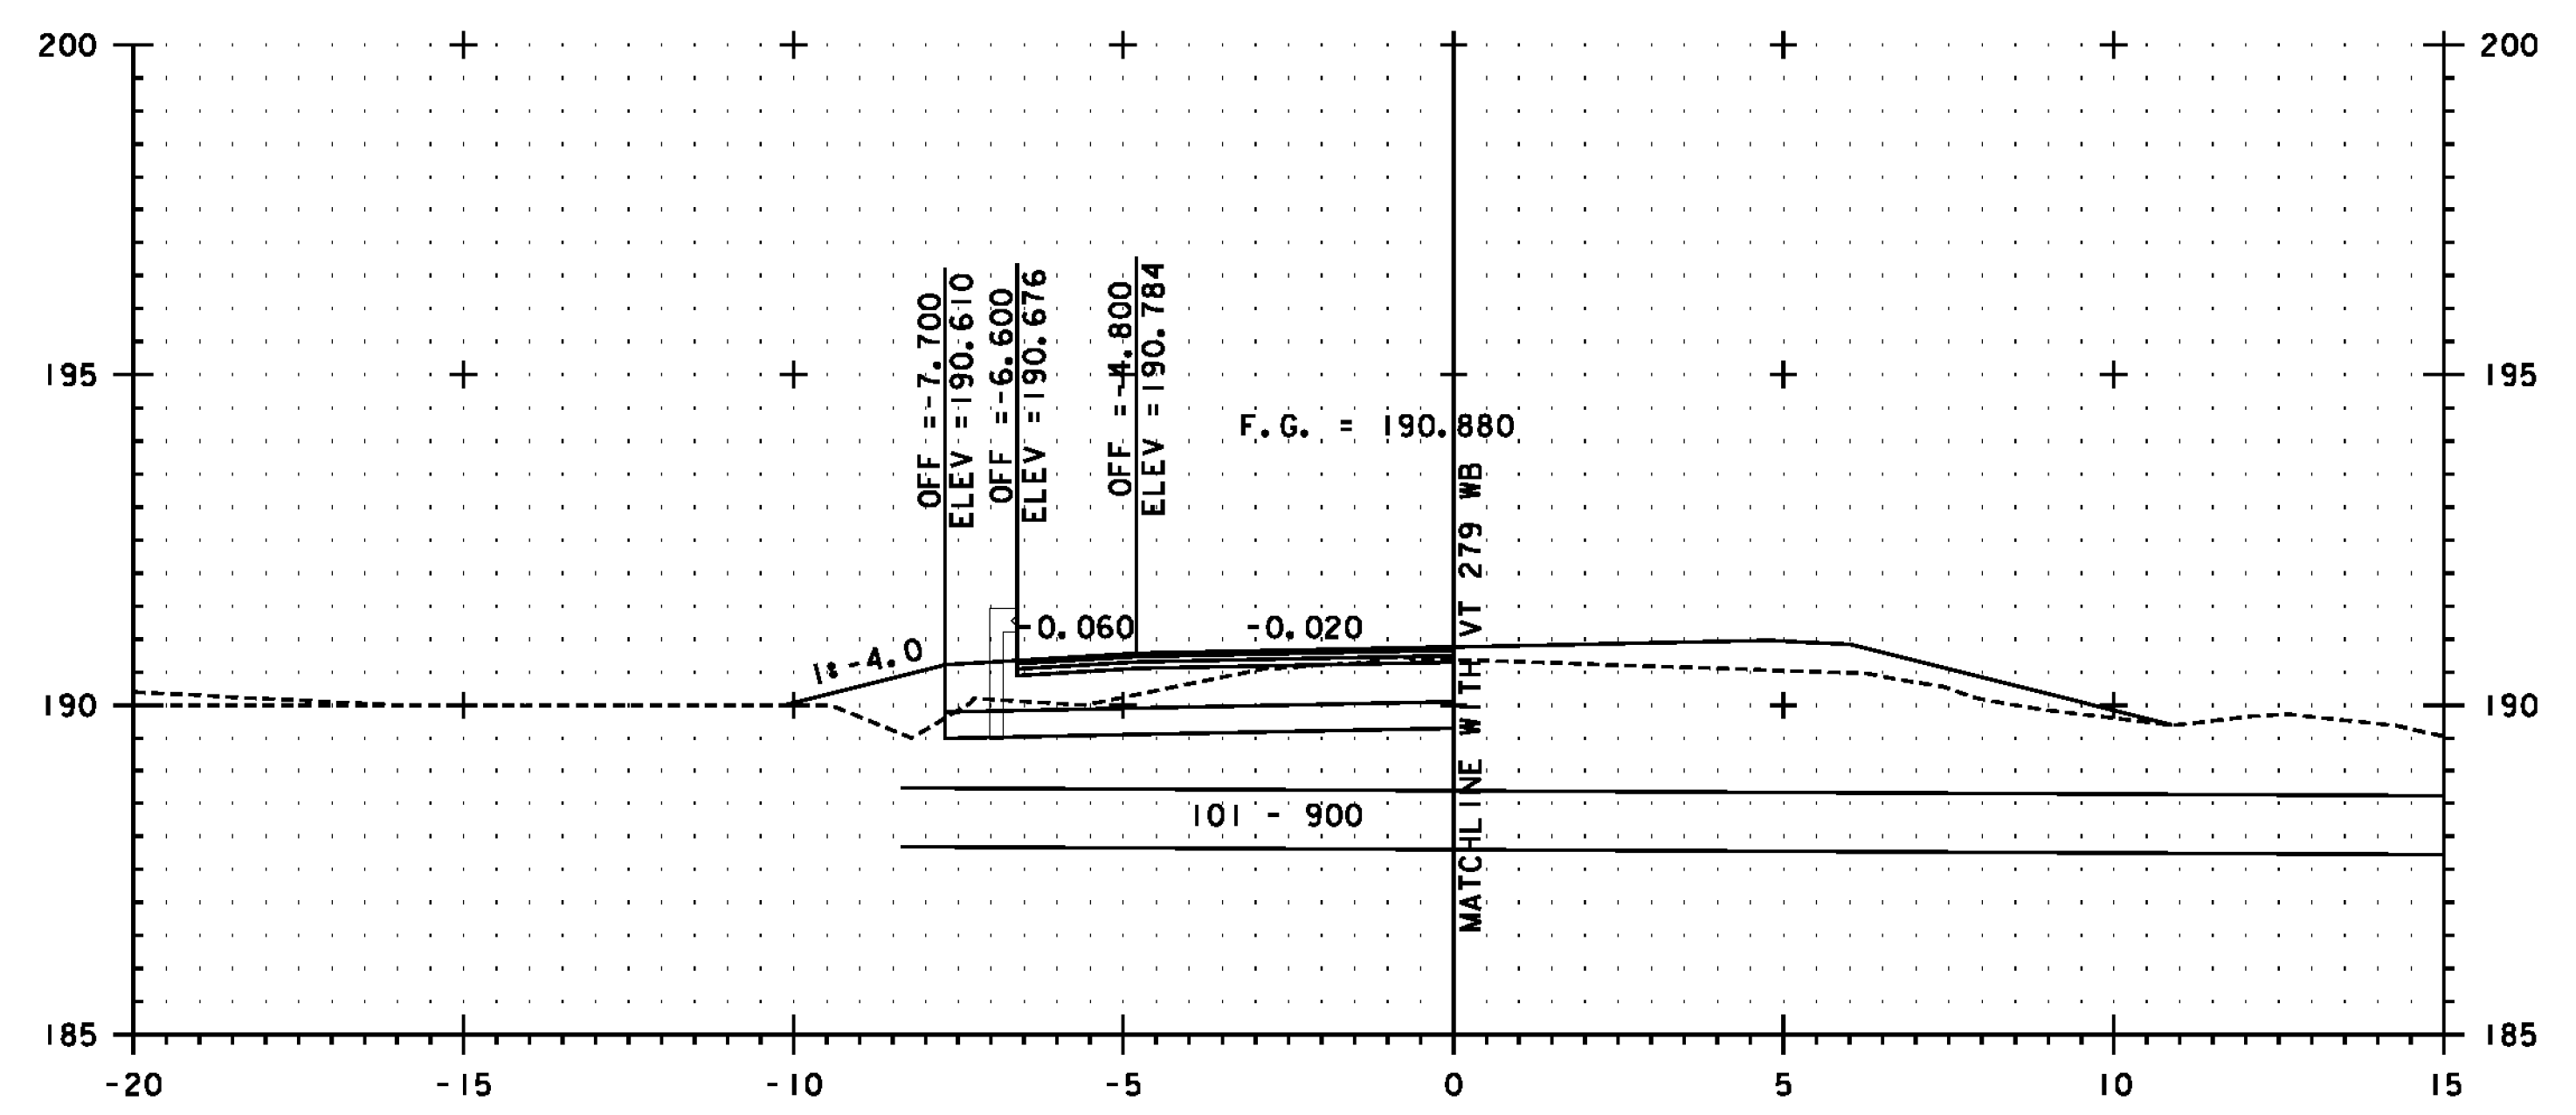


P I+305.358 = WB 10+800.135, 4.8m LT.

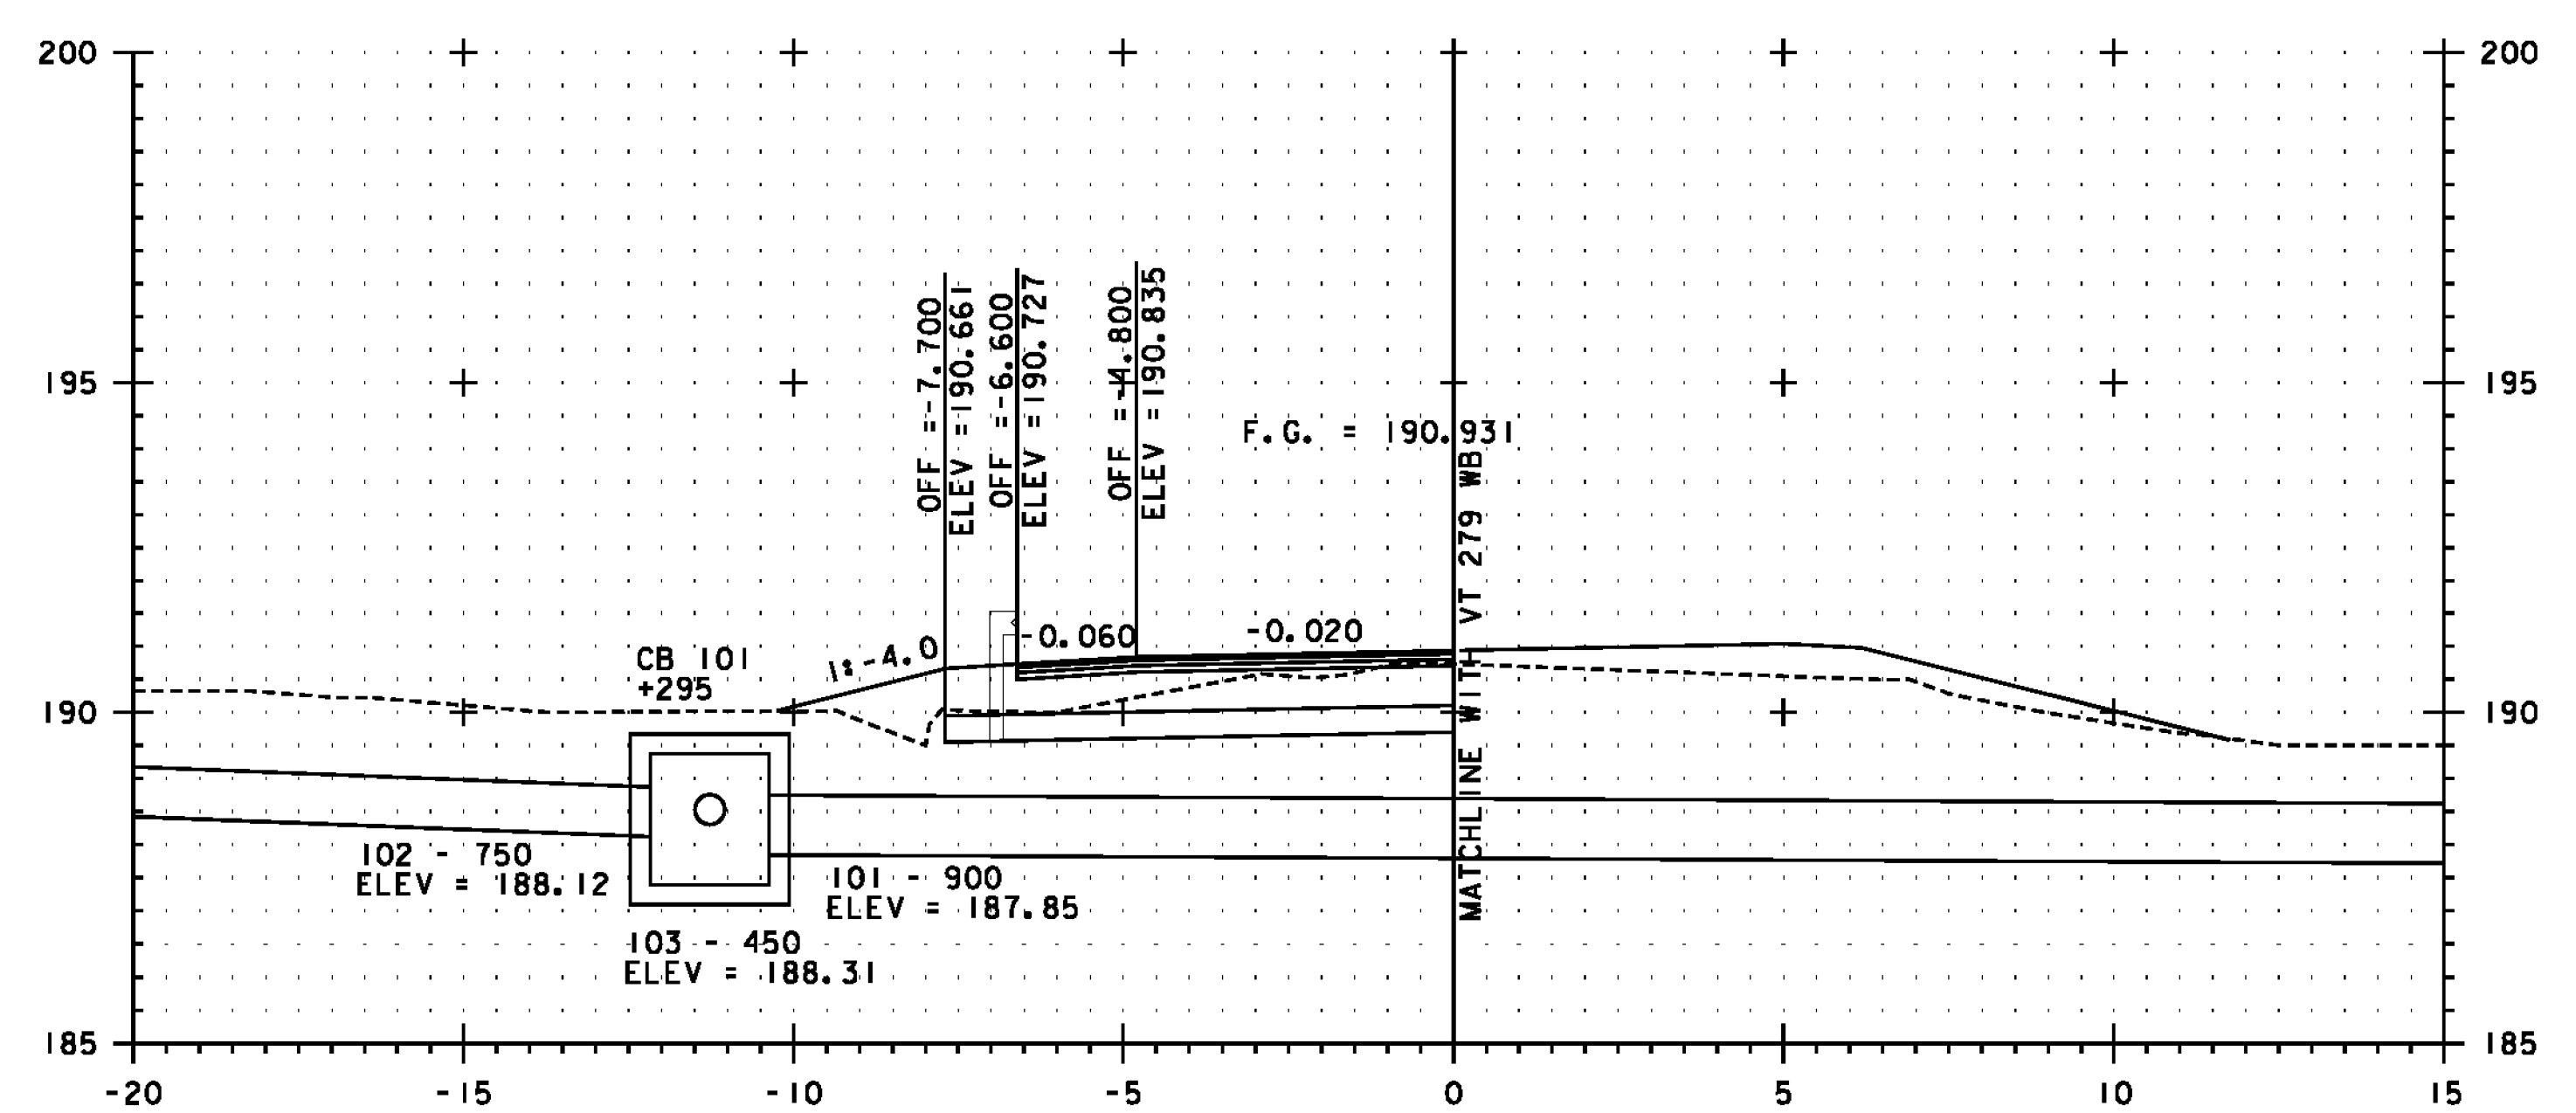

P I+300

SEE NOTE ON SHEET 397

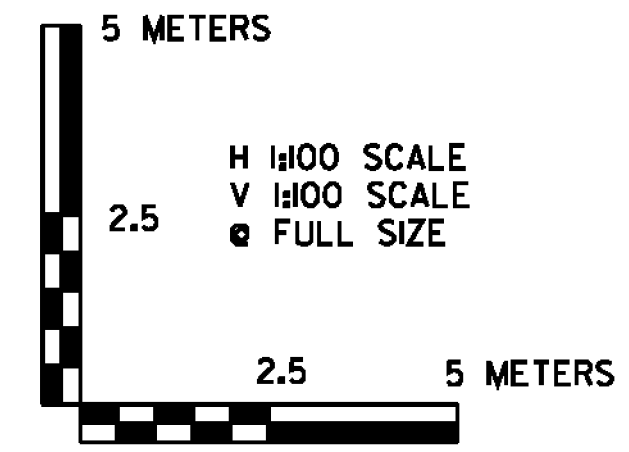

PROJECT NAME:	BENNINGTON
PROJECT NUMBER:	NH 019-(154)
FILE NAME:	...plot_files\zd307c4xs.rampP.ptf
PLOT DATE:	1/26/2010
DESIGN SUPERVISOR:	GREG EDWARDS
DRAWN BY:	STANTEC
DESIGNED BY:	MARC FOISY
CHECKED BY:	GARY SANTY
RAMP P CROSS SECTION	PXS-04
SHEET	400 OF 468

1/26/2010 4:57:40 PM v:\1953\getlive\19530002\tr\anspor\101\on\c\w\ng\com\tr\c\1_4\p\101_files\zd307c4xs.rampP.ptf