


NOTE: FINAL CROSS SECTIONS FOR RAMP Q ARE CONTAINED IN THE FINAL COMP BOOKS FOR ITEM 203.15 - COMMON EXCAVATION

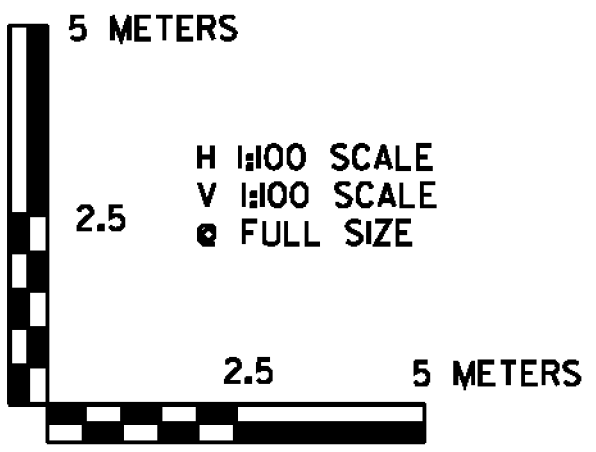

PROJECT NAME: BENNINGTON	
PROJECT NUMBER: NH 019-(154)	
FILE NAME: ...plot_files\zd307c4xs.ramp0.pptf	PLOT DATE: 3/16/2010
DESIGN SUPERVISOR: GREG EDWARDS	DRAWN BY: STANTEC
DESIGNED BY: MARC FOISY	CHECKED BY: GARY SANTY
RAMP Q CROSS SECTION QXS-01	
SHEET 401 OF 468	

SEE REVISED SHEETS

3/16/2010 11:42:28 AM v:\1953\getlive\19530002\transportation\dr\dwg\comp\tr\comp0.pptf