


10/2/2012

C:\2007\200703\00_Bennington Bypass\Bennington Bypass\Contract\Drawings\DWG\Exp_0_Concept_Exp_10-22-12.dgn

- Original Ground
- Station Design
- C54 Final Survey
- ////// 203.15 Common Excavation

0.000 SM

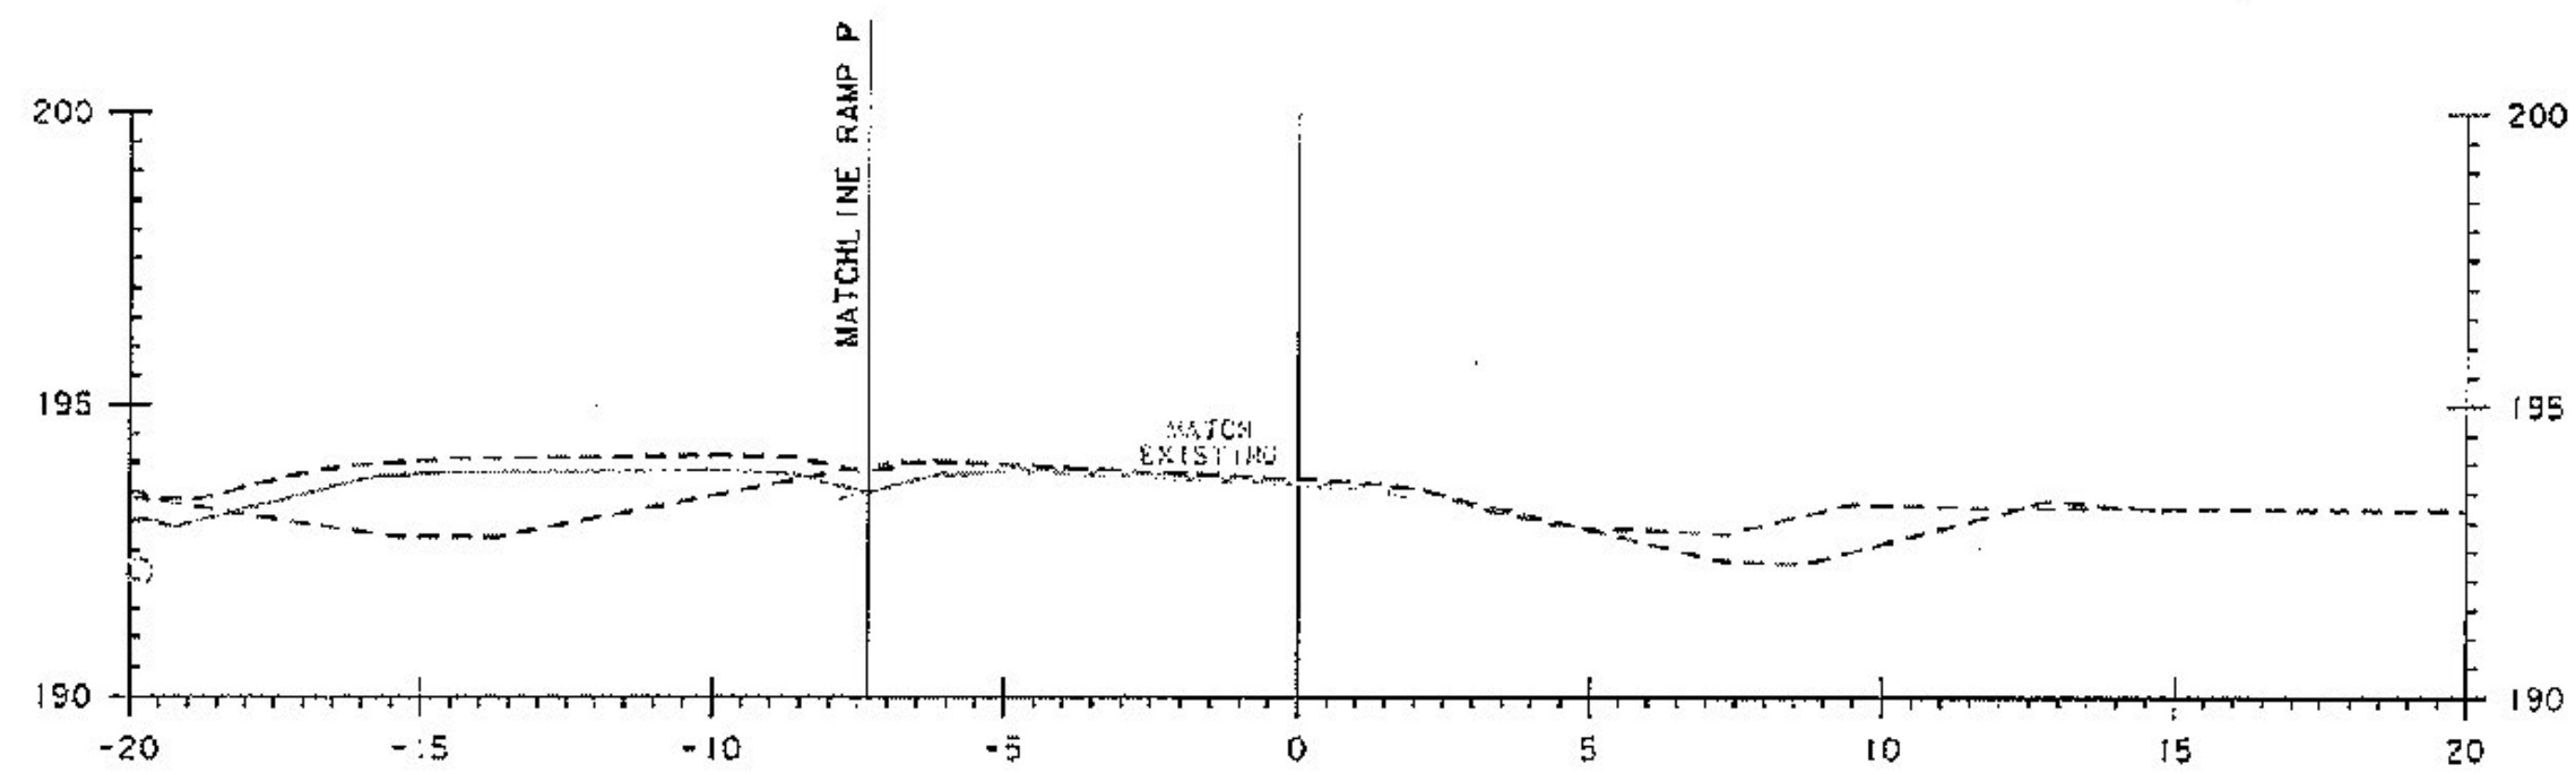

Q !+000.000 = G !+404.030

Bennington AC NH 019-1(54)
 Ramp Q Common Excavation
 October XX, 2012
 Calculated by GPI
 Scale 1:200

Revised

Checked By: