


SEE NOTE ON SHEET 401

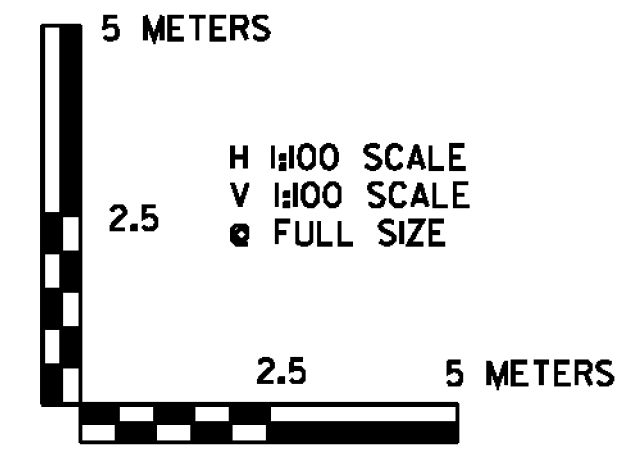

PROJECT NAME:	BENNINGTON
PROJECT NUMBER:	NH 019-(54)
FILE NAME:	...plot_files\zd307c4xs.ramp0.ptf
PLOT DATE:	1/26/2010
DESIGN SUPERVISOR:	GREG EDWARDS
DRAWN BY:	STANTEC
DESIGNED BY:	MARC FOISY
CHECKED BY:	GARY SANTY
RAMP Q CROSS SECTION	QXS-02
	SHEET 402 OF 468

1/26/2010 4:57:43 PM v:\1953\getlive\19530002\transport\101\dr\dwg\confr\001_4\plot_files\zd307c4xs.ramp0.ptf