


NOTE: FINAL CROSS SECTIONS FOR RAMP R ARE CONTAINED IN THE FINAL COMP BOOKS FOR ITEM 203.15 - COMMON EXCAVATION

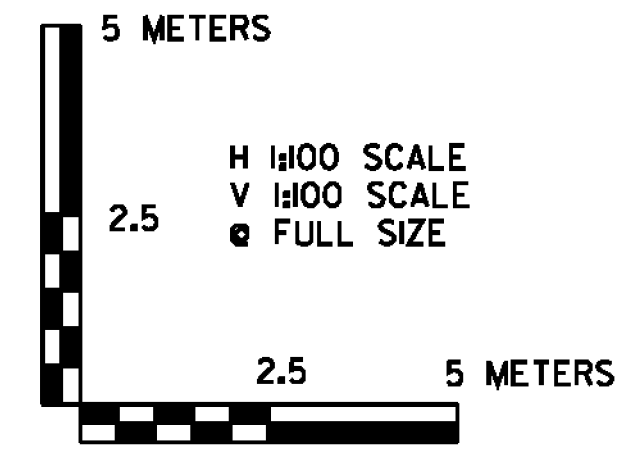

PROJECT NAME: BENNINGTON	
PROJECT NUMBER: NH 019-(154)	
FILE NAME: ...\plot_files\zd307c4xs.rampR.ptf	PLOT DATE: 1/26/2010
DESIGN SUPERVISOR: GREG EDWARDS	DRAWN BY: STANTEC
DESIGNED BY: MARC FOISY	CHECKED BY: GARY SANTY
<b>RAMP R CROSS SECTION RXS-01</b>	SHEET 403 OF 468

1/26/2010 4:57:46 PM v:\1953\getlive\1953\002\transportation\drw\ng\comp\comp1.dwg - files\zd307c4xs.rampR.ptf