


SEE NOTE ON SHEET 403

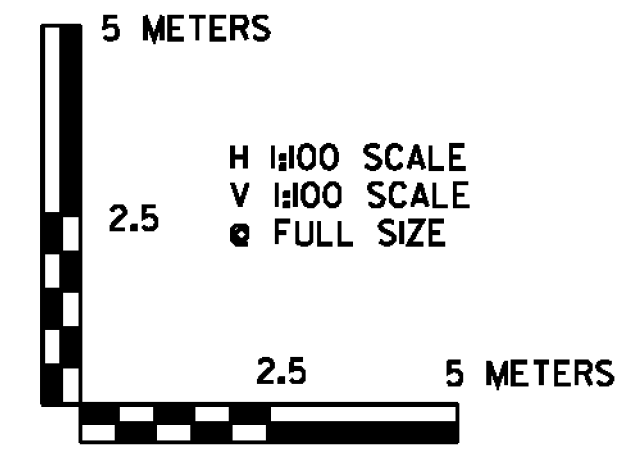

PROJECT NAME: BENNINGTON	
PROJECT NUMBER: NH 019-(154)	
FILE NAME: ...\plot_files\zd307c4xs.rampR.ptf	PLOT DATE: 1/26/2010
DESIGN SUPERVISOR: GREG EDWARDS	DRAWN BY: STANTEC
DESIGNED BY: MARC FOISY	CHECKED BY: GARY SANTY
RAMP R CROSS SECTION RXS-02	SHEET 404 OF 468

1/26/2010 4:57:47 PM v:\1953\getlive\19530002\tr\anspor\101\dr\cwg\ng\confr\c01_4\p01_files\zd307c4xs_rampR.ptf