



R I+100

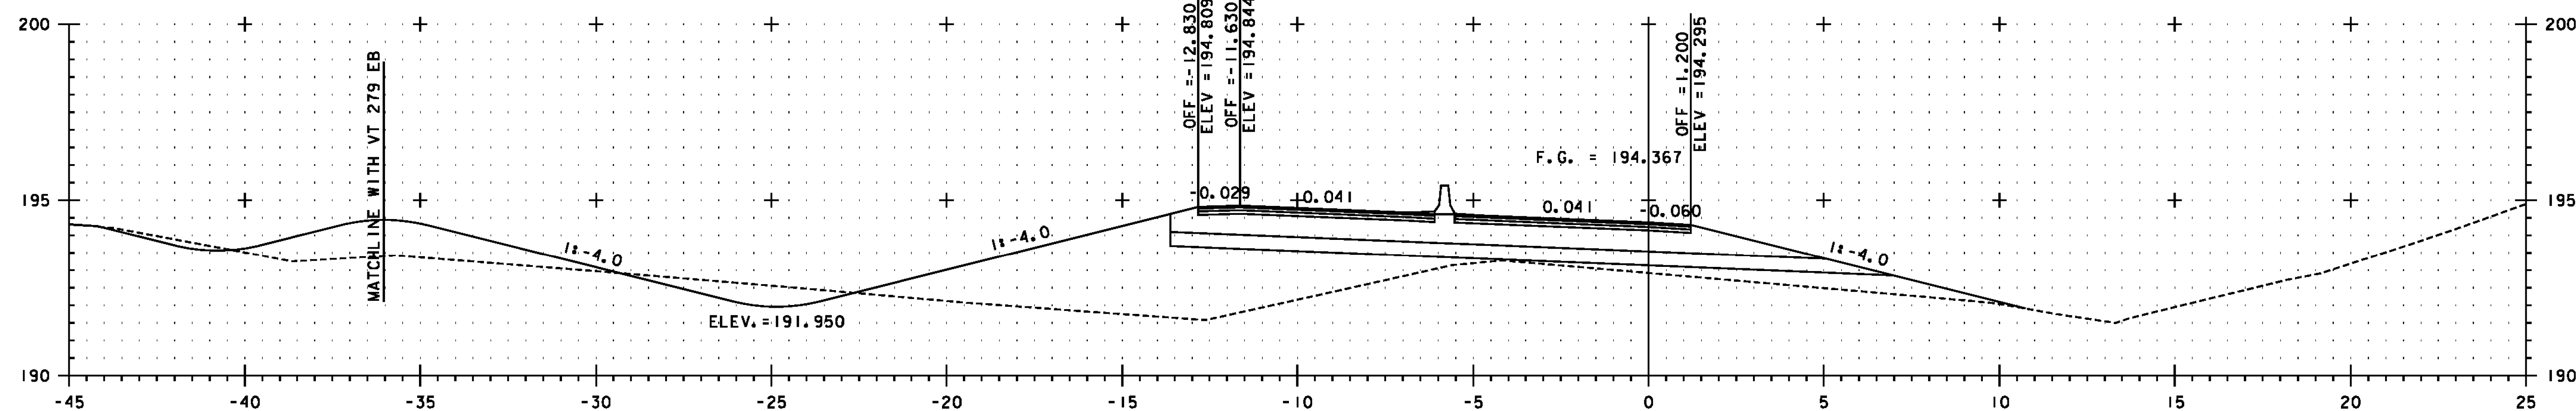


R I+080

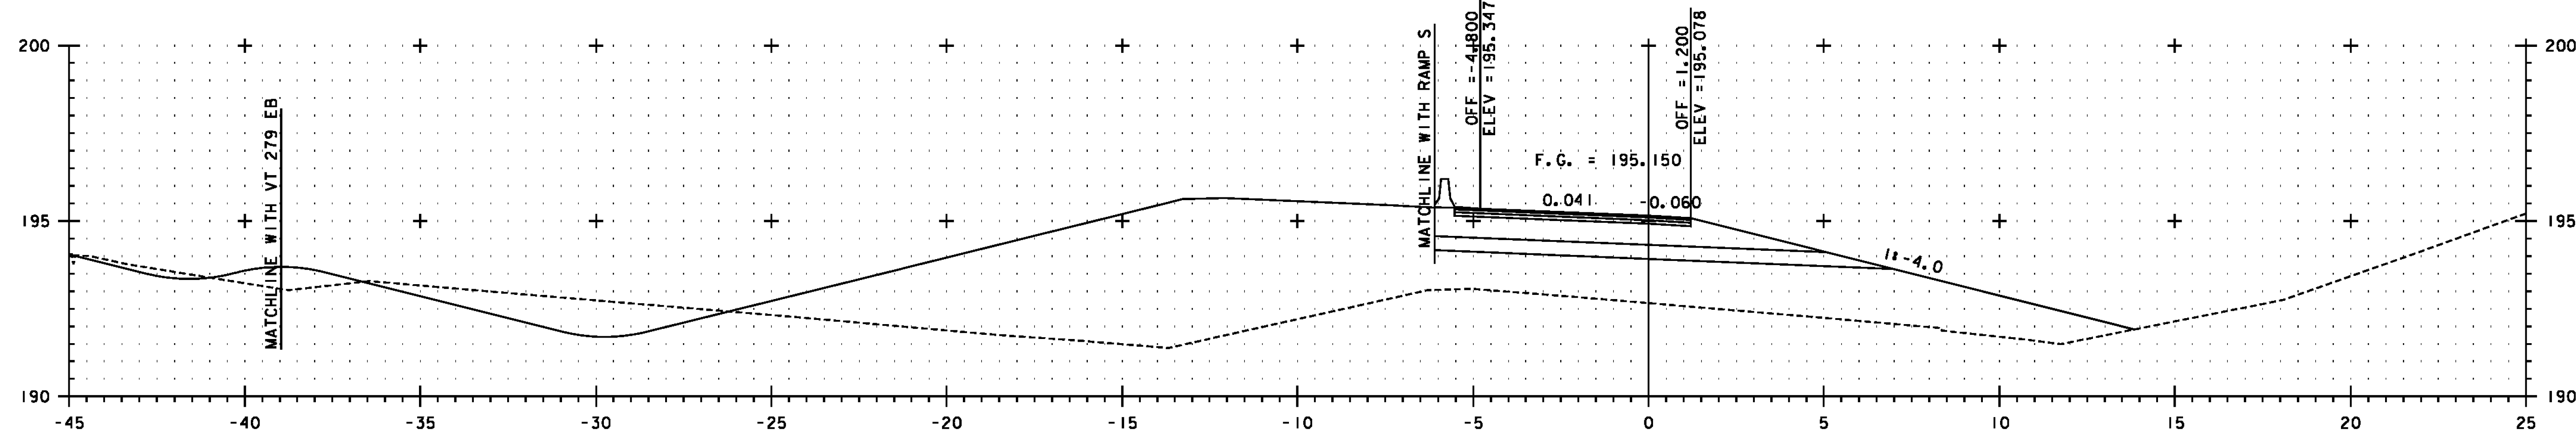

R I+060

SEE NOTE ON SHEET 403

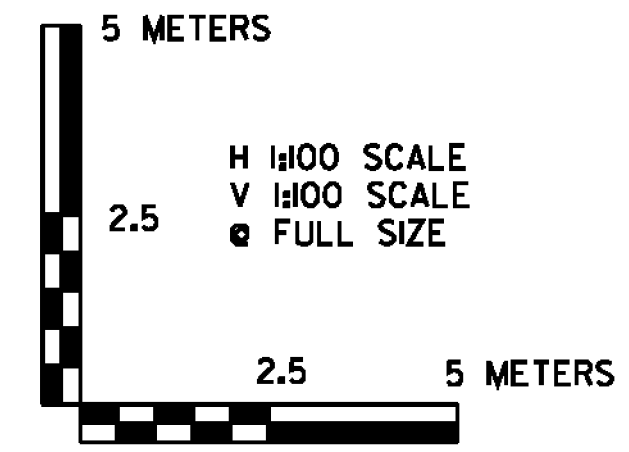

PROJECT NAME: BENNINGTON	
PROJECT NUMBER: NH 019-(154)	
FILE NAME: ...plot_files\zd307c4xs.rampR.ptf	PLOT DATE: 1/26/2010
DESIGN SUPERVISOR: GREG EDWARDS	DRAWN BY: STANTEC
DESIGNED BY: MARC FOISY	CHECKED BY: GARY SANTY
RAMP R CROSS SECTION RXS-03	
SHEET 405 OF 468	

1/26/2010 4:57:48 PM v:\1953\getlive\19530002\transportation\drawing\conform\4\plot_files\zd307c4xs.rampR.ptf