




S 1+120

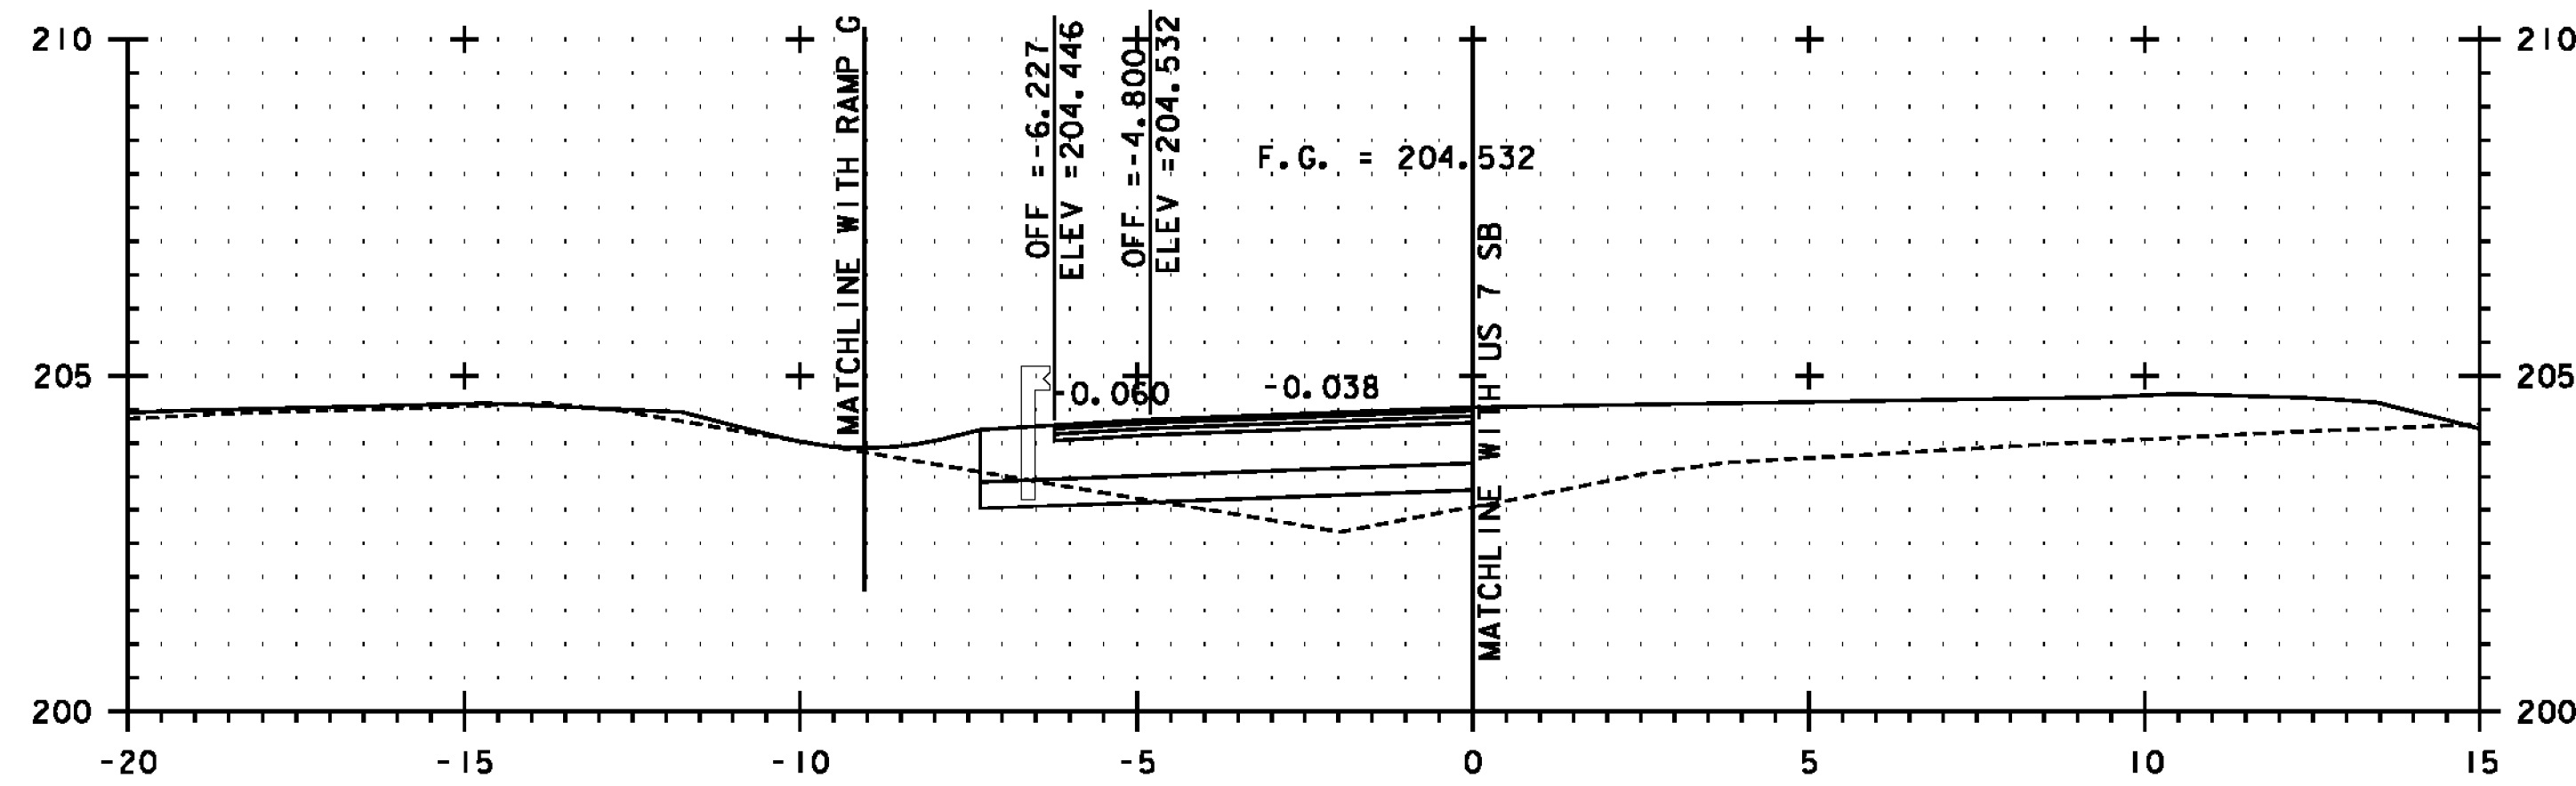


S 1+100

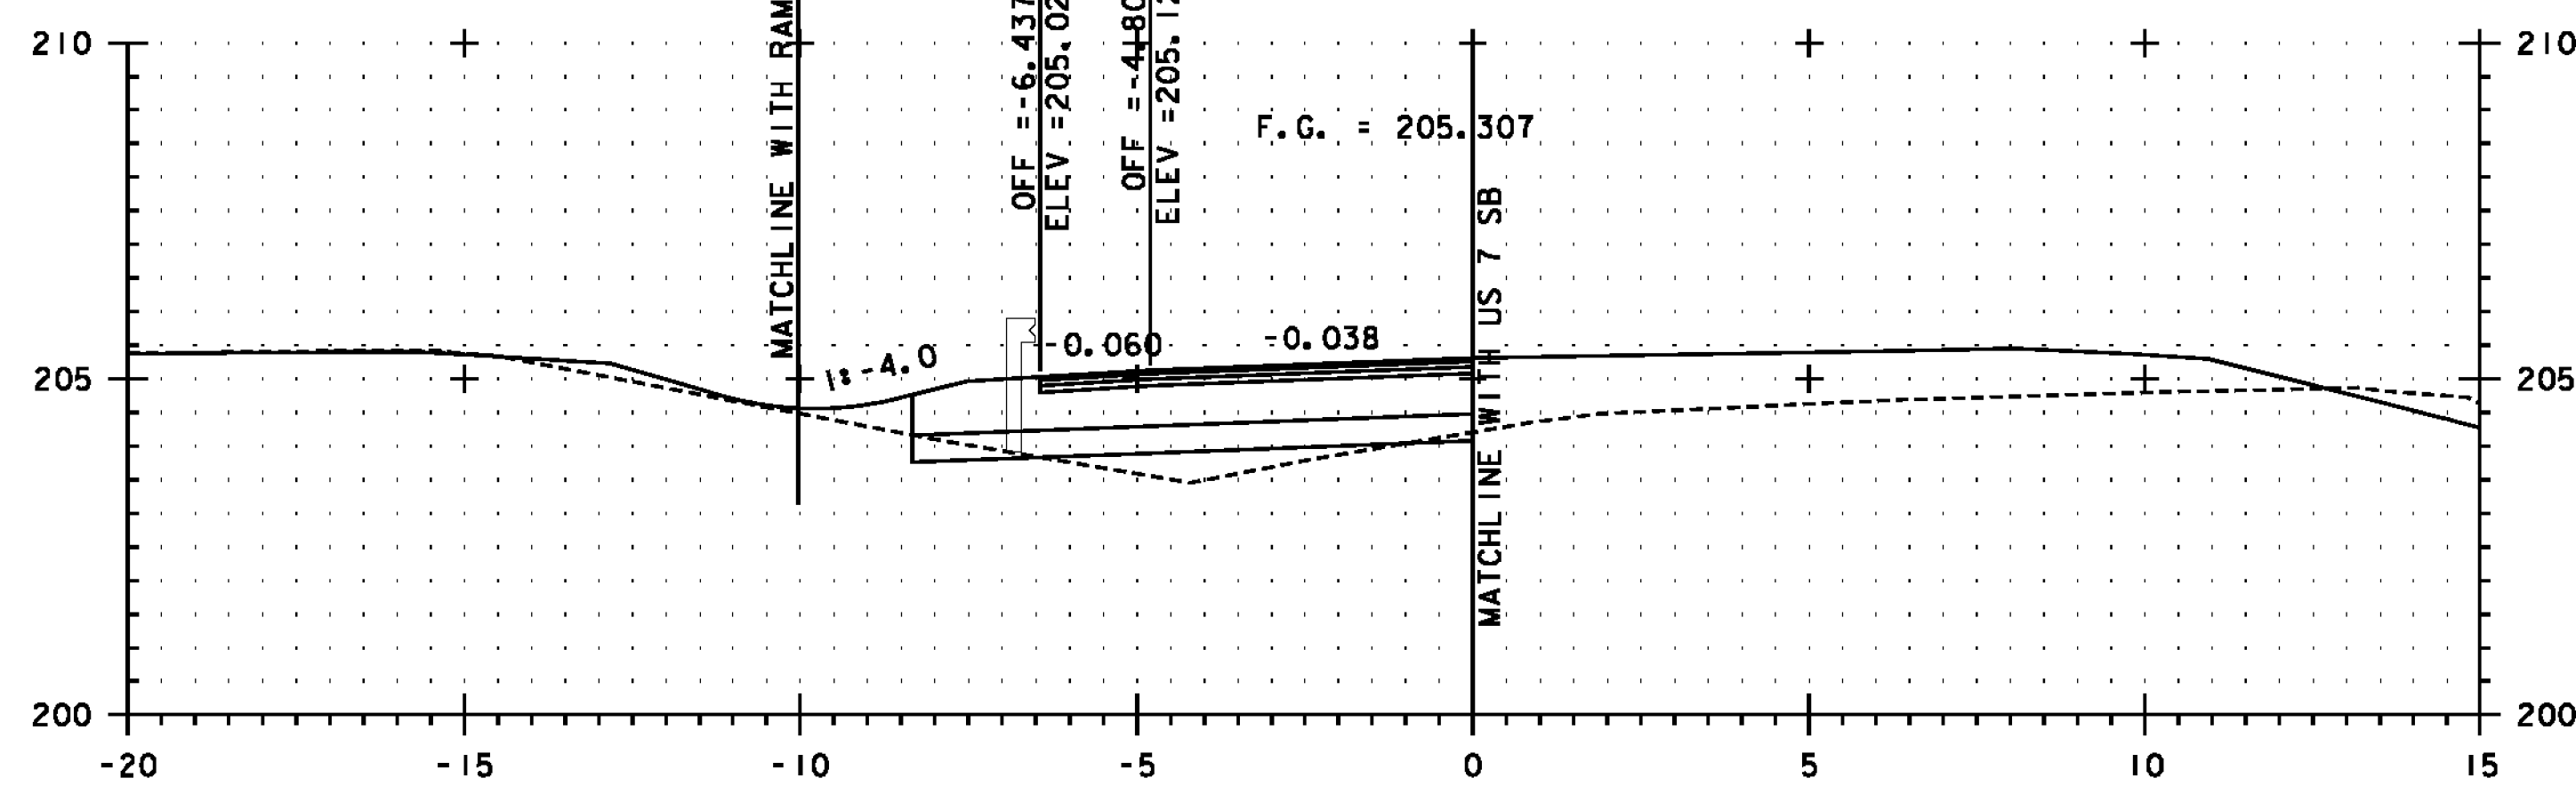

S 1+080

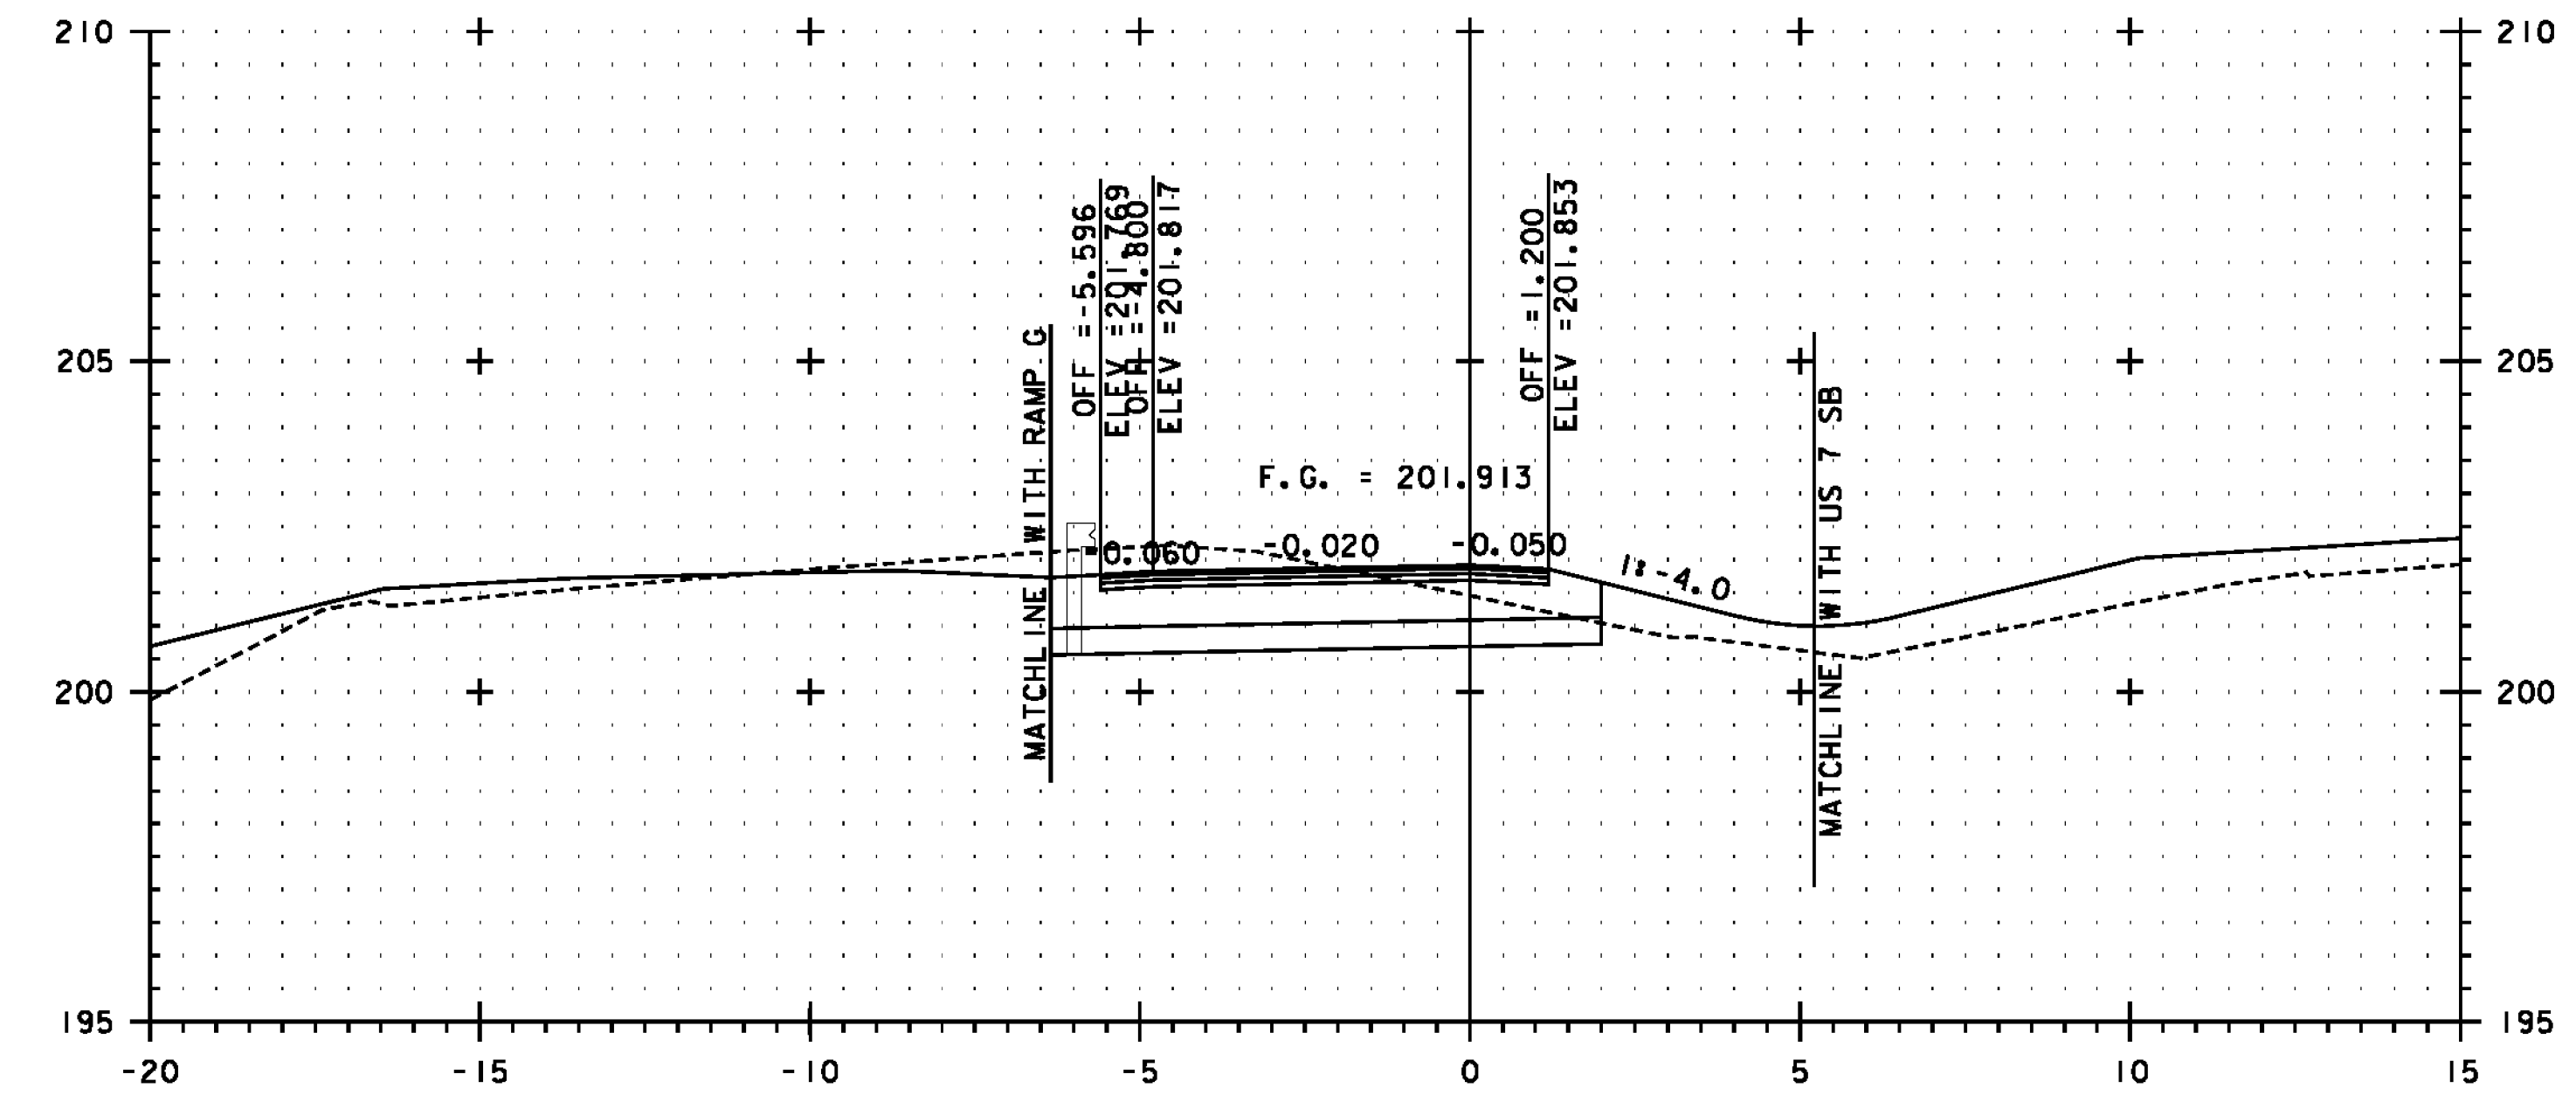


S 1+160

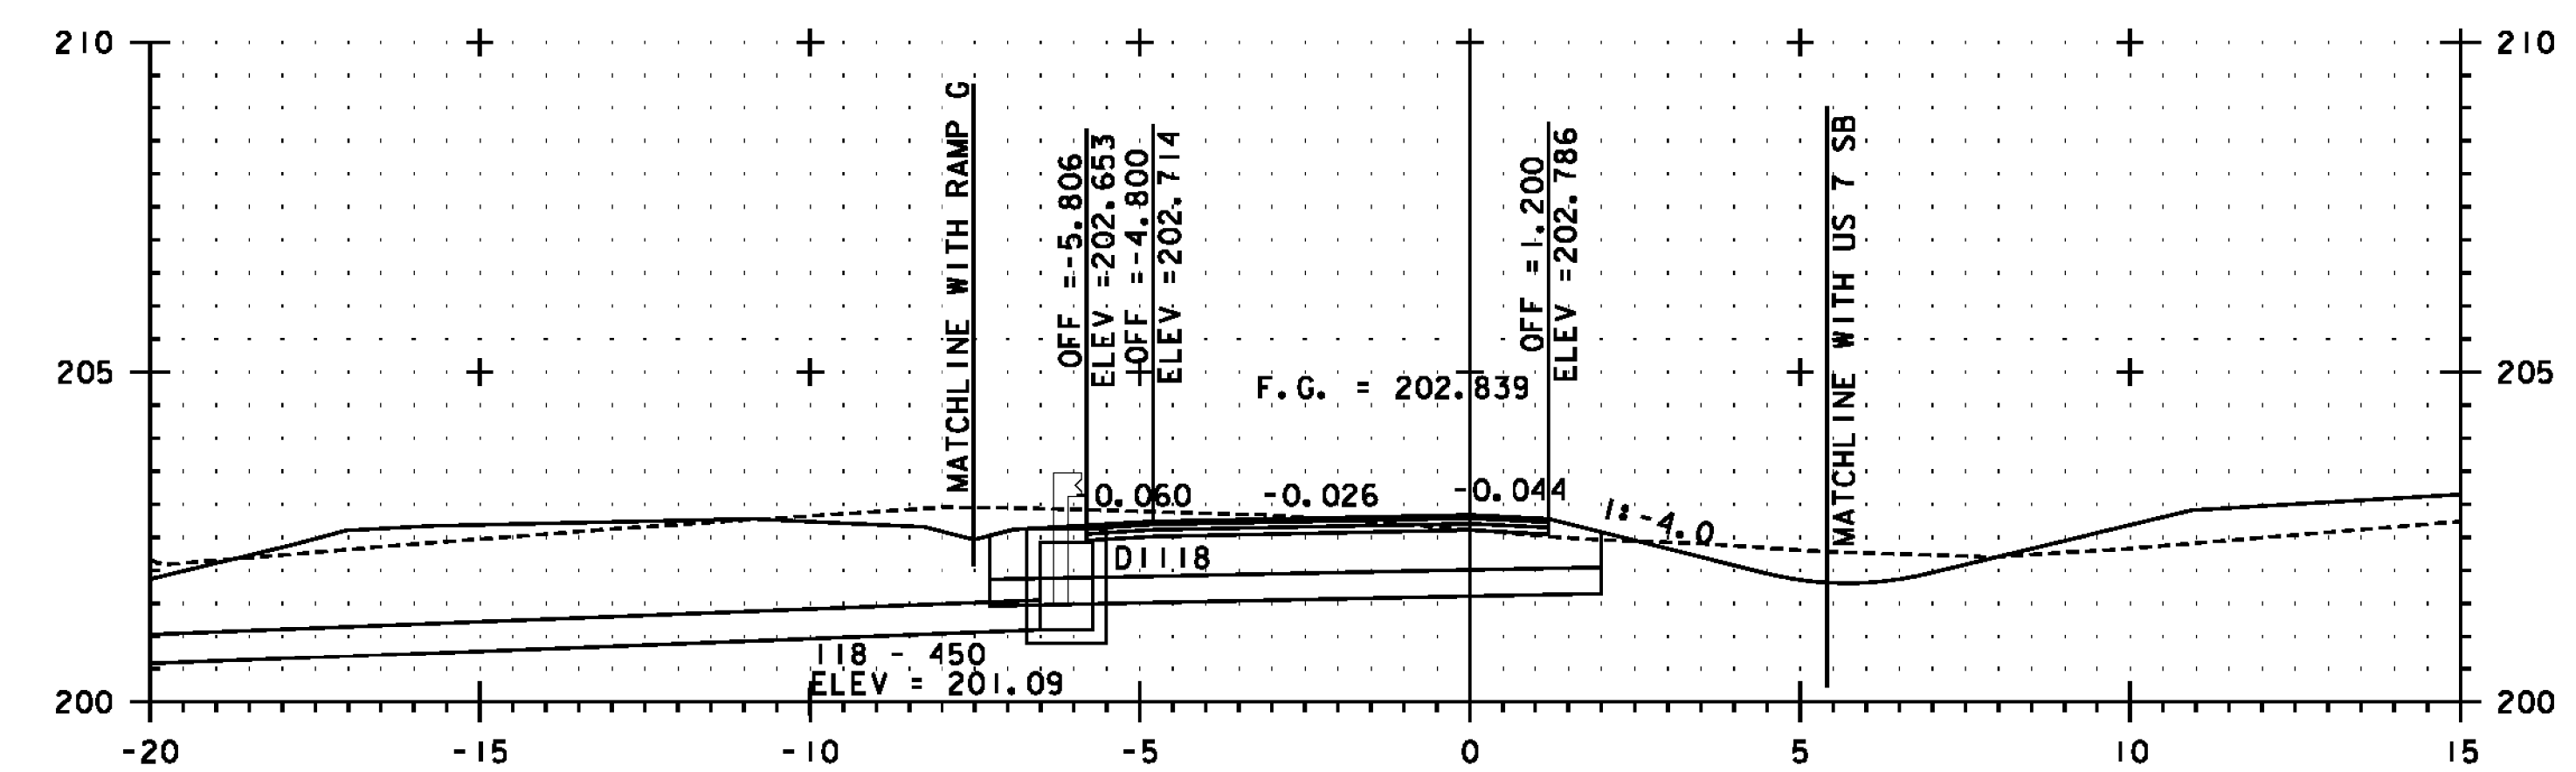

S 1+140

SEE NOTE ON SHEET 407

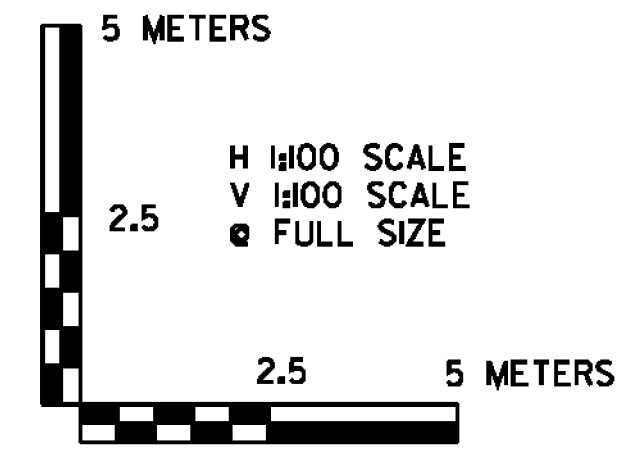

|                      |                                   |
|----------------------|-----------------------------------|
| PROJECT NAME:        | BENNINGTON                        |
| PROJECT NUMBER:      | NH 019-(154)                      |
| FILE NAME:           | ...plot_files\zd307c4xs.rampS.ptf |
| DESIGN SUPERVISOR:   | GREG EDWARDS                      |
| DESIGNED BY:         | MARC FOISY                        |
| RAMP S CROSS SECTION | SXS-02                            |
| PLOT DATE:           | 1/26/2010                         |
| DRAWN BY:            | STANTEC                           |
| CHECKED BY:          | GARY SANTY                        |
| SHEET                | 408 OF 468                        |

1/26/2010 4:57:53 PM v:\1953\getlive\19530002\trampS\plot\_files\zd307c4xs.rampS.ptf