


S 2+080



S 2+060

SEE NOTE ON SHEET 407

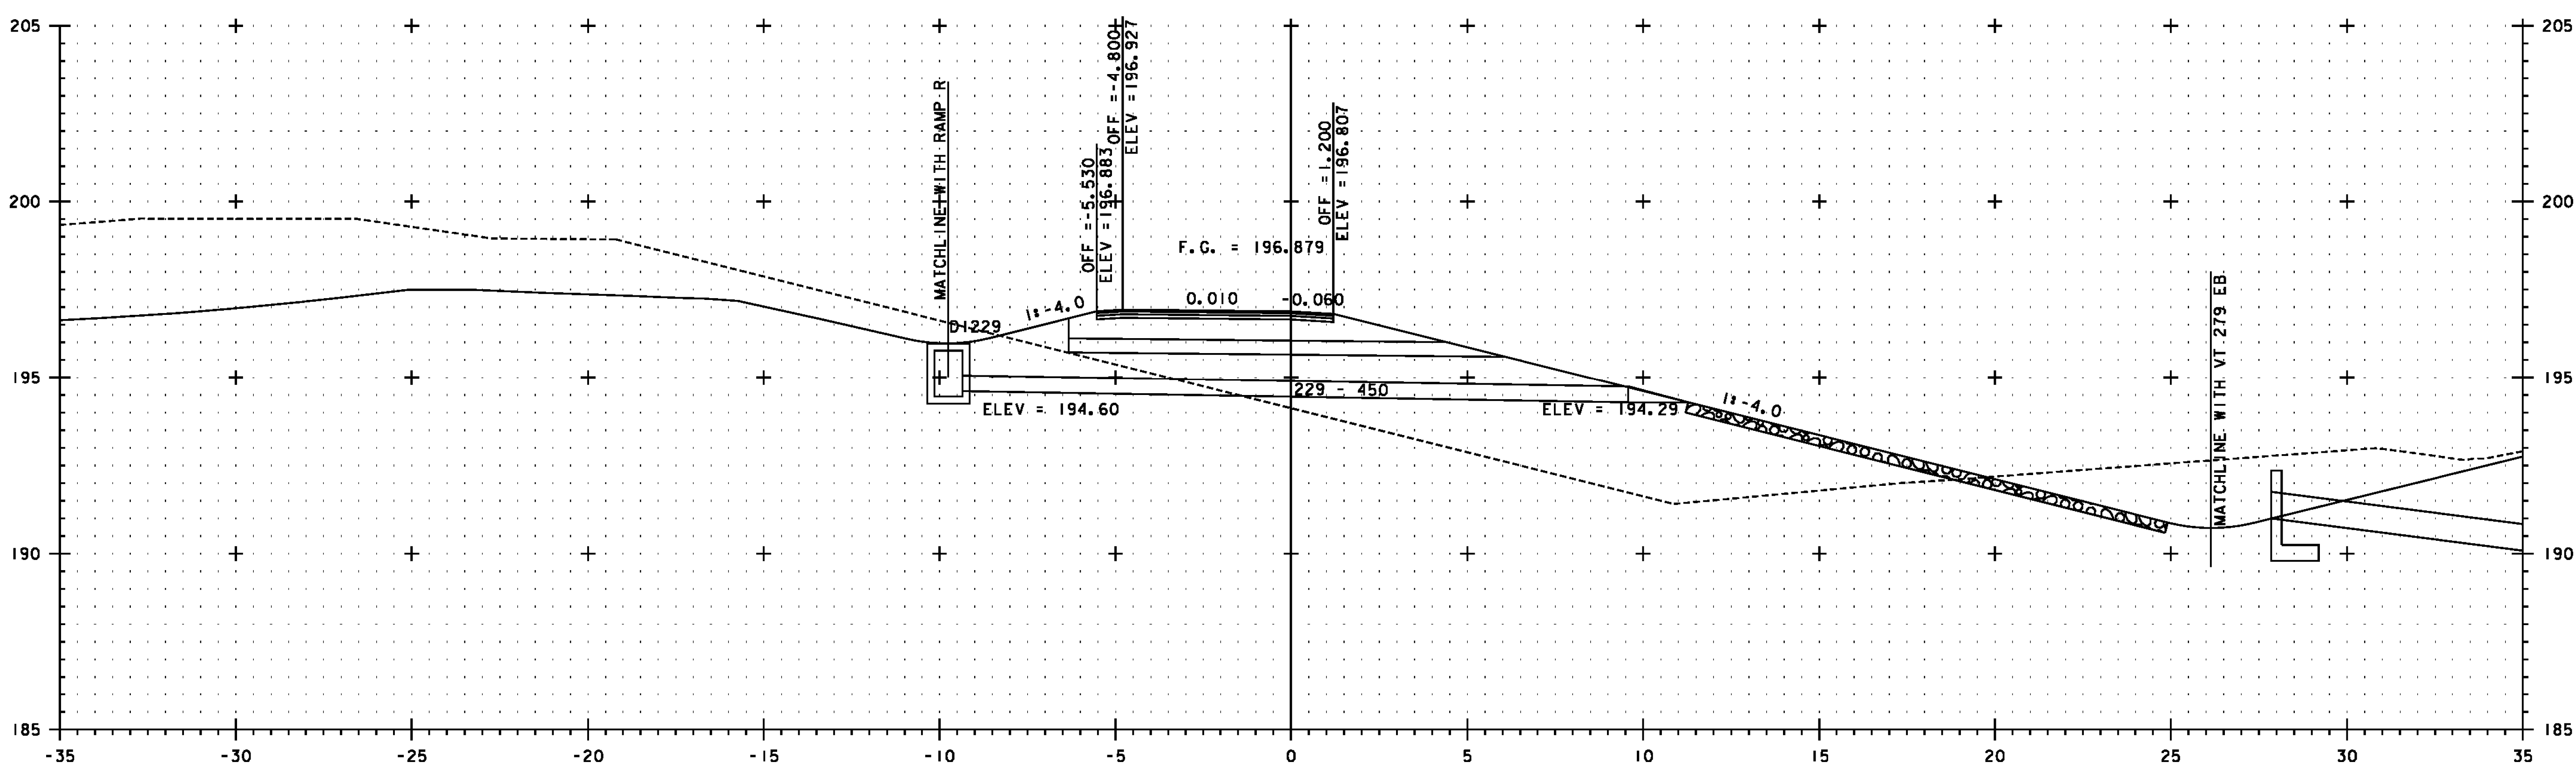

SEE REVISED SECTION FOR SL-7I	
PROJECT NAME:	BENNINGTON
PROJECT NUMBER:	NH 019-(154)
FILE NAME:	...plot_files\zd307c4xs.ramp5.ptf
DESIGN SUPERVISOR:	GREG EDWARDS
DESIGNED BY:	MARC FOISY
DRAWN BY:	STANTEC
CHECKED BY:	GARY SANTY
RAMP 5 CROSS SECTION	SXS-05
	SHEET 411 OF 468
PLOT DATE:	1/26/2010

1/26/2010 4:57:57 PM v:\1953\active\1953\002\tr\anspor\station\dr\wng\comp\tr\cpt\_4\plot\_files\zd307c4xs.ramp5.ptf