



RECORD PLANS

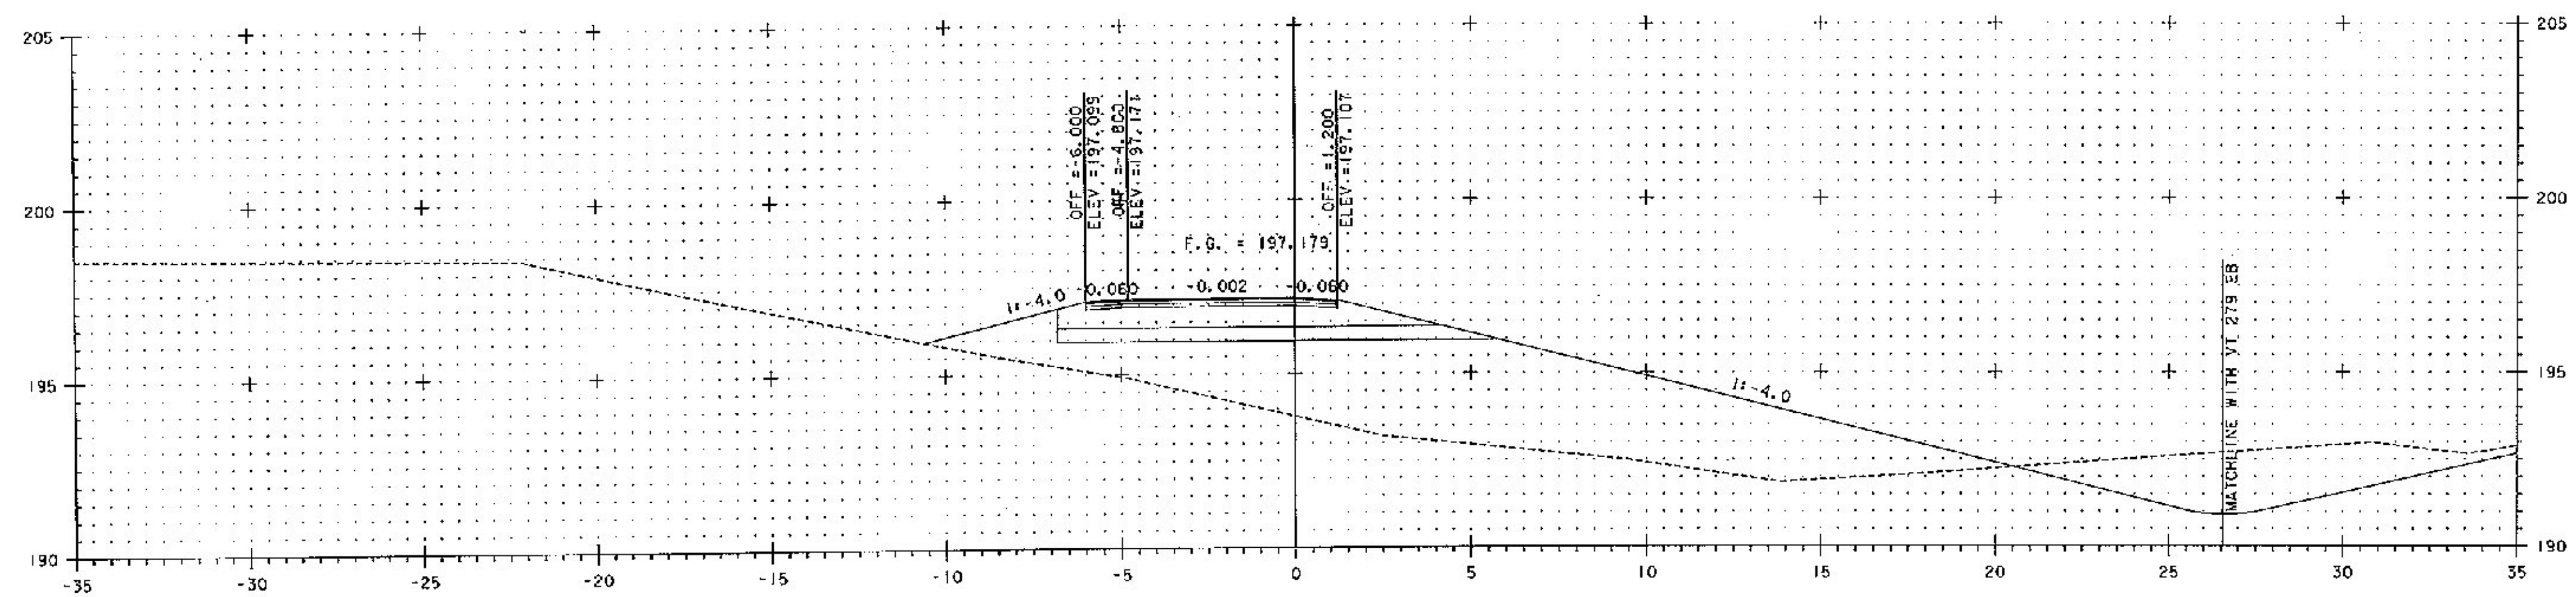


S 2+080

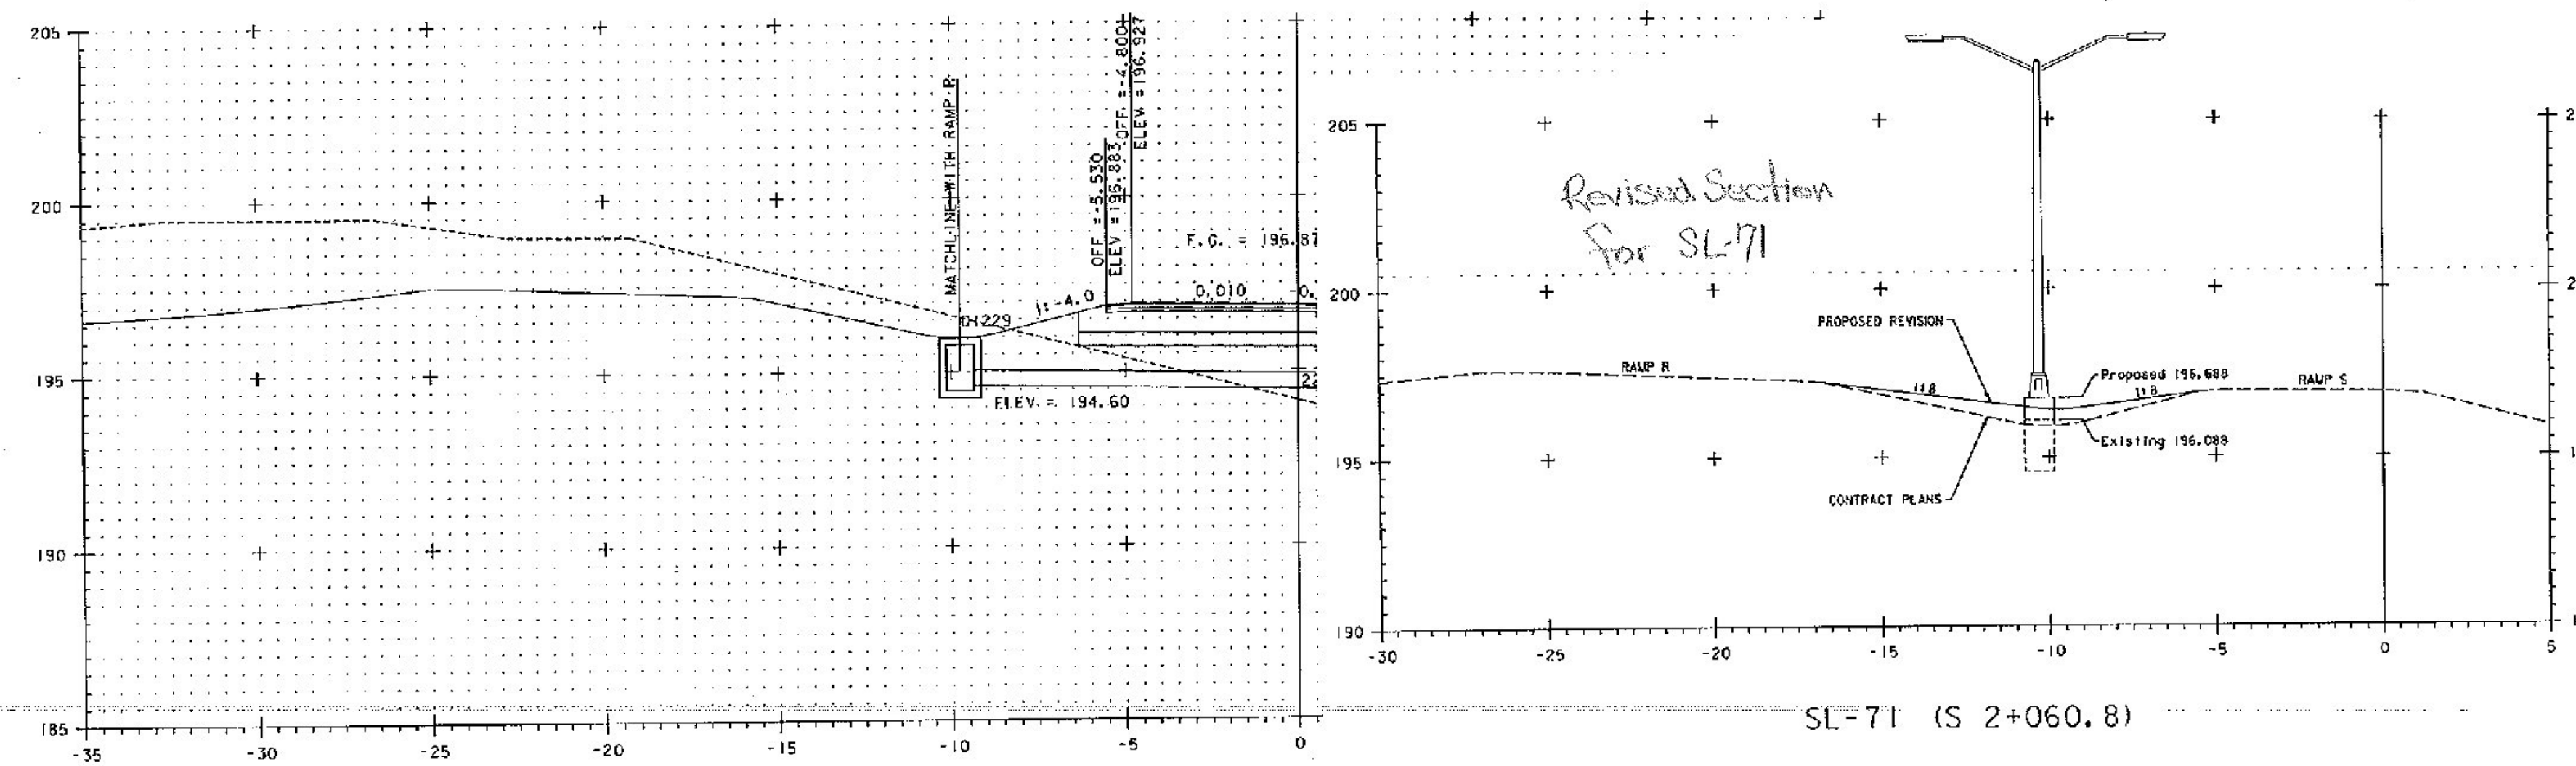

SL-71 (S 2+060.8)

S 2+060

See Note on
Sheet 407

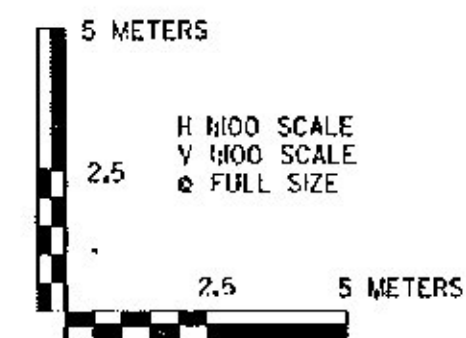

PROJECT NAME: BENNINGTON
PROJECT NUMBER: NH 019-1(54)

FILE NAME: ...plot_files\zd307c4xs_ramp5.pptf PLOT DATE: 1/26/2010
DESIGN SUPERVISOR: GREG EDWARDS DRAWN BY: STANTEC
DESIGNED BY: MARC FOISY CHECKED BY: GARY SANTY
RAMP 5 CROSS SECTION 5X5-05 SHEET 4# OF 46#