


S 2+083.724

SEE NOTE ON SHEET 407

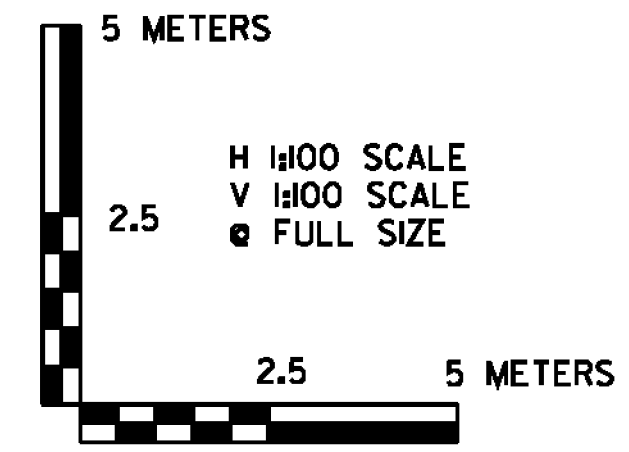

PROJECT NAME:	BENNINGTON
PROJECT NUMBER:	NH 019-(154)
FILE NAME:	...\\plot_files\zd307c4xs.ramp5.ptf
DESIGN SUPERVISOR:	GREG EDWARDS
DESIGNED BY:	MARC FOISY
DRAWN BY:	STANTEC
CHECKED BY:	GARY SANTY
RAMP 5 CROSS SECTION	SXS-06
PLOT DATE:	1/26/2010
	SHEET 412 OF 468

1/26/2010 4:57:58 PM v:\1953\active\1953\0002\transportation\drawing\control\cpl_4\plot_files\zd307c4xs.ramp5.ptf