



T 1+020

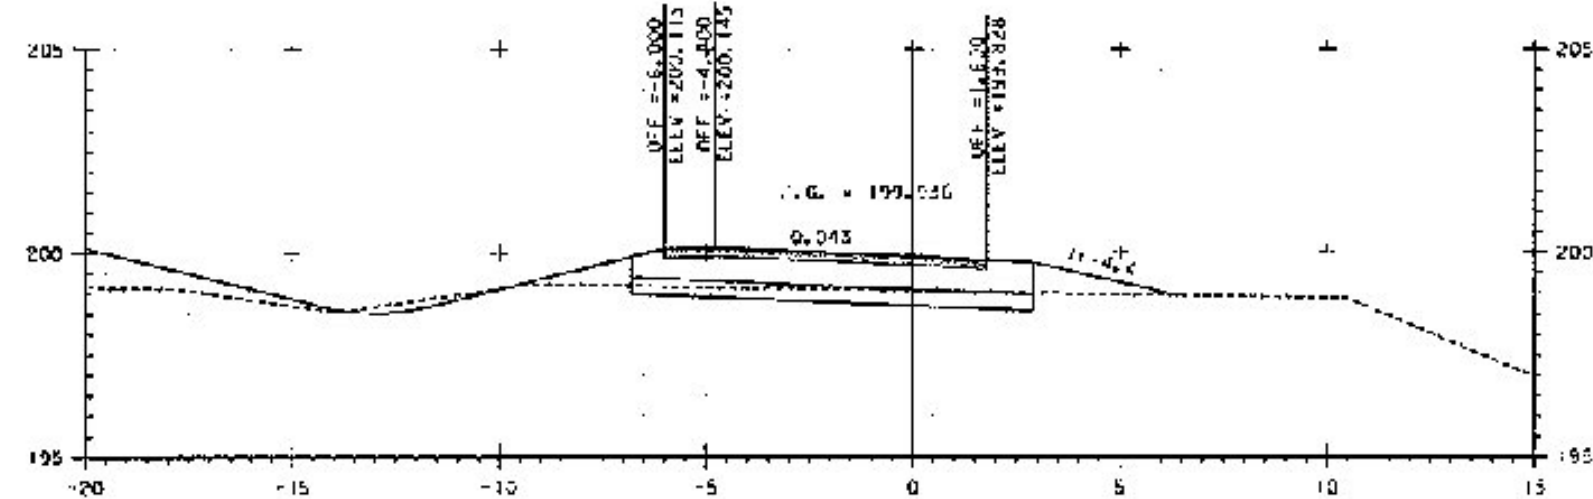

T 1+000

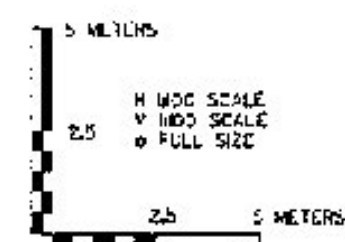

PROJECT NAME: BENNINGTON
PROJECT NUMBER: NH C/S-1(54)
FILE NUMBER: \\server\proj\1020\4444\1020.dwg PLOT DATE: 10/24/2011
DESIGN SUPERVISOR: GREG EDWARDS DRAWN BY: STANTEC
DESIGNED BY: MARC FOIS CHECKED BY: DARY SANTY
RAMP 1 CROSS SECTION SHEET 1 OF 1

REVISED