




F 1+407.656 / T 1+000.000

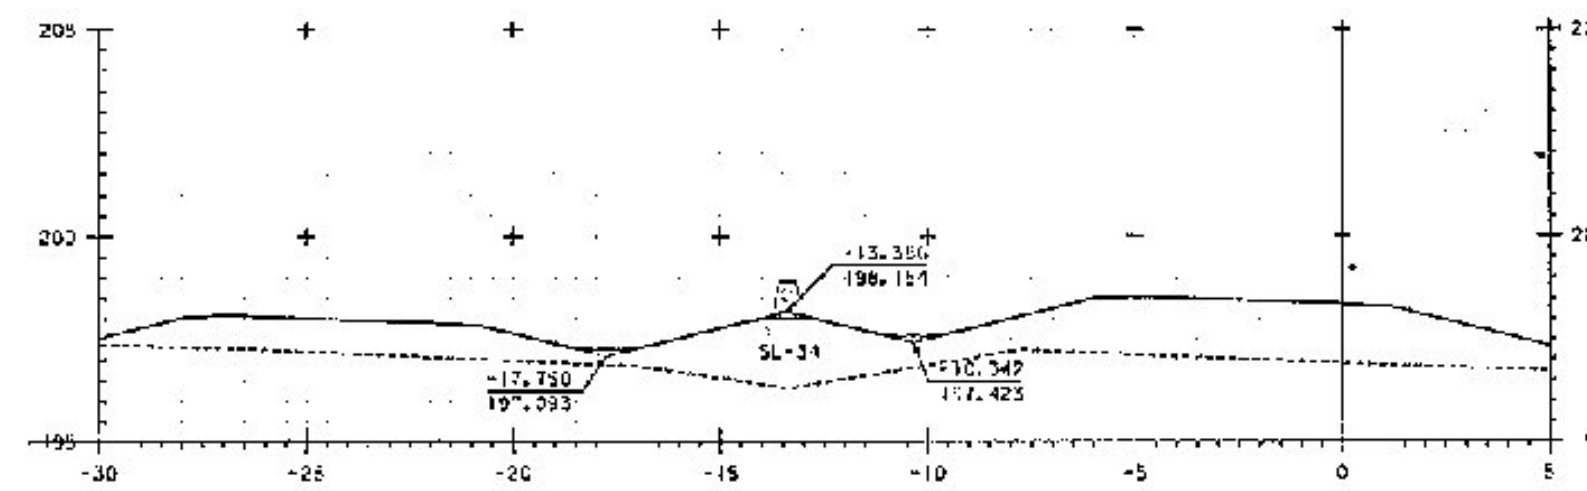


T 1+057.687

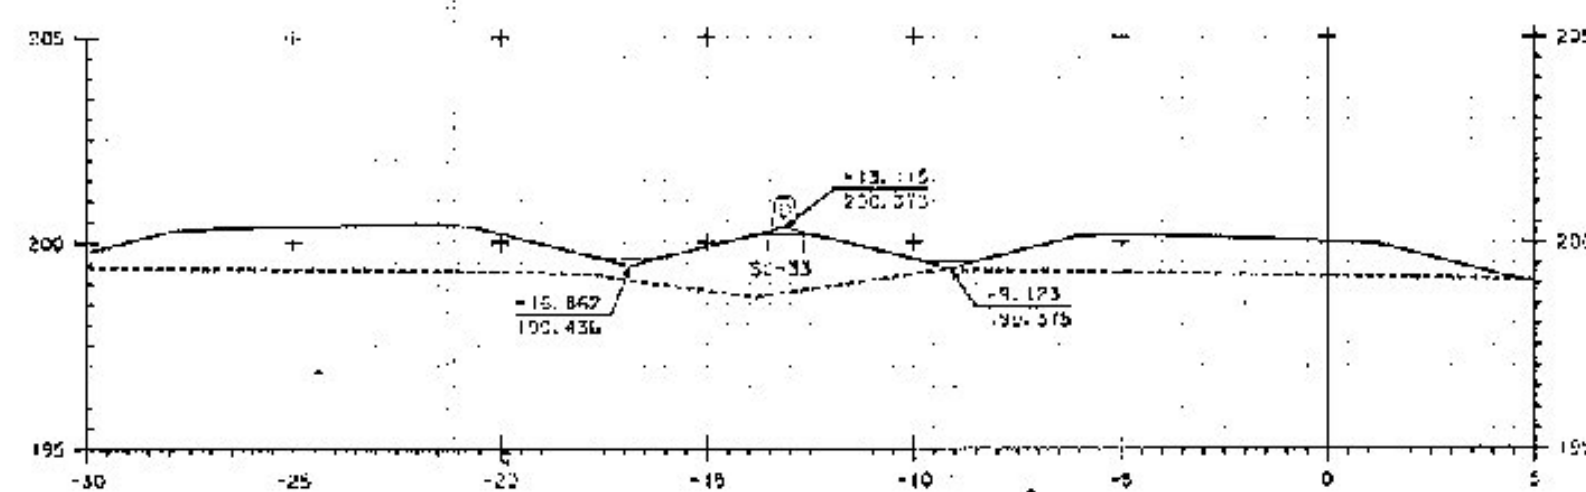


F 1+405

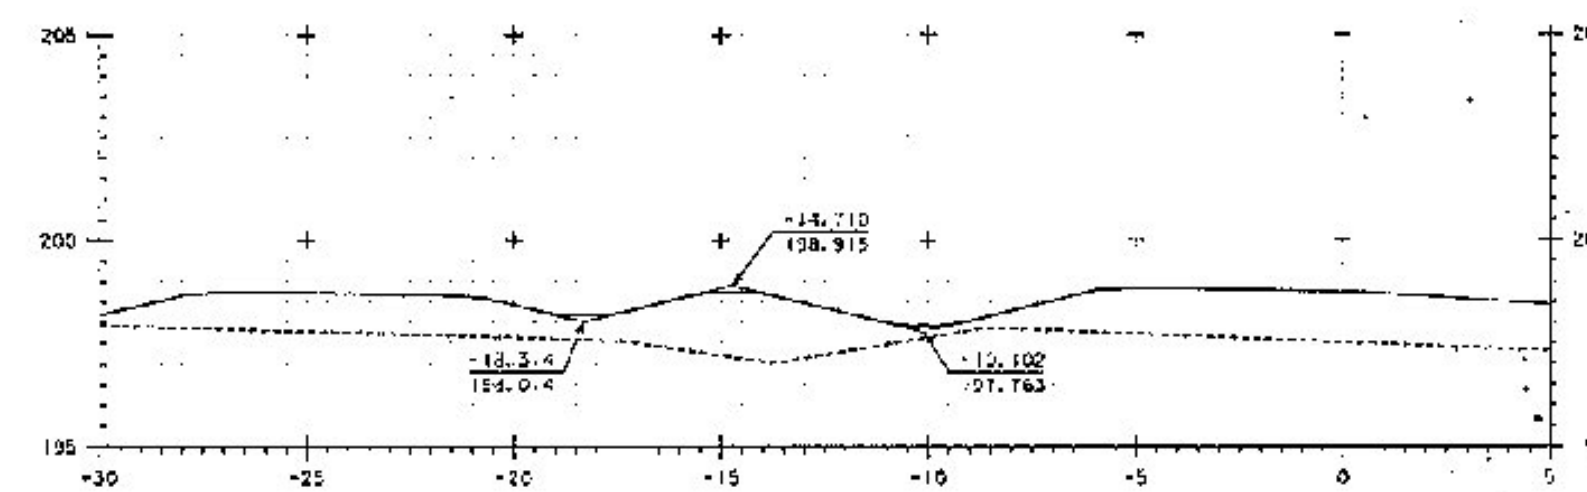

T 1+040

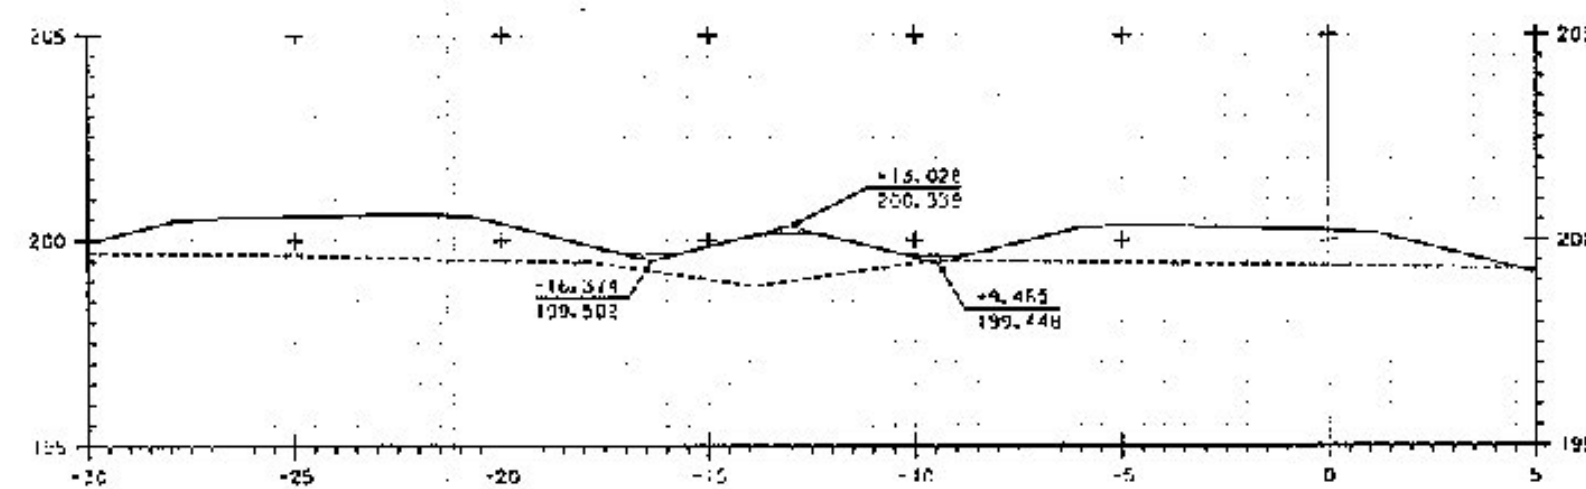

F 1+400

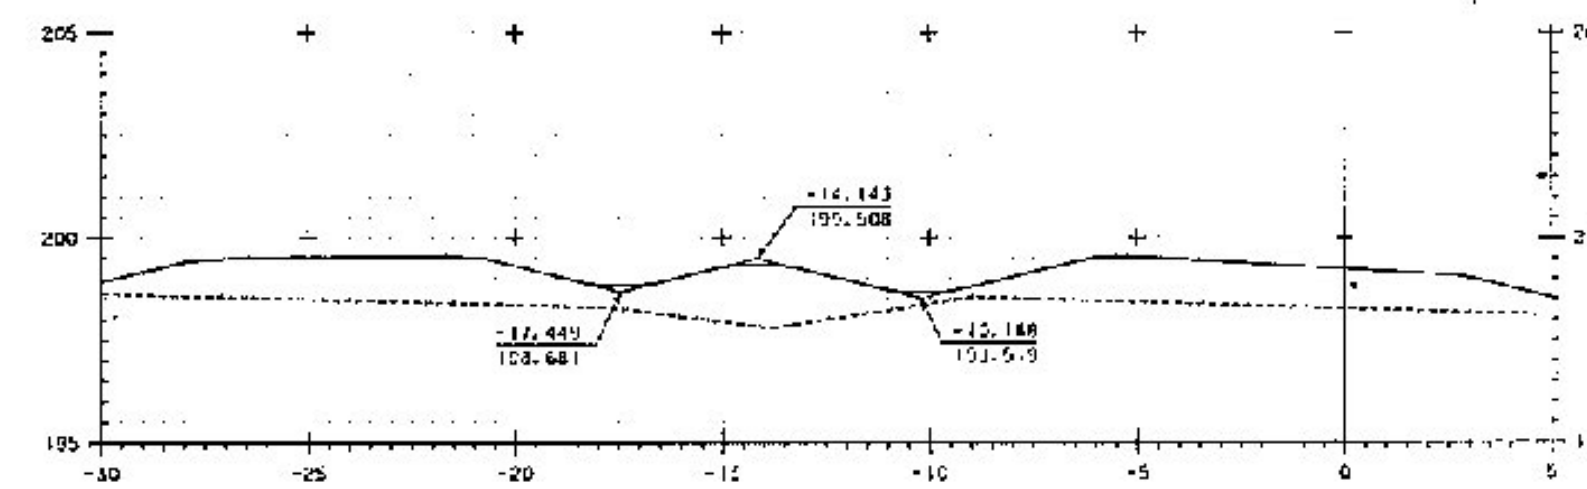

T 1+020

LIGHT POLE
RECORD PLANS