




T 1+080

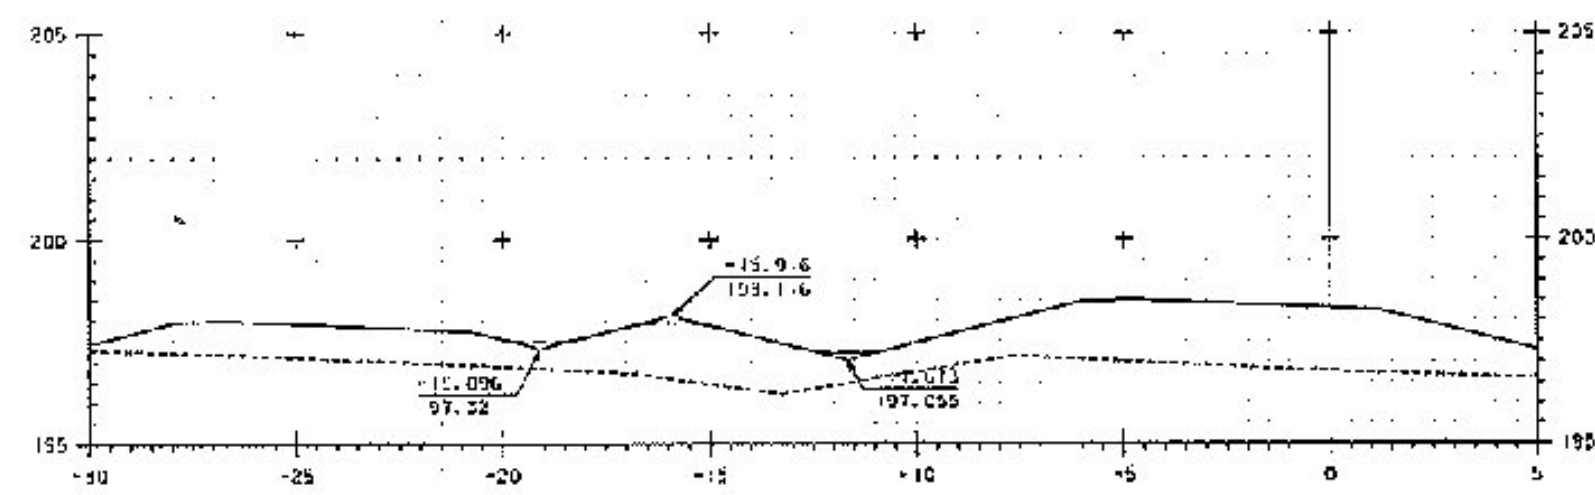


T 1+060

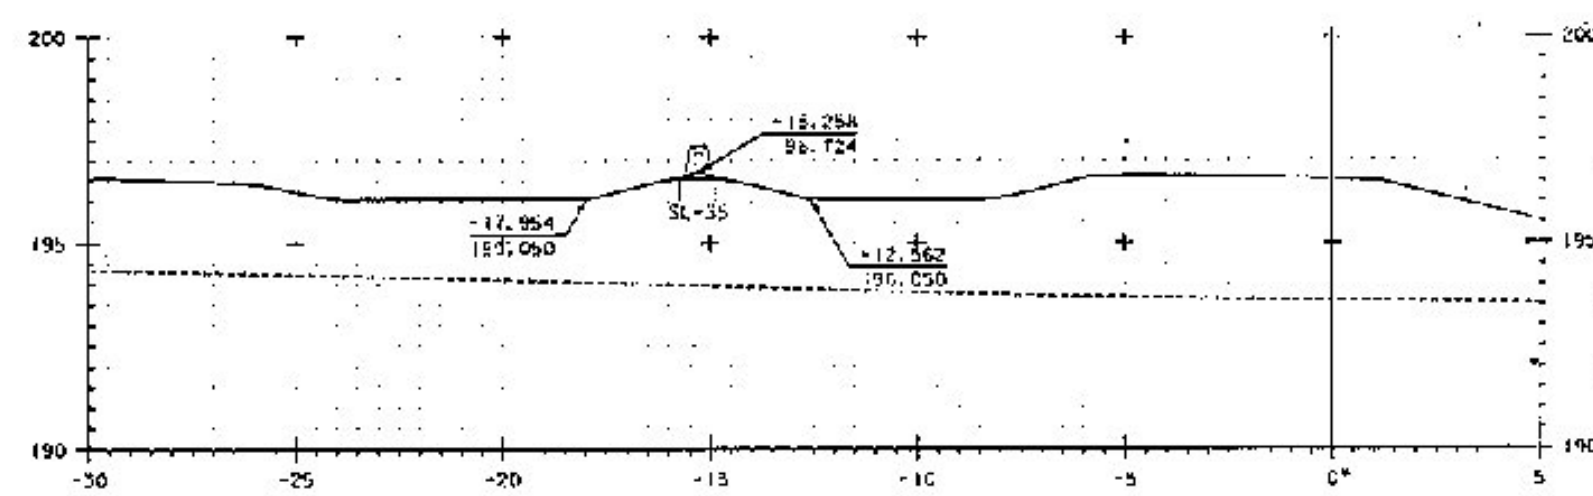

T 1+116

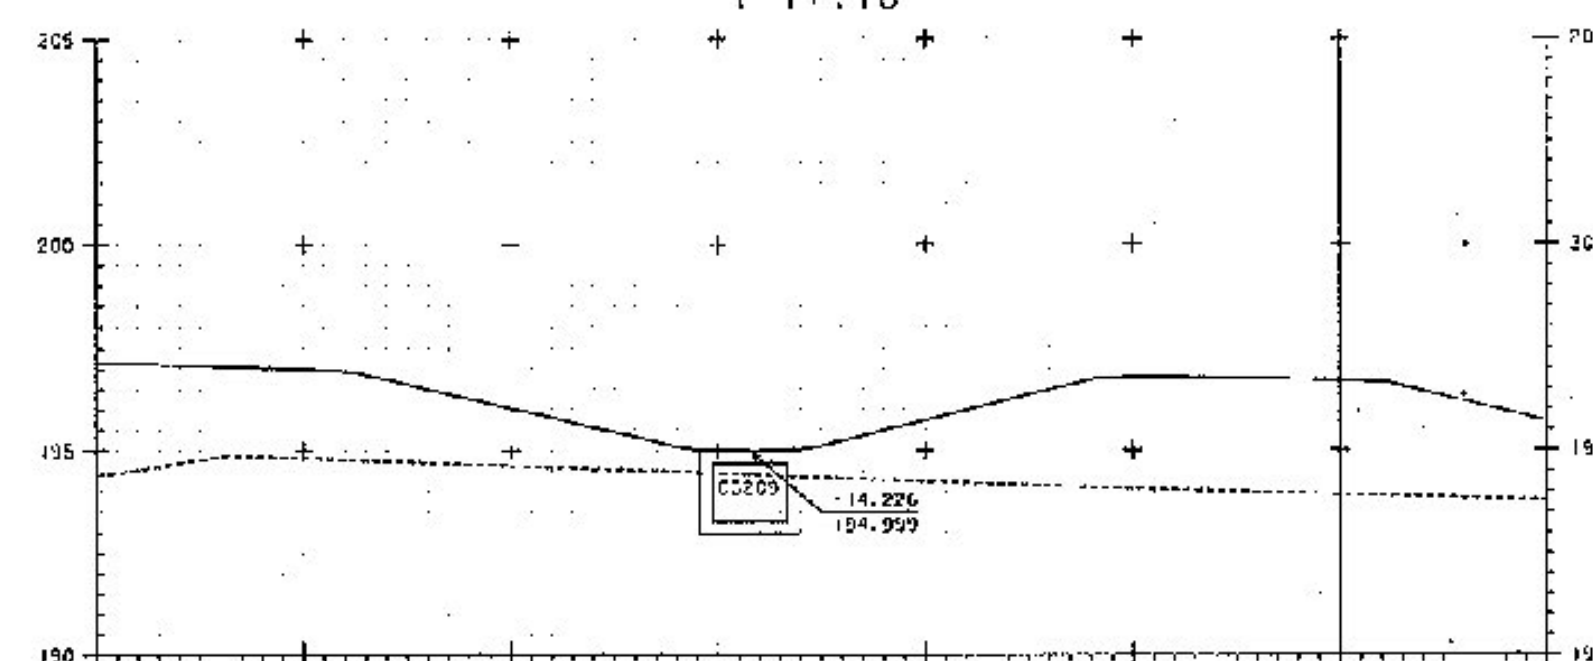

T 1+112.019

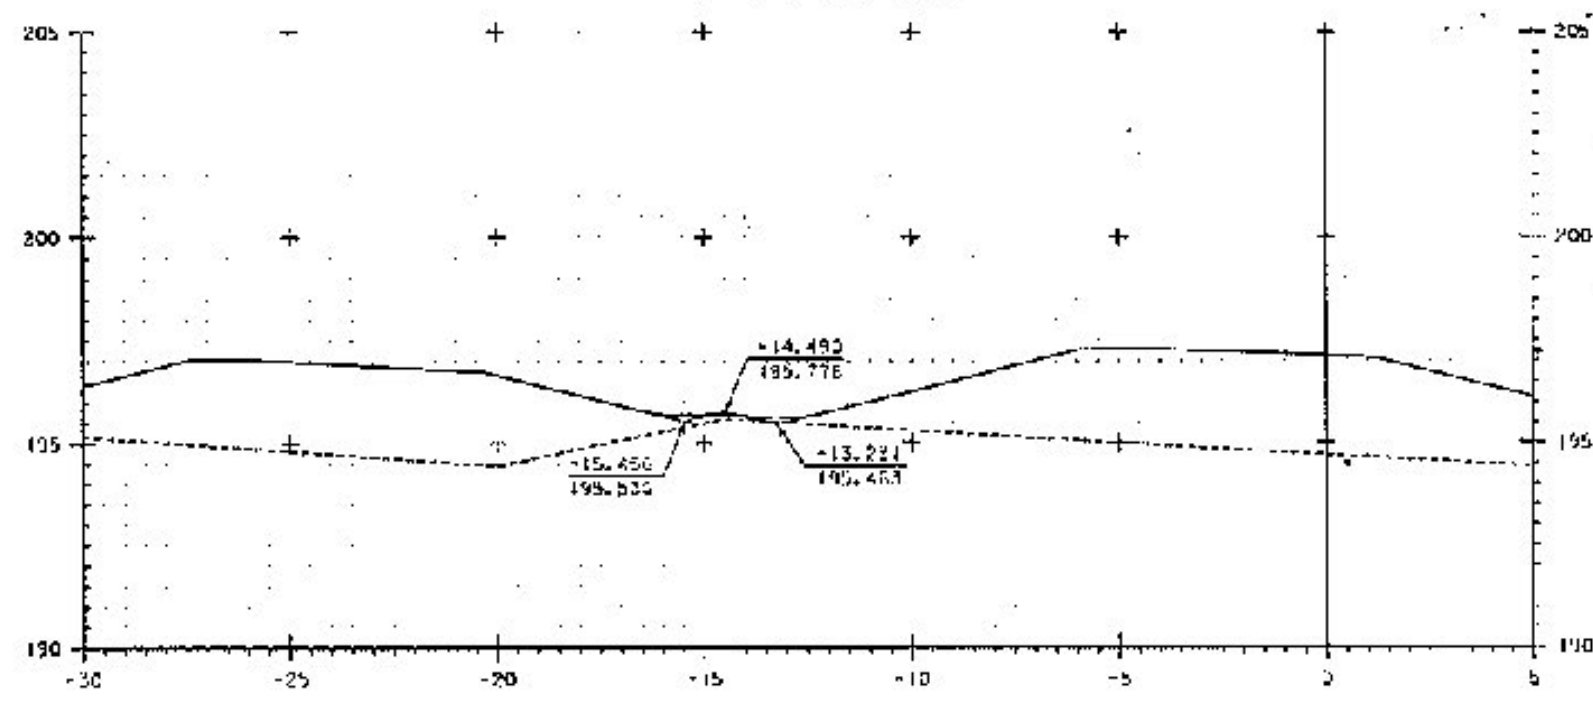

T 1+100

LIGHT REE.
RECORD PLANS