




U I+100

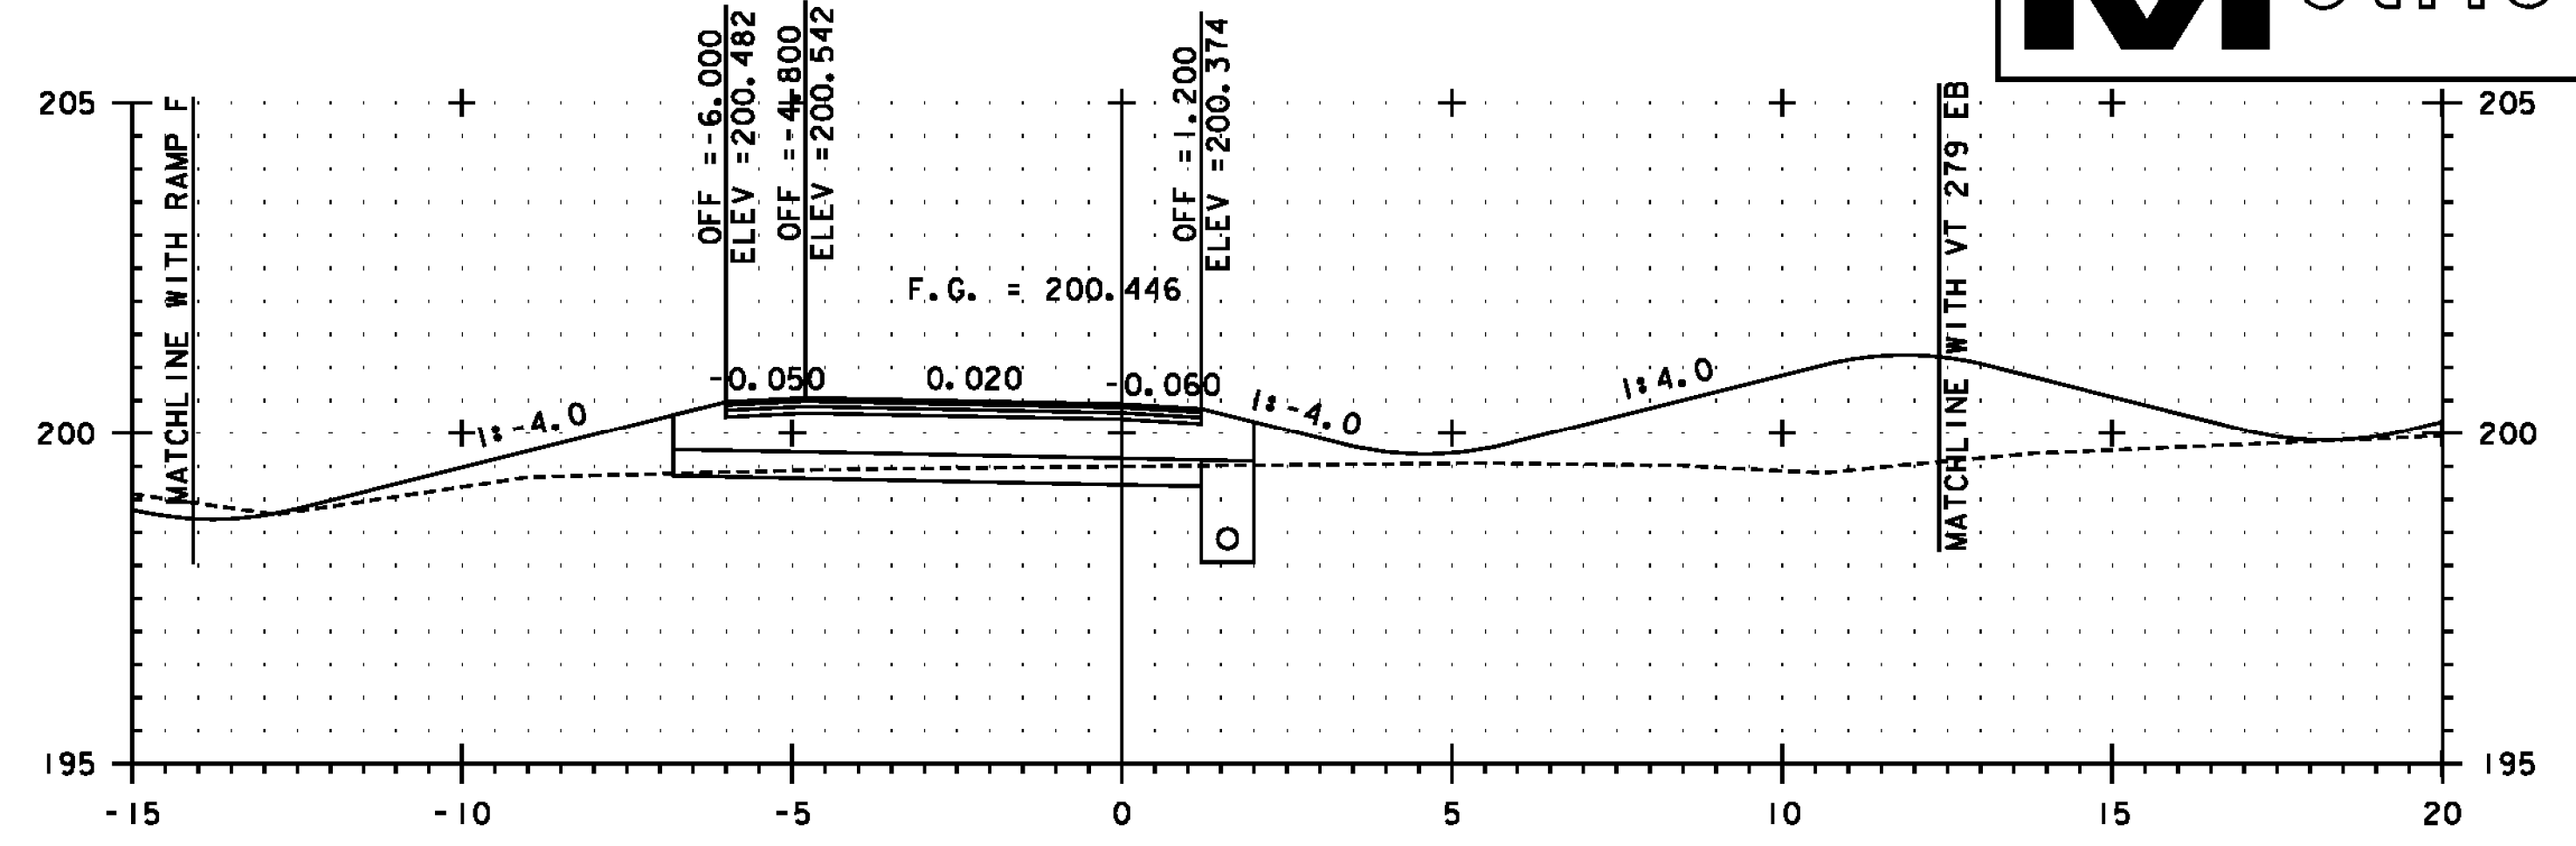


U I+160

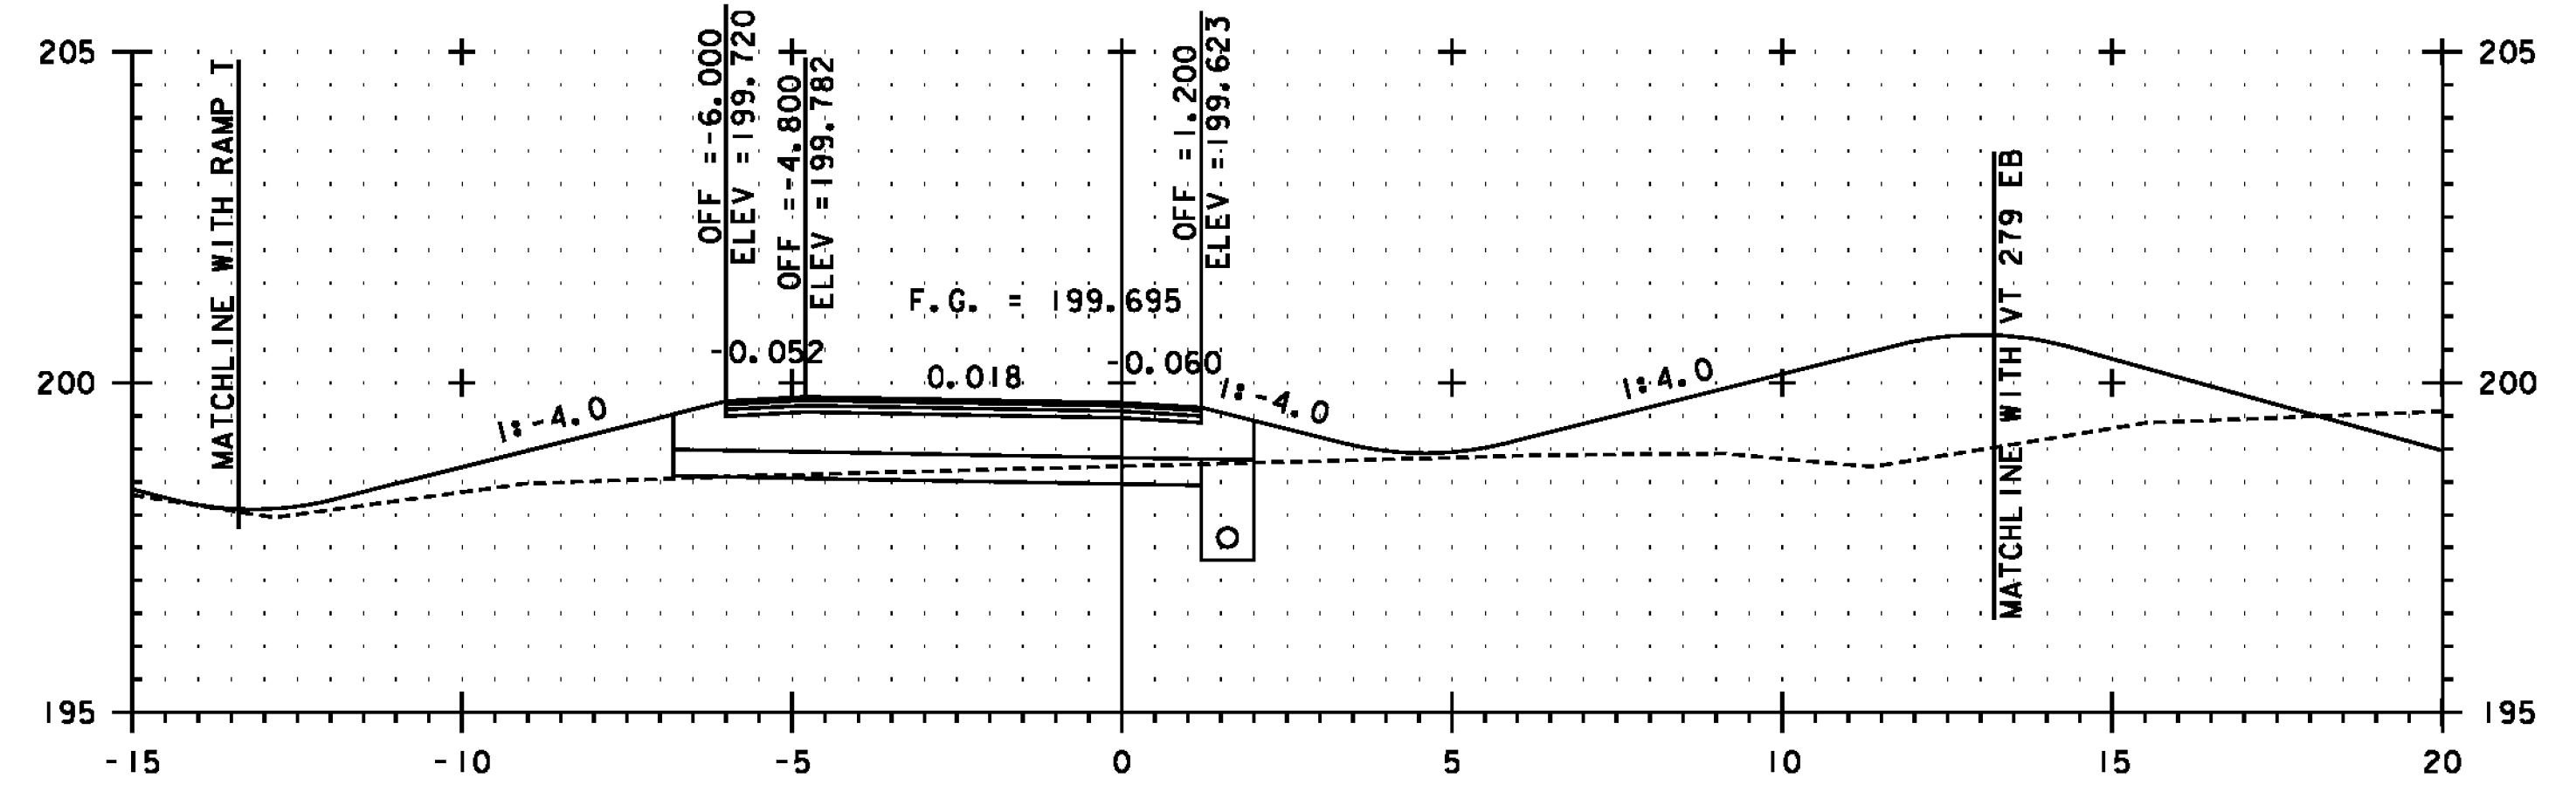

U I+140

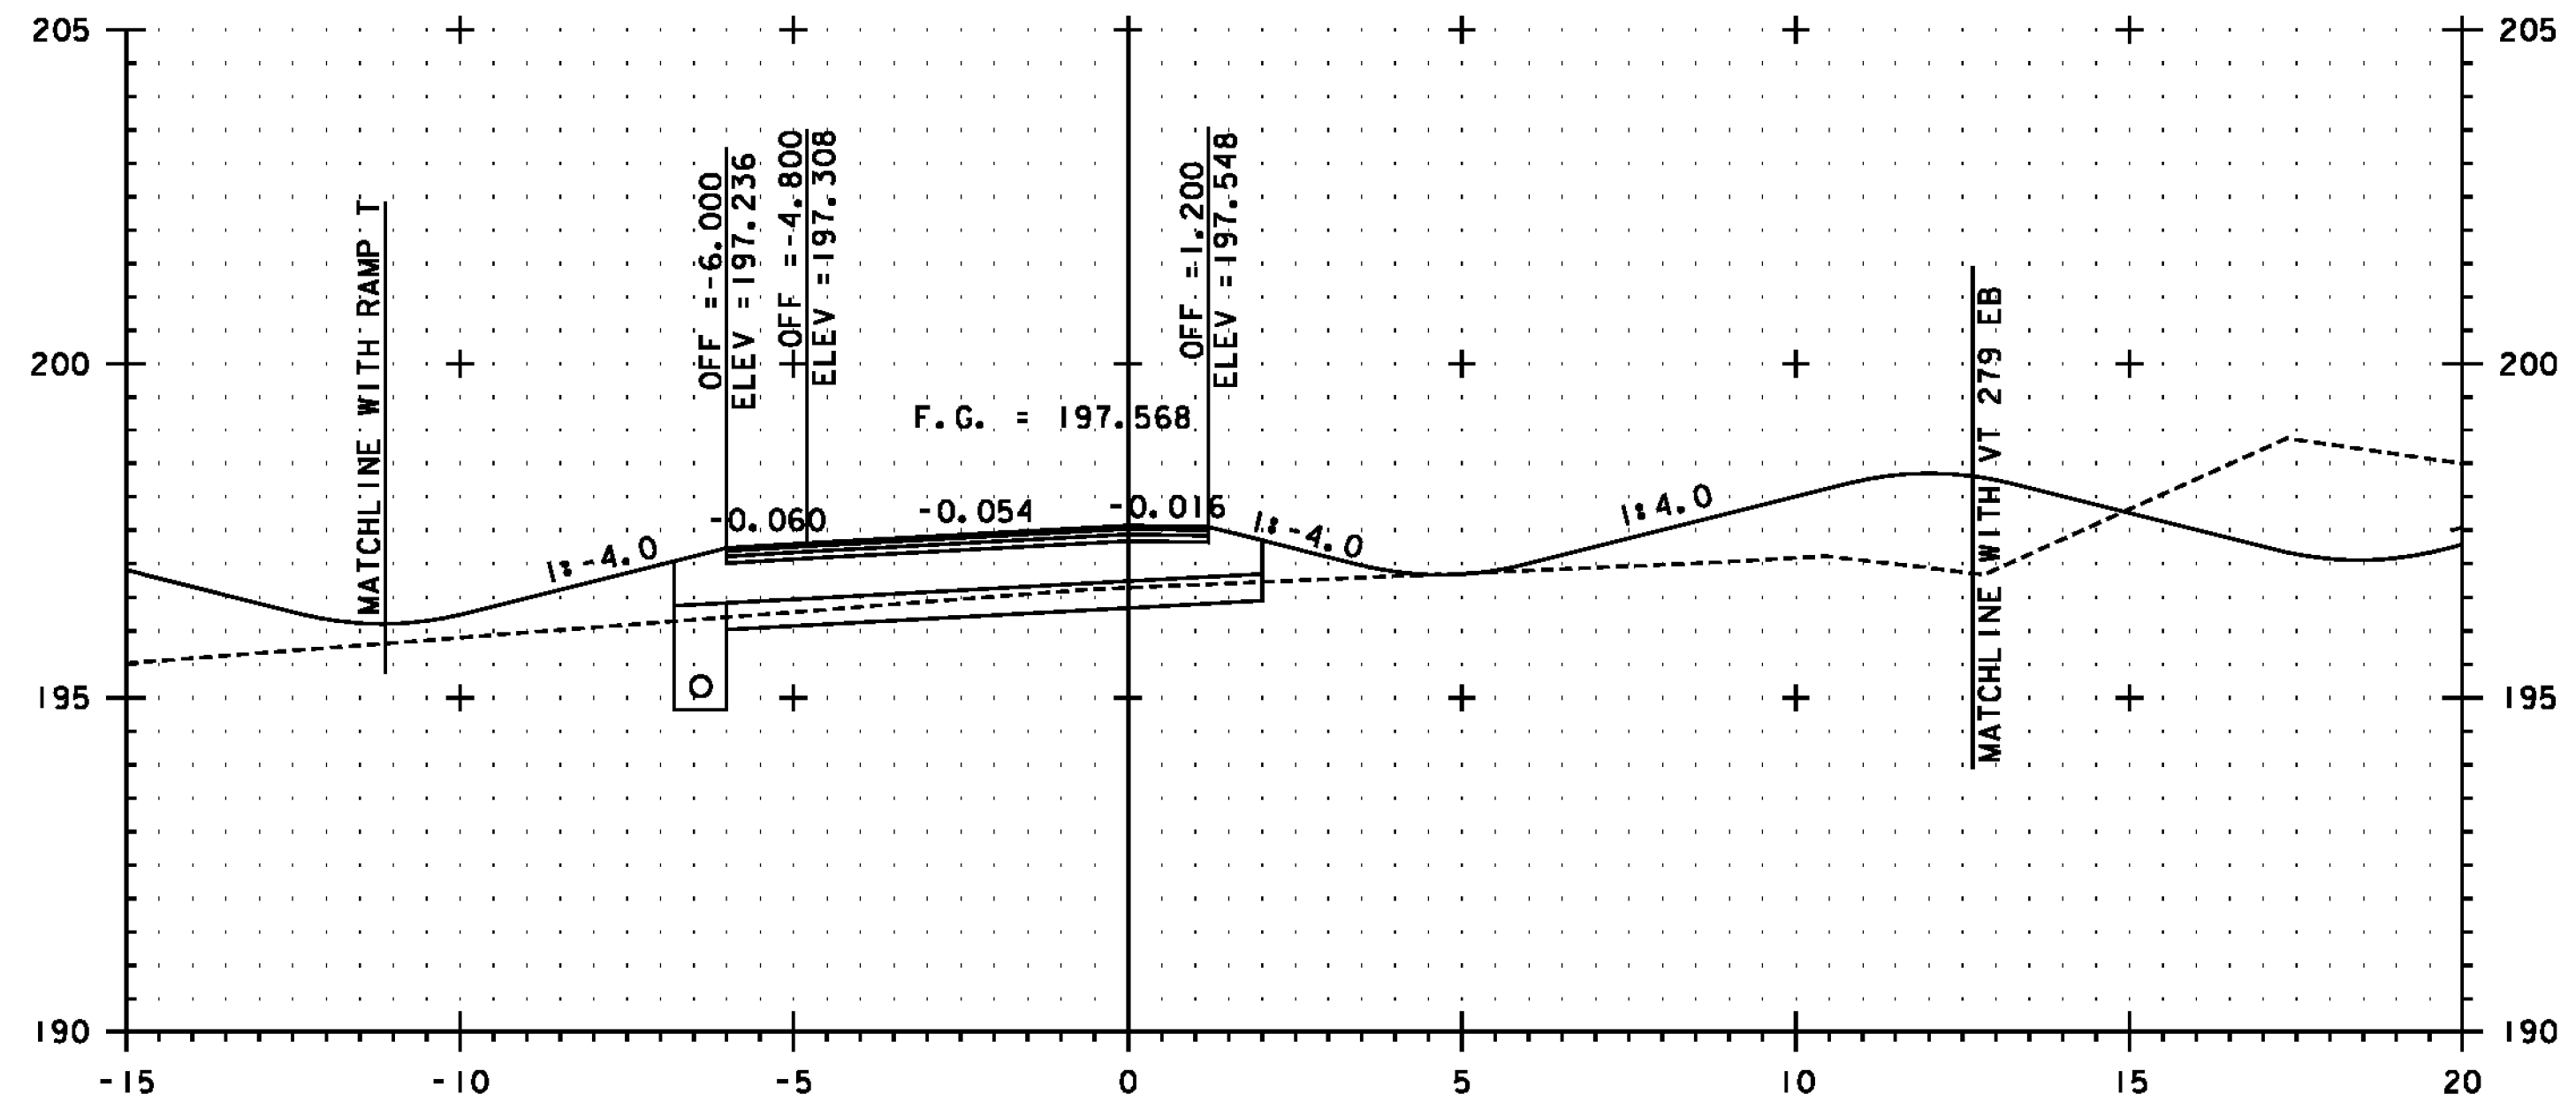


U I+080

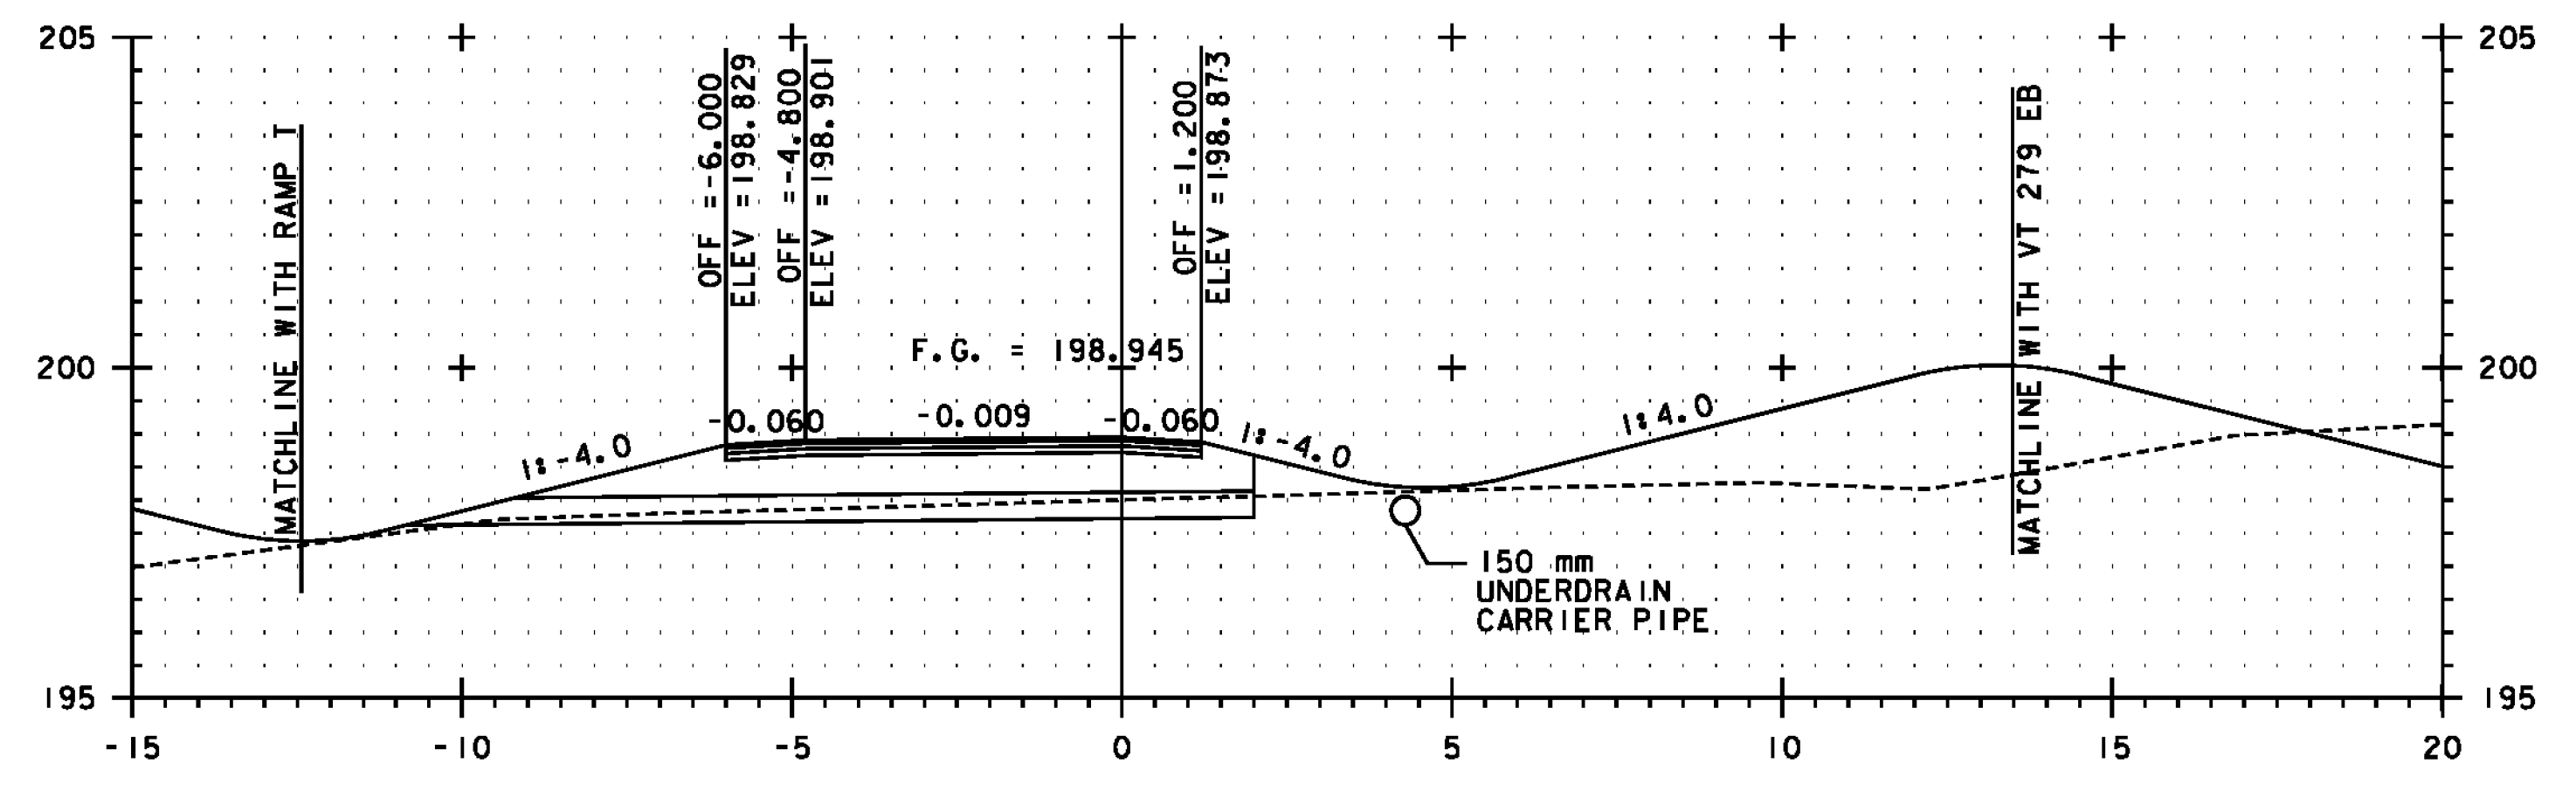

U I+120

SEE NOTE ON SHEET 415

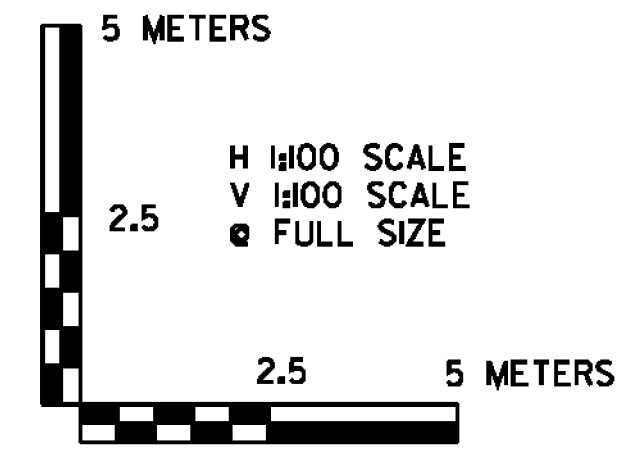

PROJECT NAME:	BENNINGTON
PROJECT NUMBER:	NH 019-(154)
FILE NAME:	...plot_files\zd307c4xs.rampU.ptf
DESIGN SUPERVISOR:	GREG EDWARDS
DESIGNED BY:	MARC FOISY
RAMP U CROSS SECTION UXS-02	
PLOT DATE:	1/26/2010
DRAWN BY:	STANTEC
CHECKED BY:	GARY SANTY
SHEET	416 OF 468

1/26/2010 4:58:03 PM v:\1953\getlive\19530002\transport\station\drw\mg\com\tr\cpt_4\plot_files\zd307c4xs.rampU.ptf