


SEE NOTE ON SHEET 415

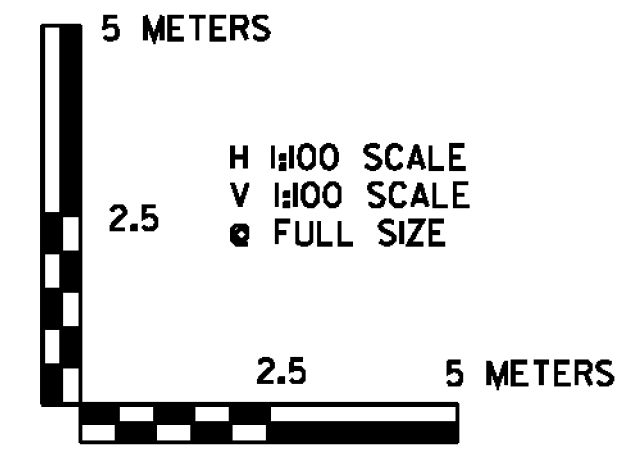

PROJECT NAME:	BENNINGTON
PROJECT NUMBER:	NH 019-(154)
FILE NAME:	...plot_files\zd307c4xs.rampU.ptf
PLOT DATE:	1/26/2010
DESIGN SUPERVISOR:	GREG EDWARDS
DRAWN BY:	STANTEC
DESIGNED BY:	MARC FOISY
CHECKED BY:	GARY SANTY
RAMP U CROSS SECTION UXS-04	SHEET 418 OF 468

1/26/2010 4:58:06 PM v:\1953\getlive\19530002\transportation\drw\mg\com\tr\cp1_4\plot_files\zd307c4xs.rampU.ptf