


NB 9+540



NB 9+520

NOTE: FINAL CROSS SECTIONS FOR NB ARE CONTAINED IN THE FINAL COMP BOOKS FOR ITEM 203.15 - COMMON EXCAVATION

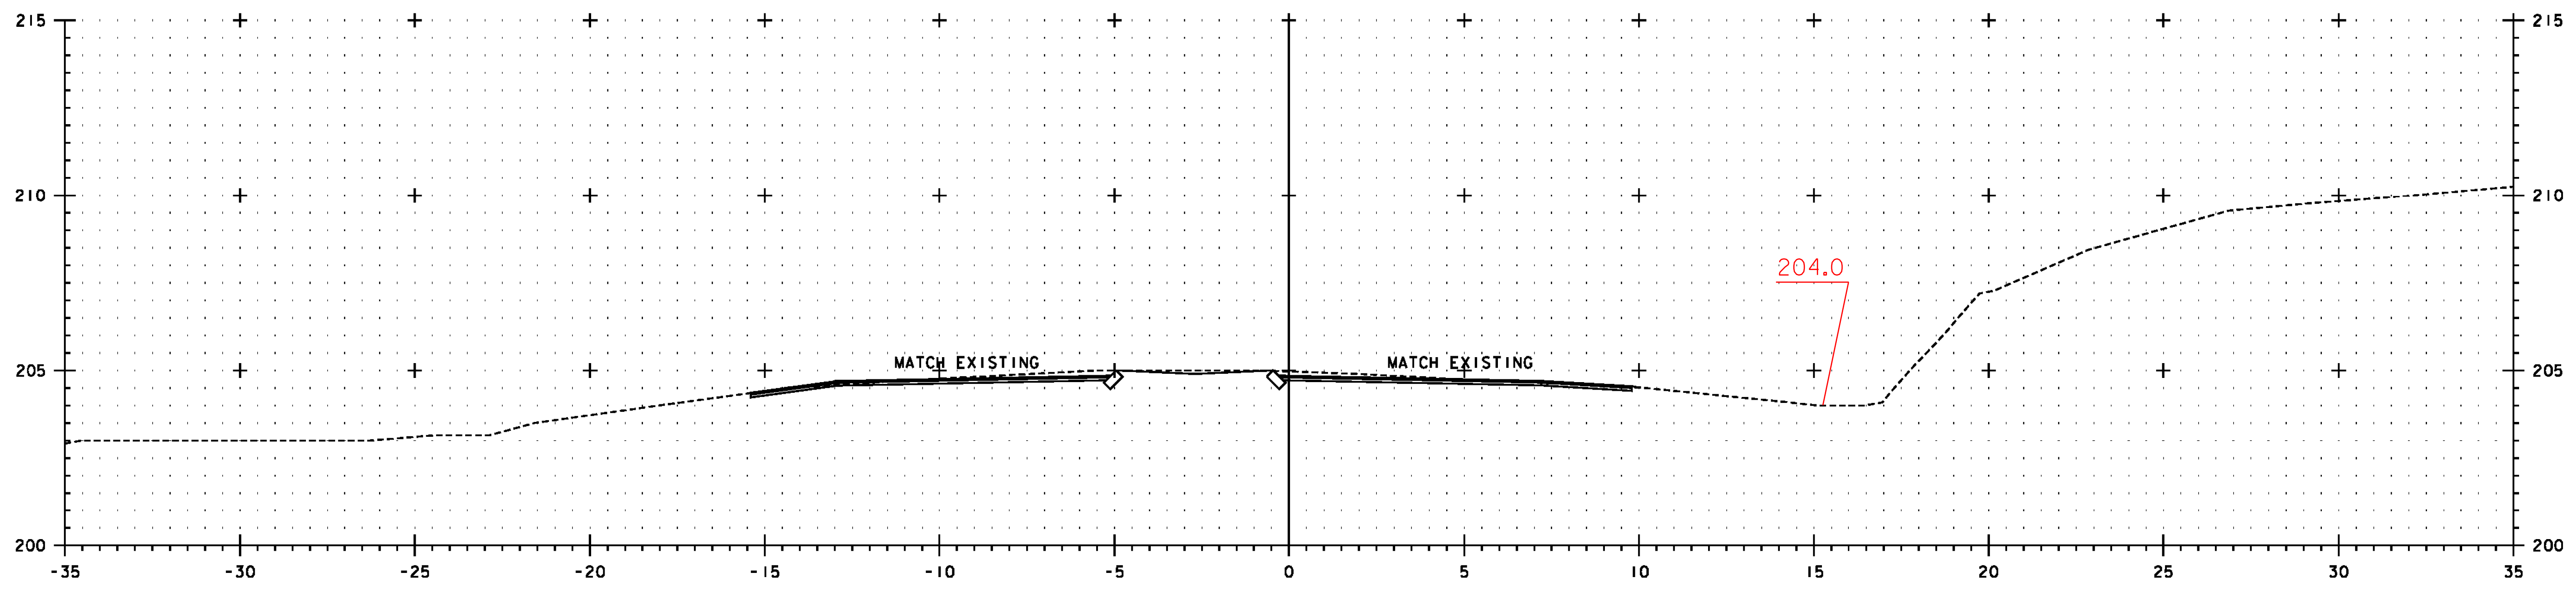

DITCHLINE REVISIONS

	PROJECT NAME: BENNINGTON	PLOT DATE: 1/26/2010
	PROJECT NUMBER: NH 019-1(54)	DRAWN BY: STANTEC
FILE NAME: ...plot_files\zd307c4xs.7nb.ptf	DESIGNED BY: MARC FOISY	CHECKED BY: GARY SANTY
DESIGN SUPERVISOR: GREG EDWARDS	US 7 NB CROSS SECTION NBX-01	SHEET 420 OF 468

1/26/2010 4:58:10 PM v:\1953\getlive\1953\002\transportation\drawing\comp\tr\def_4\plot_files\zd307c4xs.7nb.ptf