



NB 9+566.820 = L 1+000.000, 7.2m LT.

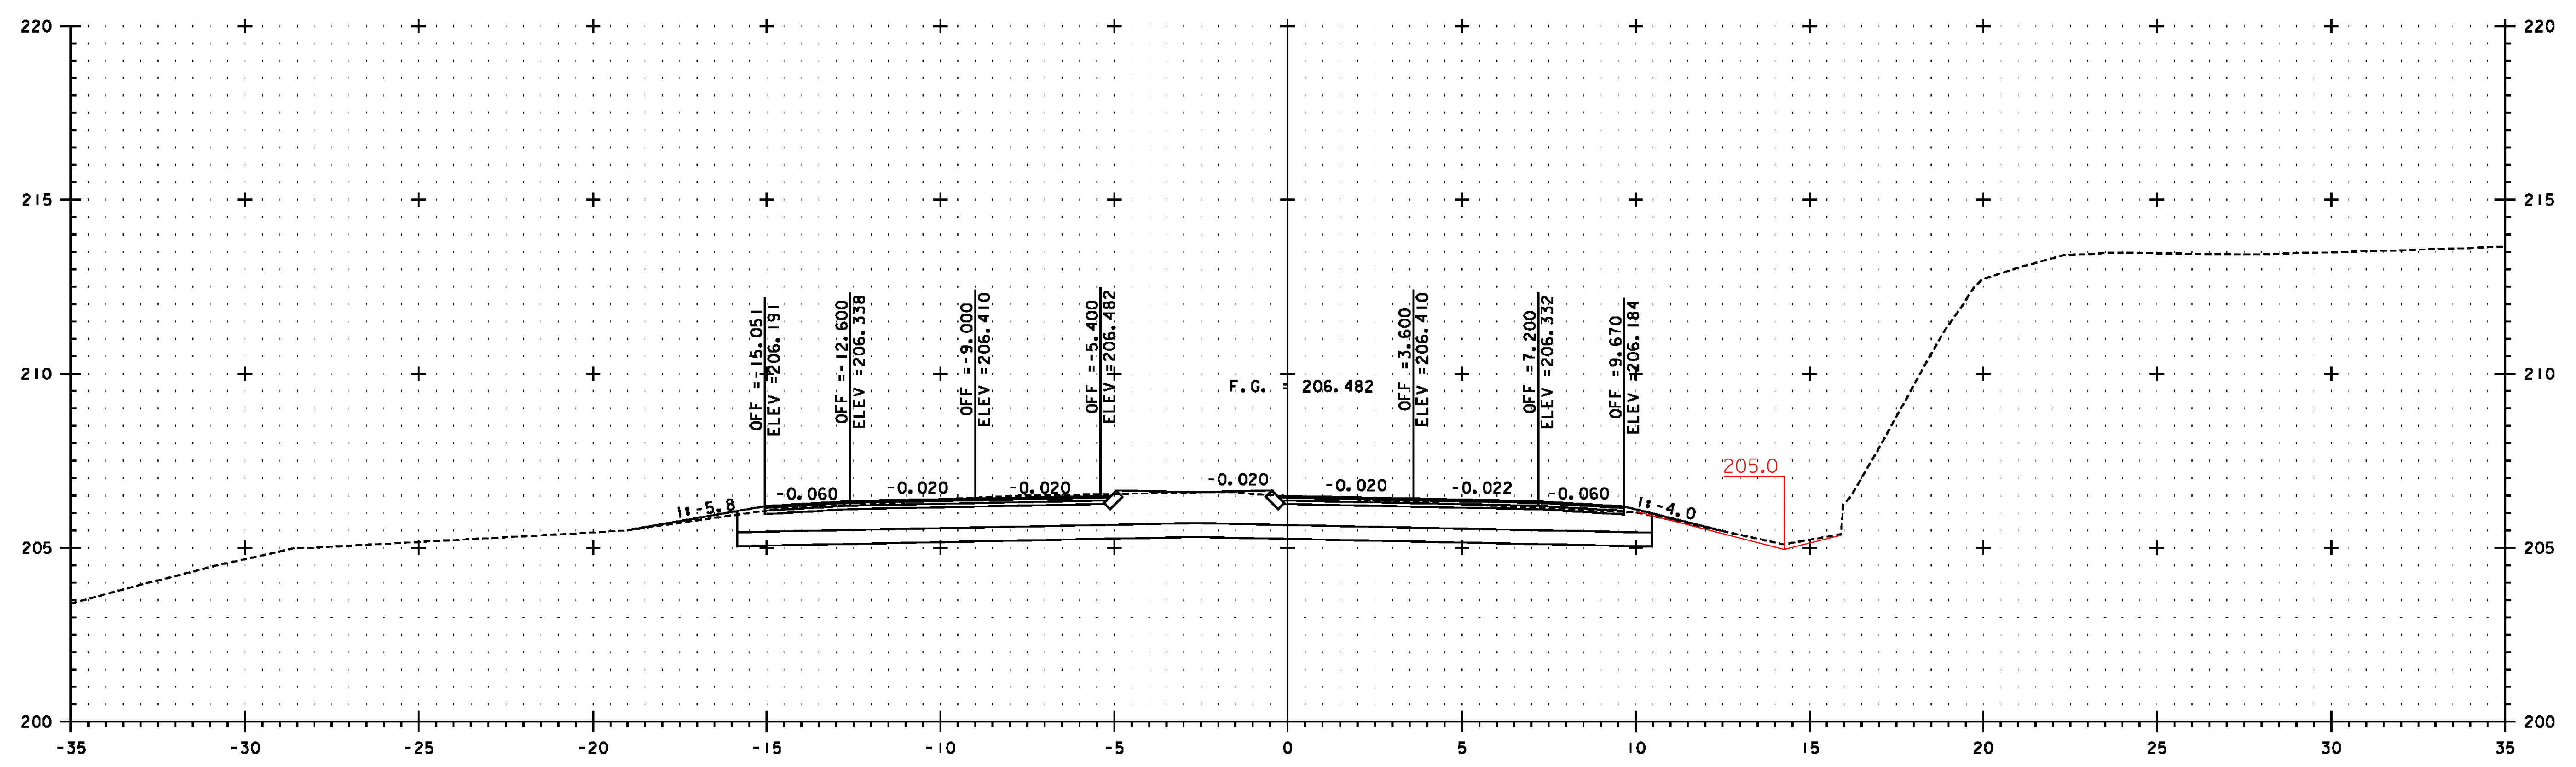

NB 9+560

SEE NOTE ON SHEET 420

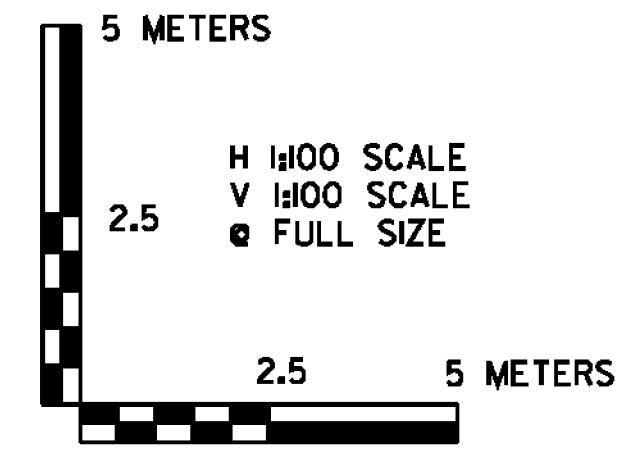

DITCHLINE REVISIONS

	PROJECT NAME: BENNINGTON	PLOT DATE: 1/26/2010
	PROJECT NUMBER: NH 019-1(54)	DRAWN BY: STANTEC
FILE NAME: ...\plot_files\zd307c4xs.7nb.ptf	DESIGNED BY: MARC FOISY	CHECKED BY: GARY SANTY
DESIGN SUPERVISOR: GREG EDWARDS	US 7 NB CROSS SECTION NBX-02	SHEET 421 OF 468

1/26/2010 4:58:12 PM V:\1953\getlive\195300021\transportation\drawing\conform\01_4\plot_files\zd307c4xs.7nb.ptf