


NB 9+600

SEE NOTE ON SHEET 420

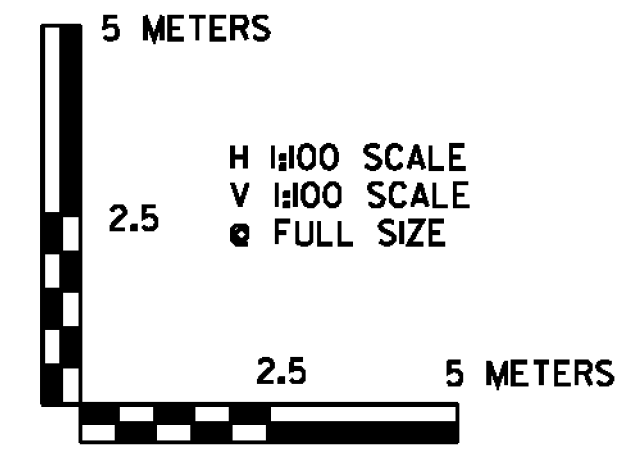

PROJECT NAME: BENNINGTON	
PROJECT NUMBER: NH 019-(154)	
FILE NAME: ...\plot_files\zd307c4xs.7nb.ptf	PLOT DATE: 3/16/2010
DESIGN SUPERVISOR: GREG EDWARDS	DRAWN BY: STANTEC
DESIGNED BY: MARC FOISY	CHECKED BY: GARY SANTY
<b>US 7 NB CROSS SECTION NBX-04</b>	SHEET 423 OF 468

3/16/2010 3:58:09 PM V:\1953\getlive\1953\0002\tr\anspor\station\drawing\control\cpl\_4\plot\_files\zd307c4xs.7nb.ptf