


NB 9+620

SEE NOTE ON SHEET 420

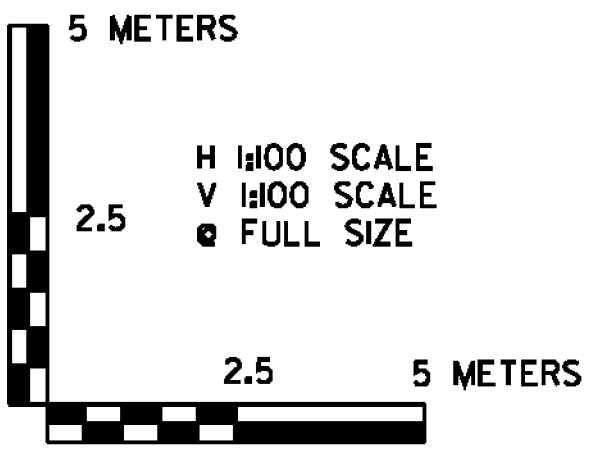

PROJECT NAME:	BENNINGTON
PROJECT NUMBER:	NH 019-(154)
FILE NAME:	...plot_files\zd307c4xs.7nb.ptf
DESIGN SUPERVISOR:	GREG EDWARDS
DESIGNED BY:	MARC FOISY
US 7 NB CROSS SECTION	NBX-05
PLOT DATE:	1/26/2010
DRAWN BY:	STANTEC
CHECKED BY:	GARY SANTY
SHEET	424 OF 468

1/26/2010 4:58:15 PM v:\1953\getlive\1953\0002\transportation\drawing\constr\cst_4\plot_files\zd307c4xs.7nb.ptf