


NB 9+660



NB 9+640

SEE NOTE ON SHEET 420

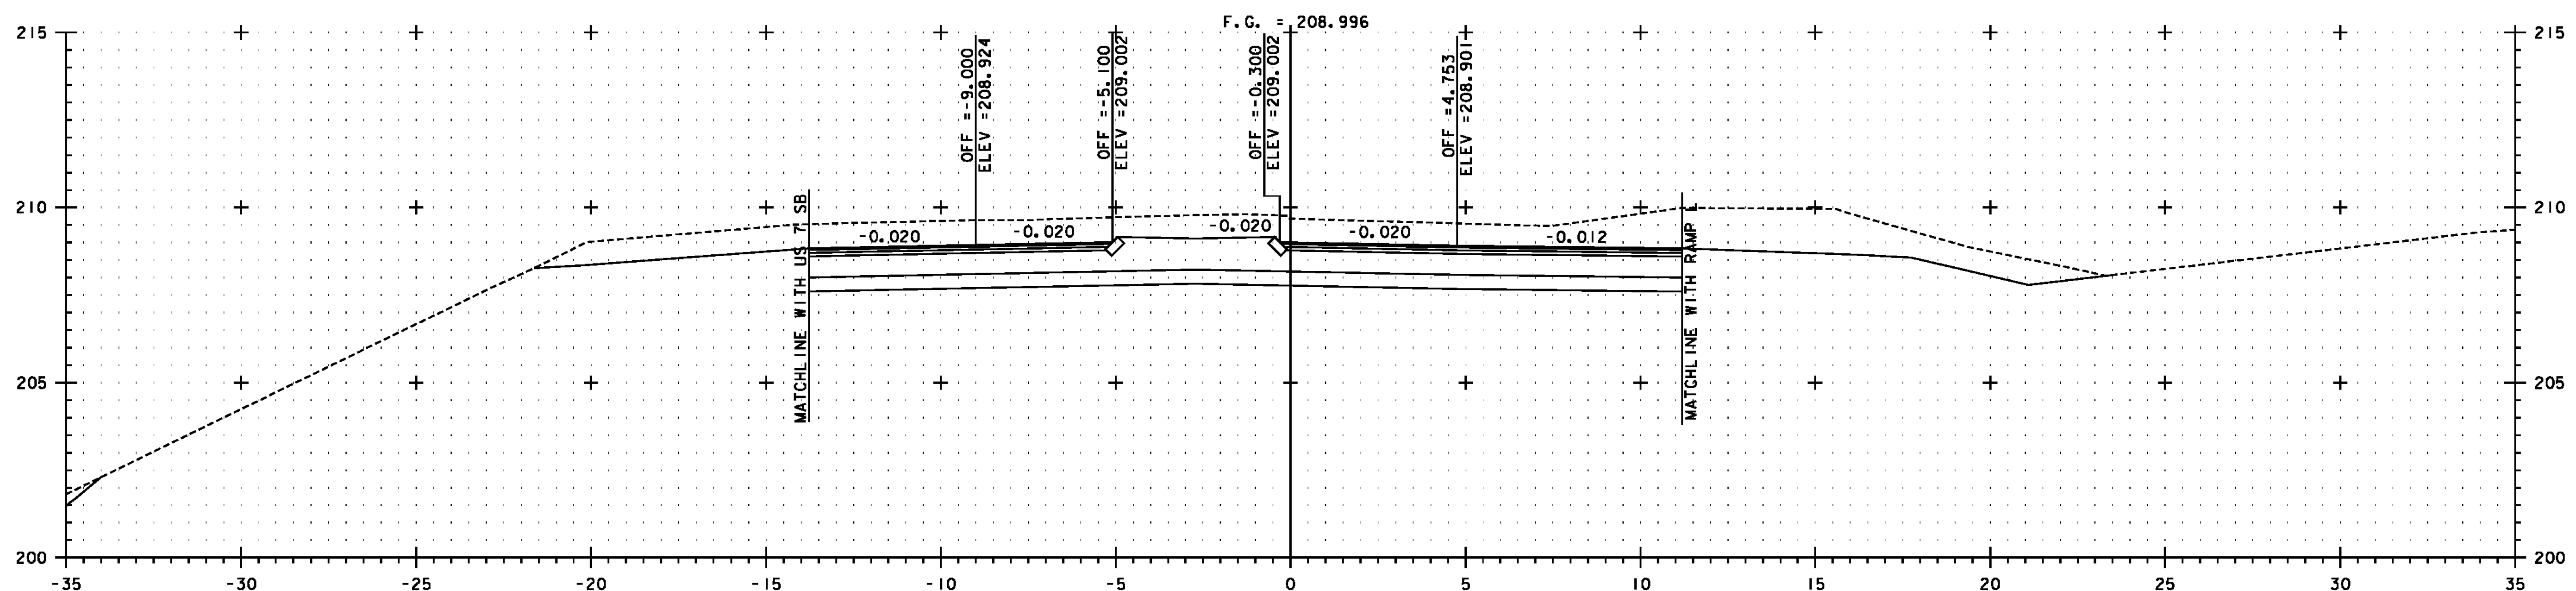

PROJECT NAME: BENNINGTON	
PROJECT NUMBER: NH 019-(154)	
FILE NAME: ...plot_files\zd307c4xs.7nb.ptf	PLOT DATE: 1/26/2010
DESIGN SUPERVISOR: GREG EDWARDS	DRAWN BY: STANTEC
DESIGNED BY: MARC FOISY	CHECKED BY: GARY SANTY
US 7 NB CROSS SECTION NBX-06	
SHEET 425 OF 468	

1/26/2010 4:58:16 PM v:\1953\getlive\1953\002\transportation\drawing\conform\4\plot_files\zd307c4xs.7nb.ptf