


NB 9+700



NB 9+680

SEE NOTE ON SHEET 420

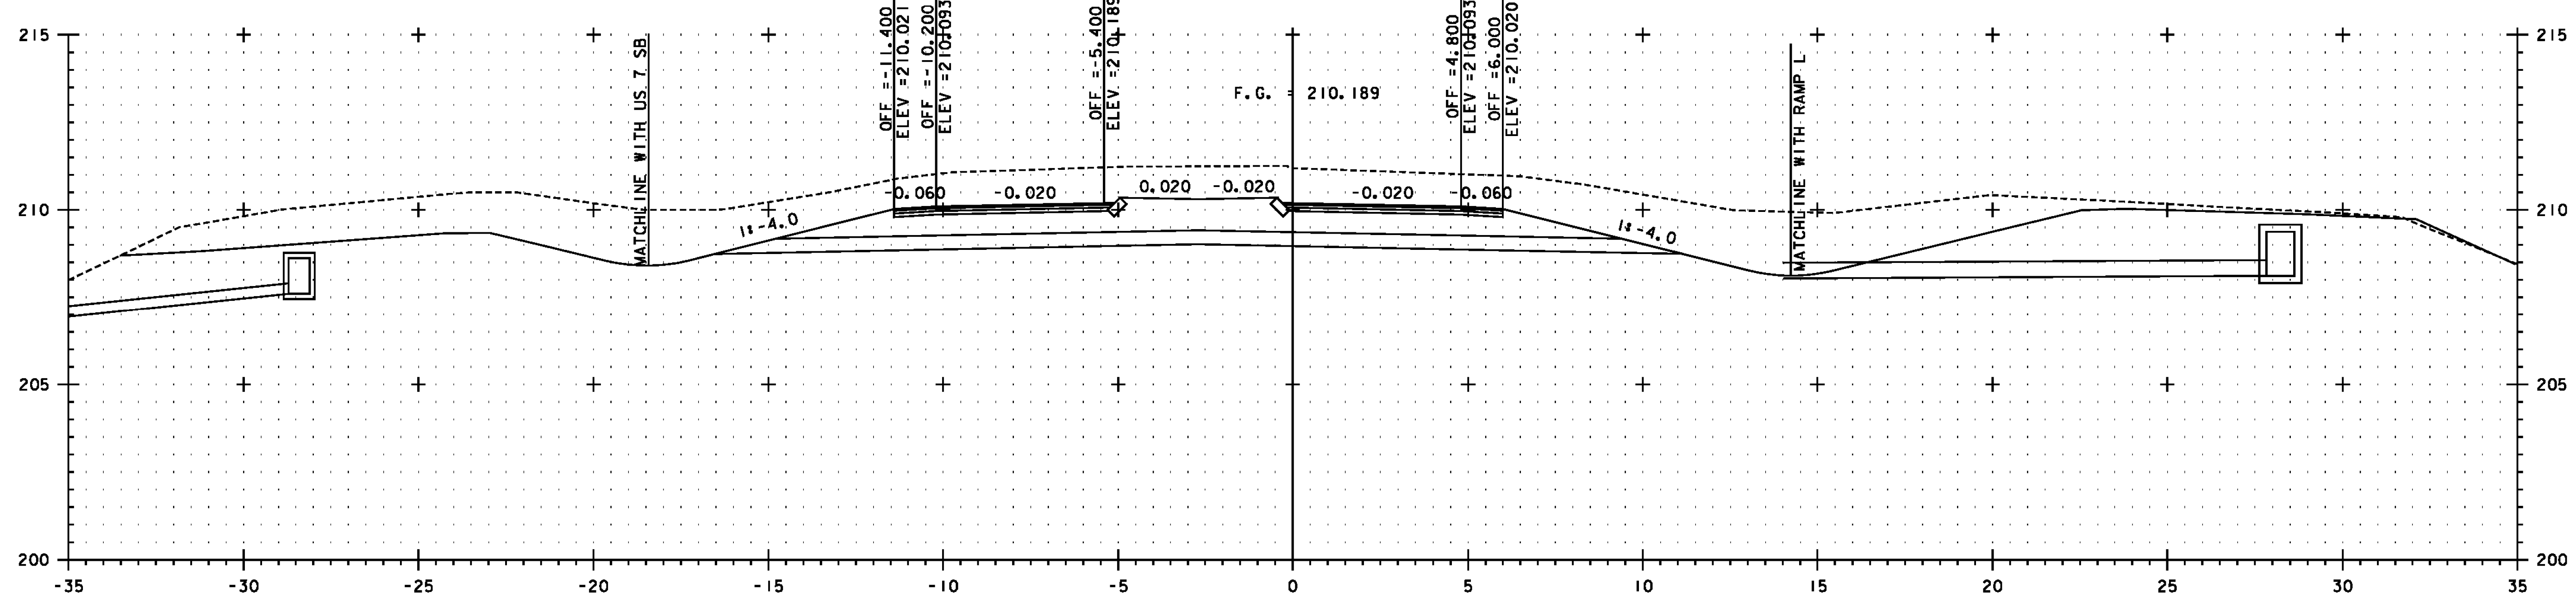

PROJECT NAME: BENNINGTON	
PROJECT NUMBER: NH 019-(154)	
FILE NAME: ...\plot_files\zd307c4xs.7nb.ptf	PLOT DATE: 1/26/2010
DESIGN SUPERVISOR: GREG EDWARDS	DRAWN BY: STANTEC
DESIGNED BY: MARC FOISY	CHECKED BY: GARY SANTY
US 7 NB CROSS SECTION NBX-07	SHEET 426 OF 468

1/26/2010 4:58:17 PM v:\1953\getlive\1953\0002\tr\anspor\top\ion\dr\cm\ng\com\tr\cst\4\p\st-Files\z307c4xs.7nb.ptf