


SEE NOTE ON SHEET 420

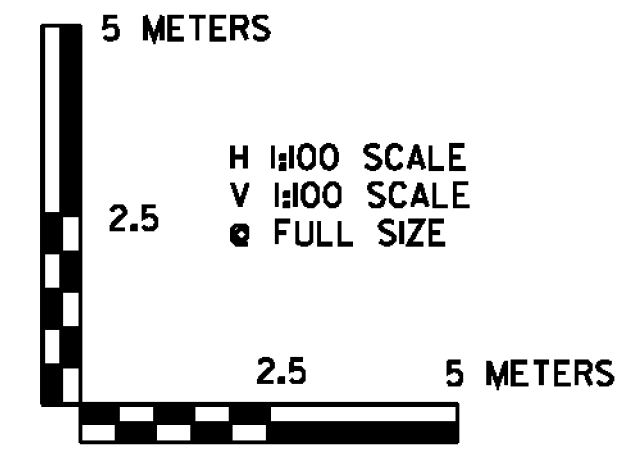

PROJECT NAME: BENNINGTON	PLOT DATE: 3/16/2010
PROJECT NUMBER: NH 019-(154)	DRAWN BY: STANTEC
FILE NAME: ...plot_files\zd307c4xs.7nb.ptf	CHECKED BY: GARY SANTY
DESIGN SUPERVISOR: GREG EDWARDS	SHEET 428 OF 468
DESIGNED BY: MARC FOISY	
<b>US 7 NB CROSS SECTION NBX-09</b>	

3/16/2010 5:08:11 PM V:\1953\getlive\1953\002A\tramsport\getlive\drw\eng\com\tr\cpt\_4\plot\_files\zd307c4xs.7nb.ptf