


NB 10+466.819 = WB 10+466.819



NB 10+480

SEE NOTE ON SHEET 420

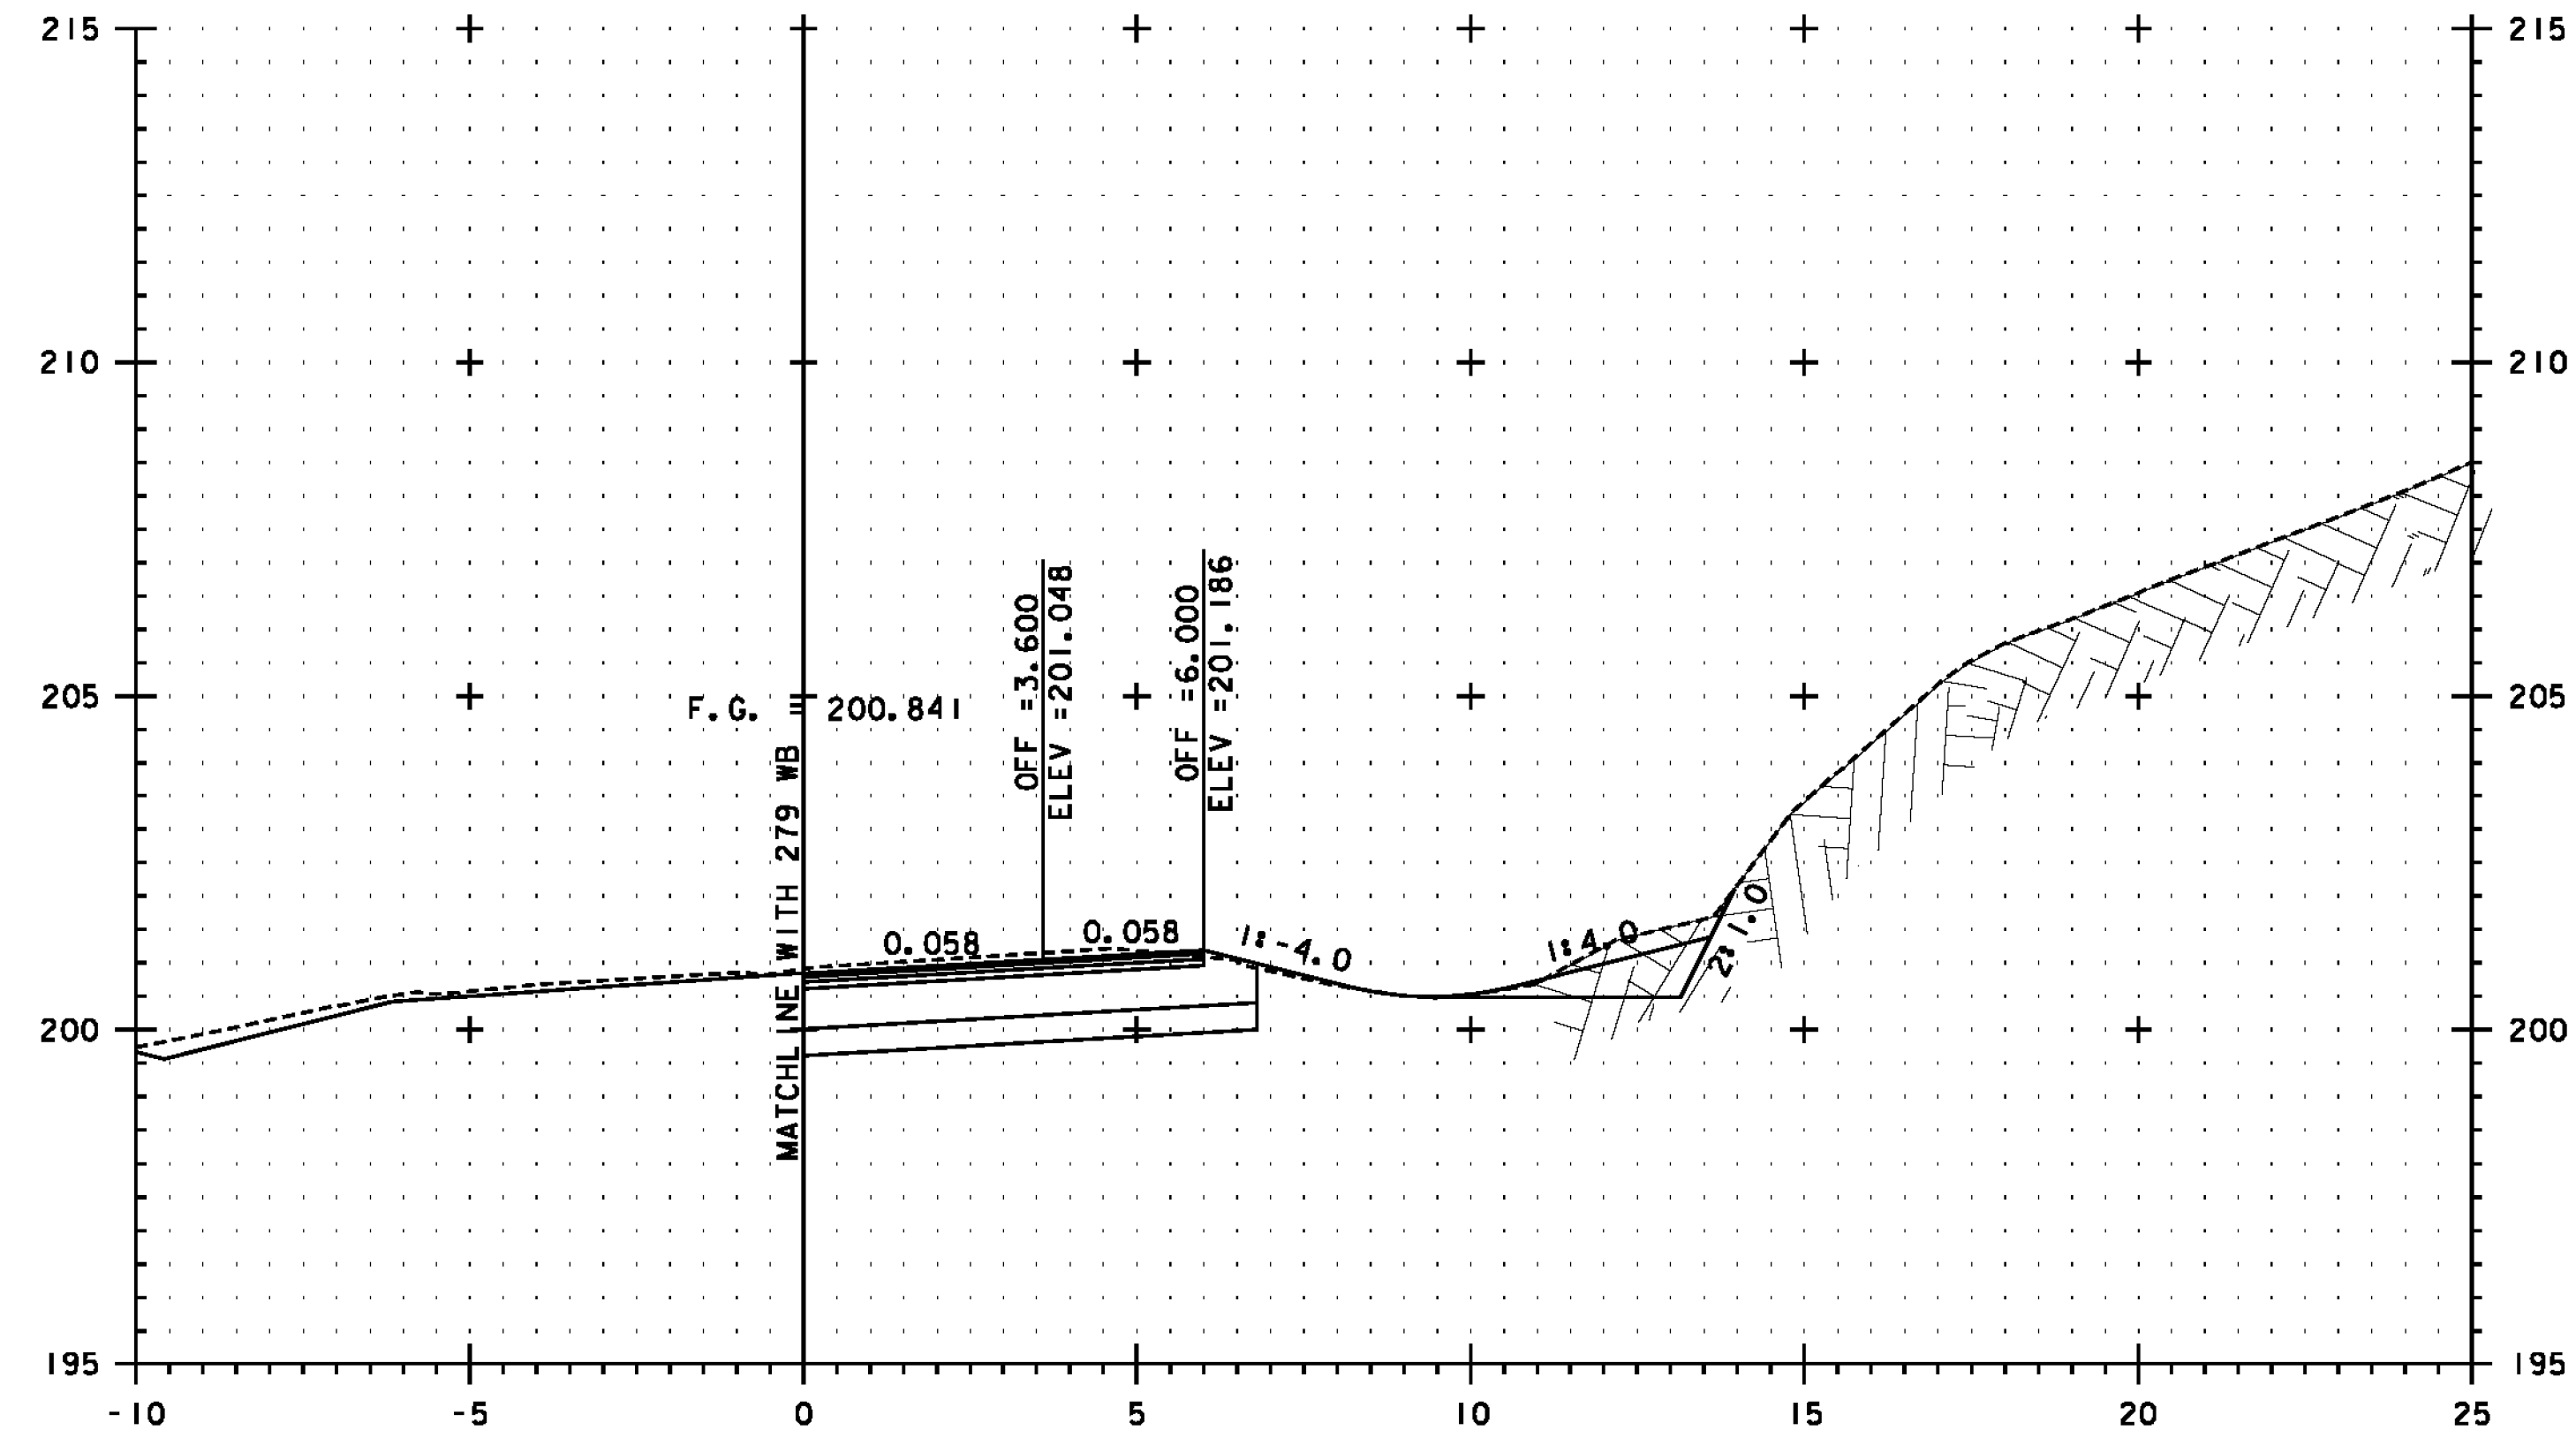

PROJECT NAME: BENNINGTON	
PROJECT NUMBER: NH 019-(154)	
FILE NAME: ...plot_files\zd307c4xs.7nb.ptf	PLOT DATE: 1/26/2010
DESIGN SUPERVISOR: GREG EDWARDS	DRAWN BY: STANTEC
DESIGNED BY: MARC FOISY	CHECKED BY: GARY SANTY
US 7 NB CROSS SECTION NBX-12	SHEET 431 OF 468

1/26/2010 4:58:23 PM V:\1953\getlive\19530002\transportation\dr\cwg\ng\constr\c01_4\plot_files\zd307c4xs.7nb.ptf