



NB 10+540

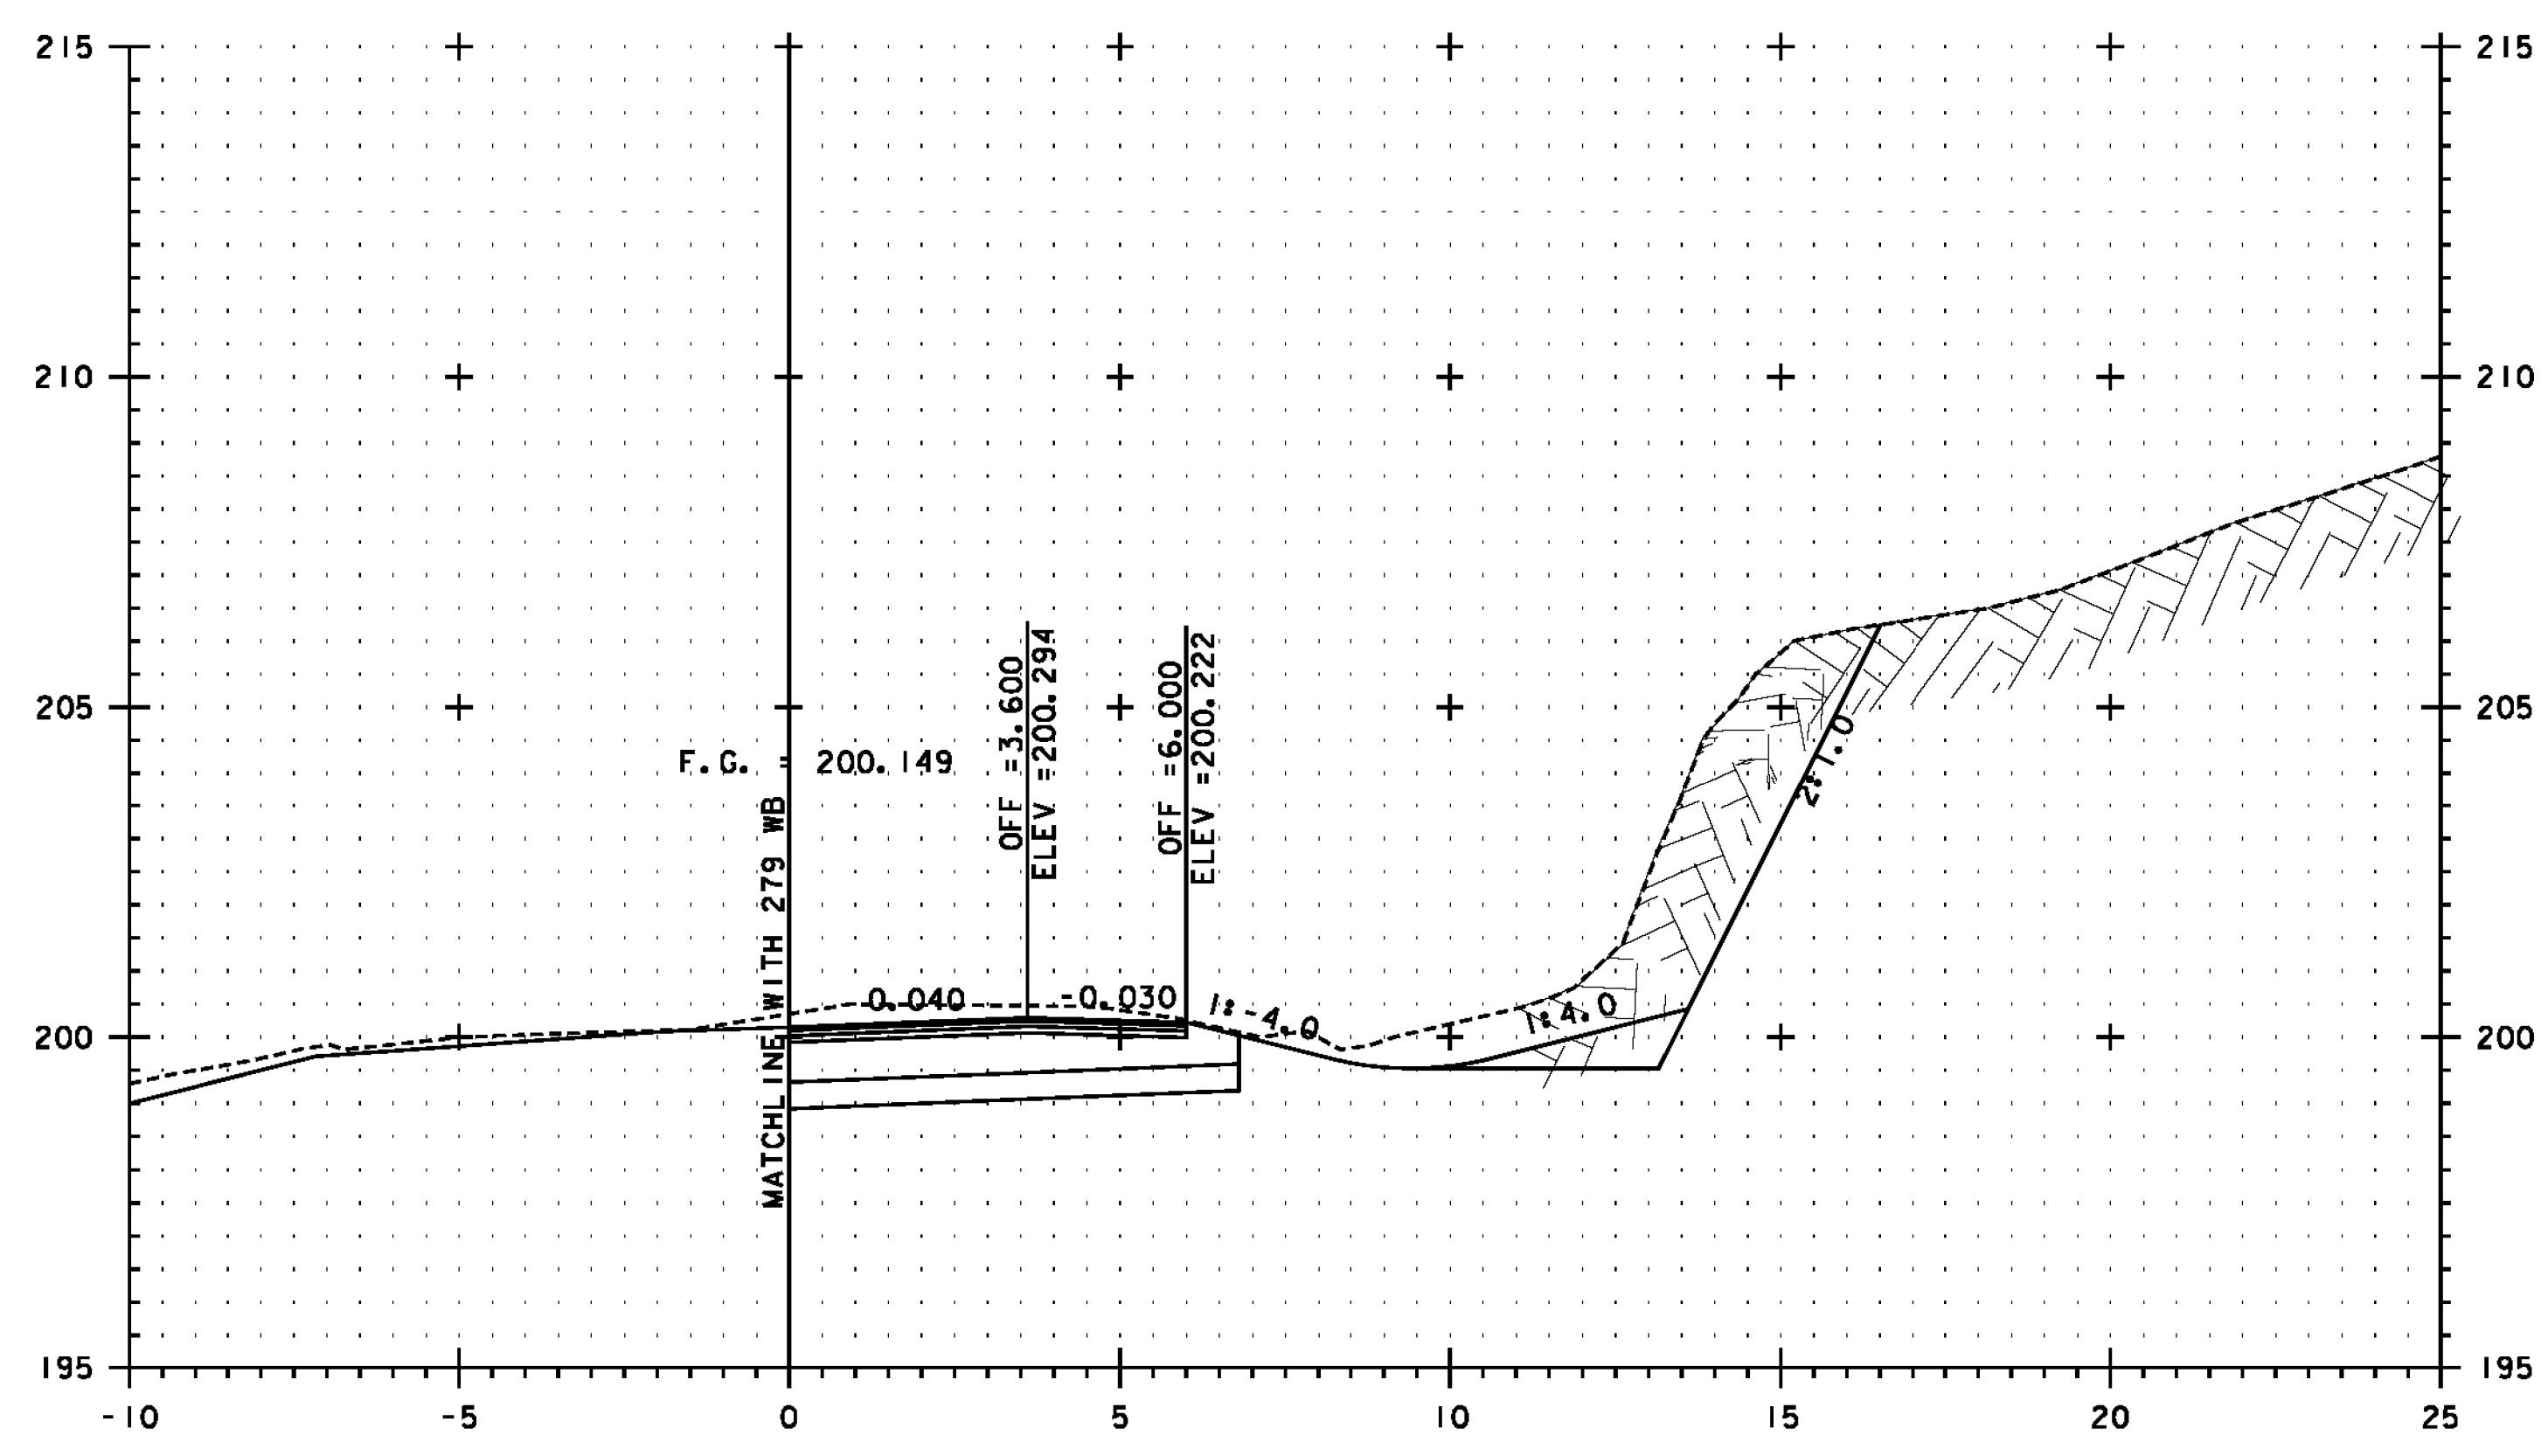


NB 10+500

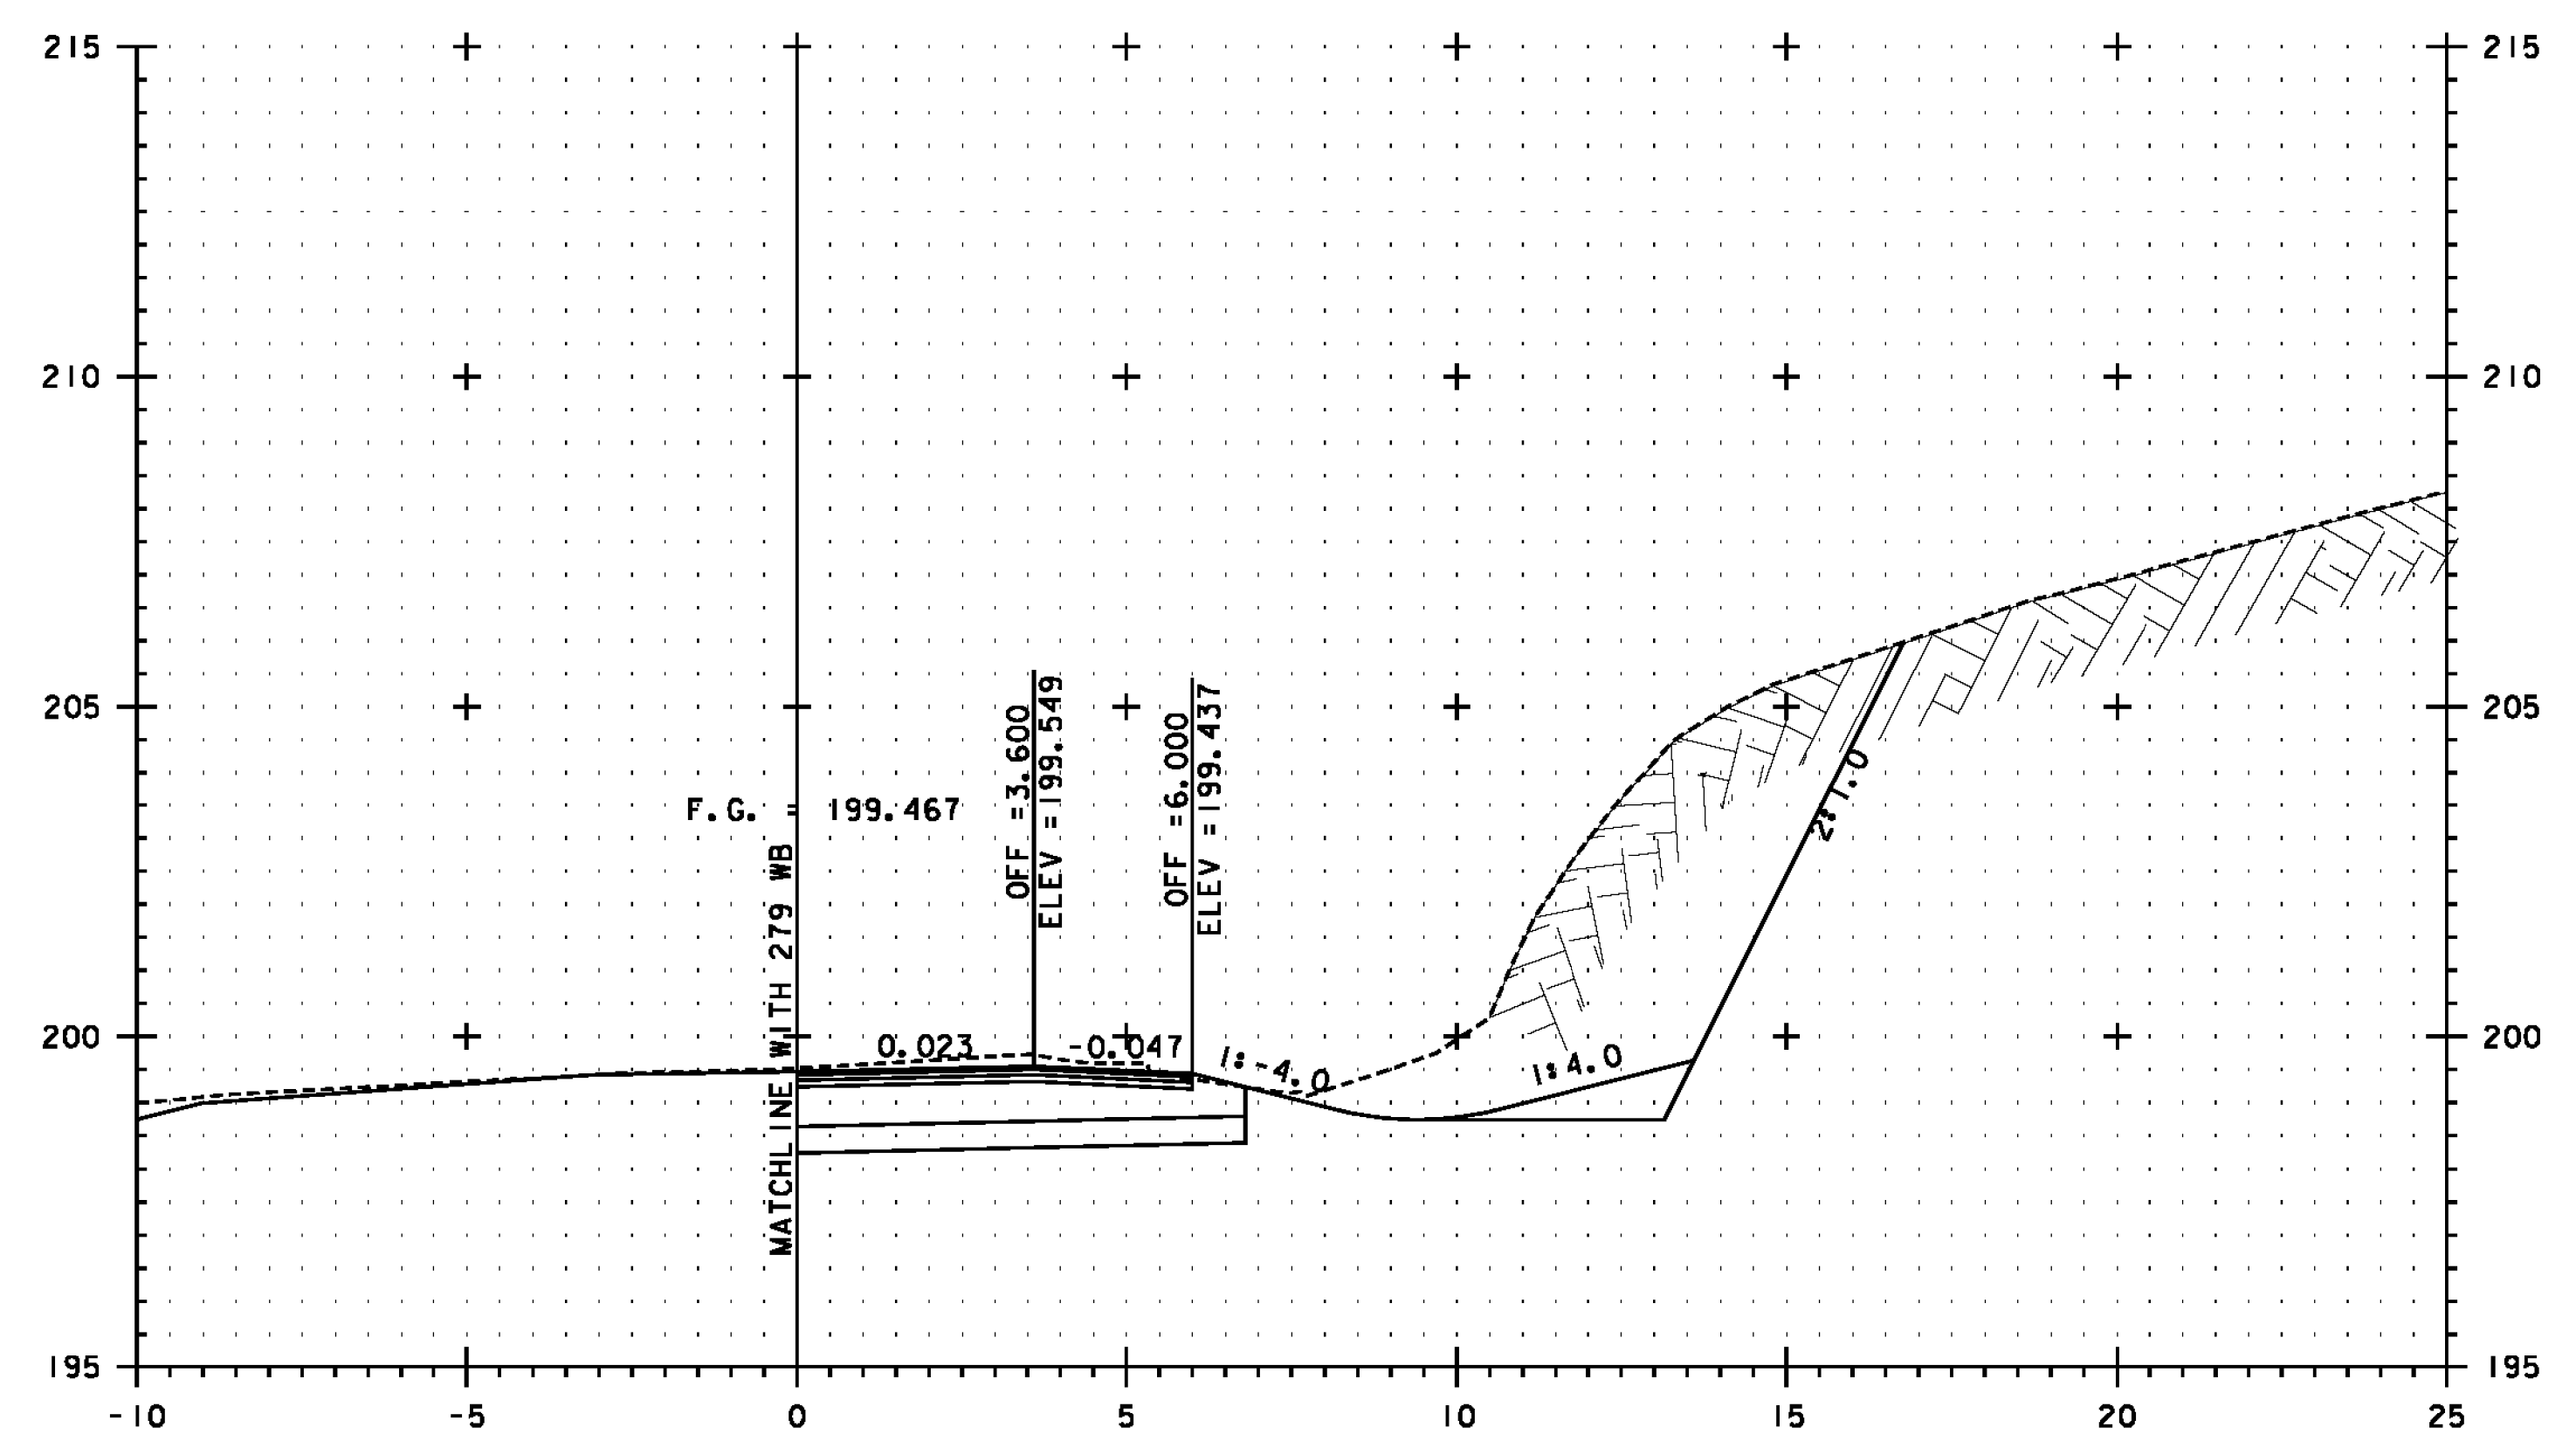

NB 10+520

SEE NOTE ON SHEET 420

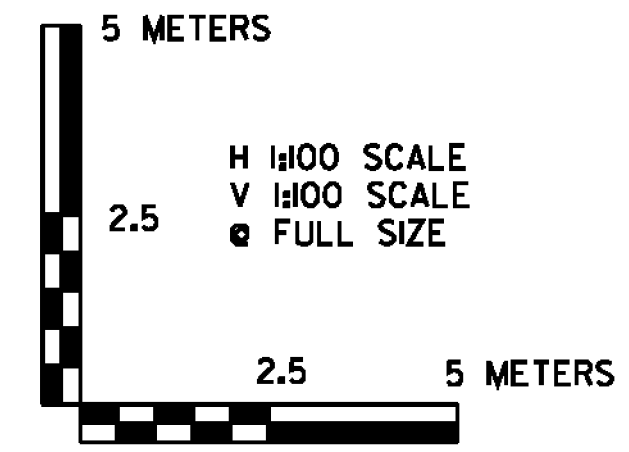

PROJECT NAME: BENNINGTON	PLOT DATE: 1/26/2010
PROJECT NUMBER: NH 019-(154)	DRAWN BY: STANTEC
FILE NAME: ...\plot_files\zd307c4xs.7nb.ptf	CHECKED BY: GARY SANTY
DESIGN SUPERVISOR: GREG EDWARDS	SHEET 432 OF 468
DESIGNED BY: MARC FOISY	
US 7 NB CROSS SECTION NBX-13	

1/26/2010 4:58:24 PM v:\1953\getlive\1953\002A\transportation\drw\ng\confr\001_4\plot_files\zd307c4xs.7nb.ptf