


NB 10+680



NB 10+660

SEE NOTE ON SHEET 420

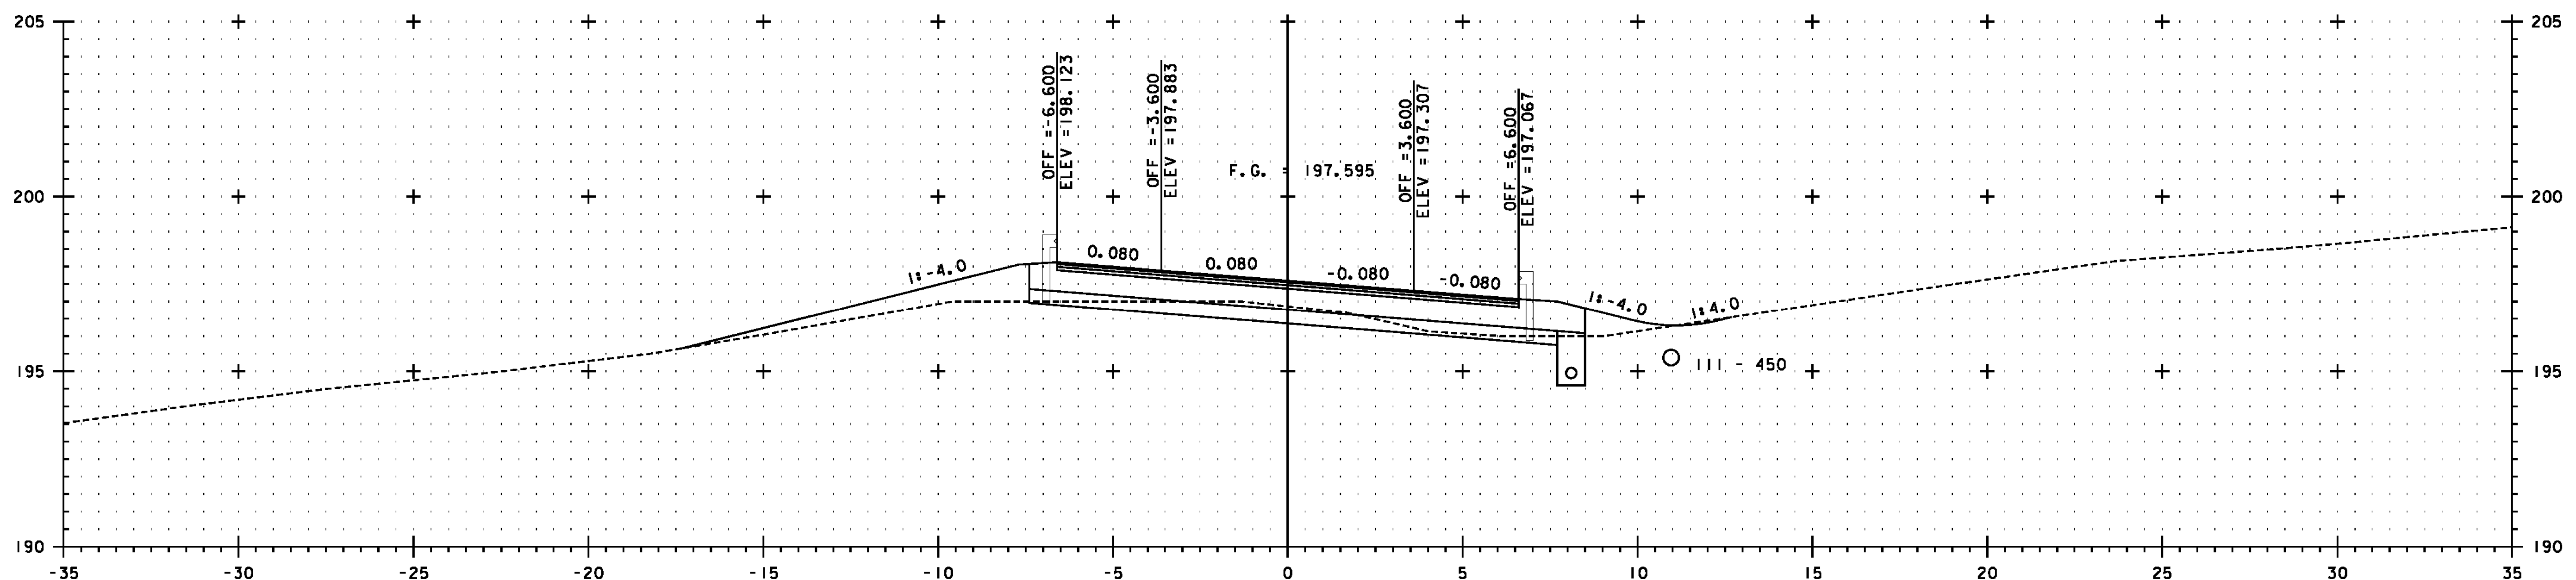

PROJECT NAME: BENNINGTON	PLOT DATE: 1/26/2010
PROJECT NUMBER: NH 019-(154)	DRAWN BY: STANTEC
FILE NAME: ...\plot_files\zd307c4xs.7nb.ptf	DESIGNED BY: GARY SANTY
DESIGN SUPERVISOR: GREG EDWARDS	CHECKED BY: GARY SANTY
US 7 NB CROSS SECTION NBX-17	SHEET 436 OF 468