


NB 10+760



NB 10+740

SEE NOTE ON SHEET 420

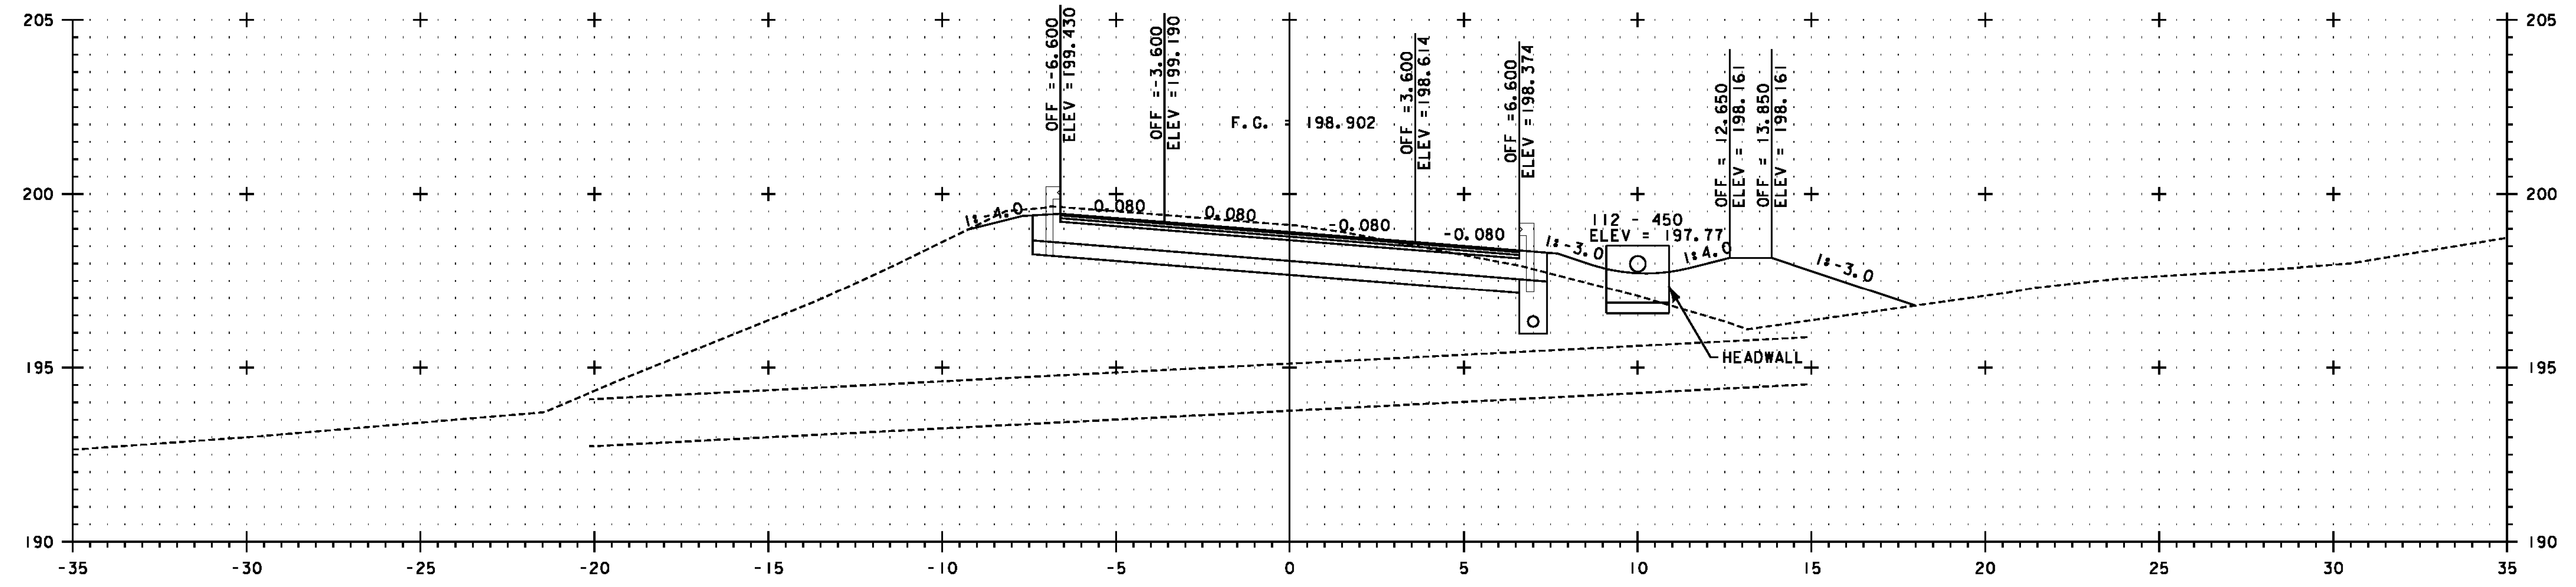

PROJECT NAME: BENNINGTON	
PROJECT NUMBER: NH 019-(154)	
FILE NAME: ...\plot_files\zd307c4xs.7nb.ptf	PLOT DATE: 3/16/2010
DESIGN SUPERVISOR: GREG EDWARDS	DRAWN BY: STANTEC
DESIGNED BY: MARC FOISY	CHECKED BY: GARY SANTY
US 7 NB CROSS SECTION NBX-19	SHEET 438 OF 468

3/16/2010 11:45:13 AM v:\1953\getlive\1953\0002\tr\anspor\101\dr\cm\ng\cont\rc\01_4\plot_files\zd307c4xs.7nb.ptf