


SEE NOTE ON SHEET 420

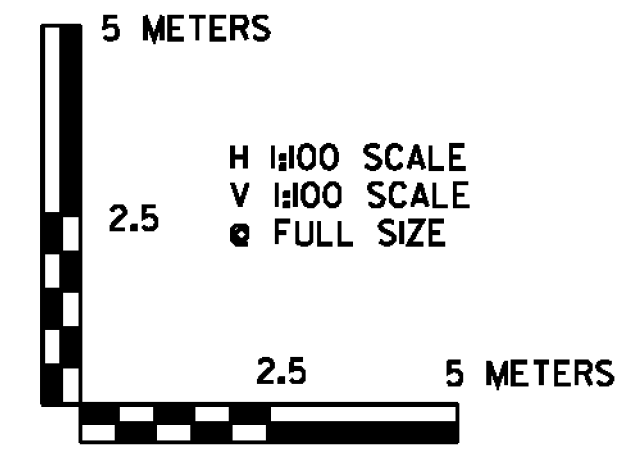

PROJECT NAME: BENNINGTON	PLOT DATE: 1/26/2010
PROJECT NUMBER: NH 019-(154)	DRAWN BY: STANTEC
FILE NAME: ...plot_files\zd307c4xs.7nb.ptf	CHECKED BY: GARY SANTY
DESIGN SUPERVISOR: GREG EDWARDS	SHEET 439 OF 468
DESIGNED BY: MARC FOISY	
US 7 NB CROSS SECTION NBX-20	

1/26/2010 4:58:31 PM V:\1953\getlive\19530002\transportation\drawing\confr\cst\_4\plot\_files\zd307c4xs.7nb.ptf