



NB 10+880

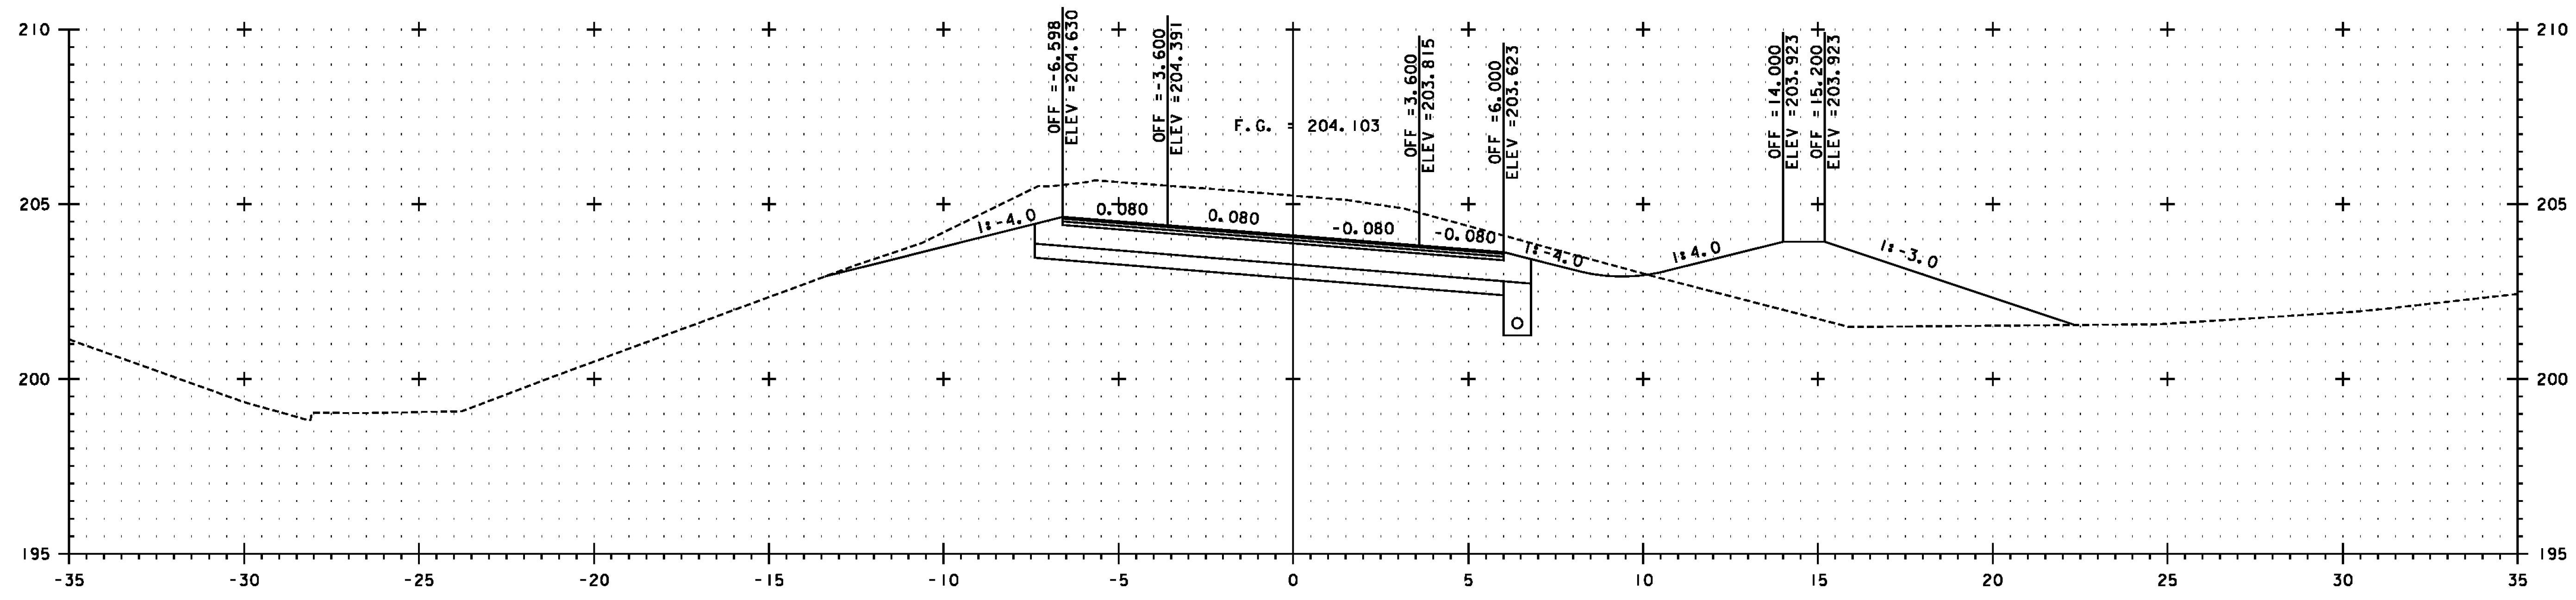

NB 10+860

SEE NOTE ON SHEET 420

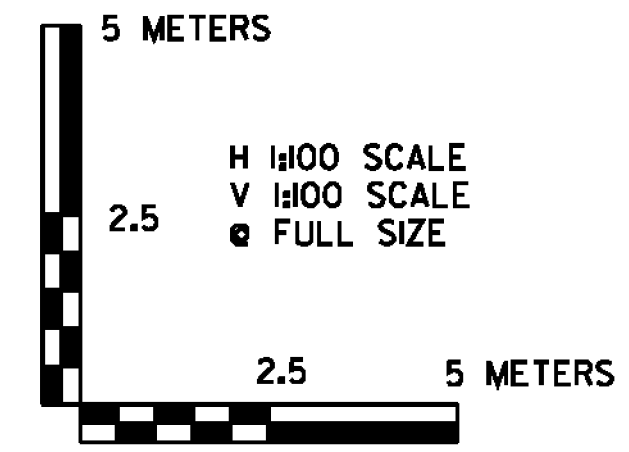

PROJECT NAME: BENNINGTON	PLOT DATE: 1/26/2010
PROJECT NUMBER: NH 019-1(54)	DRAWN BY: STANTEC
FILE NAME: ...\plot_files\zd307c4xs.7nb.ptf	CHECKED BY: GARY SANTY
DESIGN SUPERVISOR: GREG EDWARDS	SHEET 441 OF 468
DESIGNED BY: MARC FOISY	
US 7 NB CROSS SECTION NBX-22	

1/26/2010 4:58:34 PM v:\1953\getlive\195310002\tramsport\station\drawing\cont\tr\cst_4\plot_files\zd307c4xs.7nb.ptf