



NB 9+580.162 = SB 9+746.965, 12.6m RT.

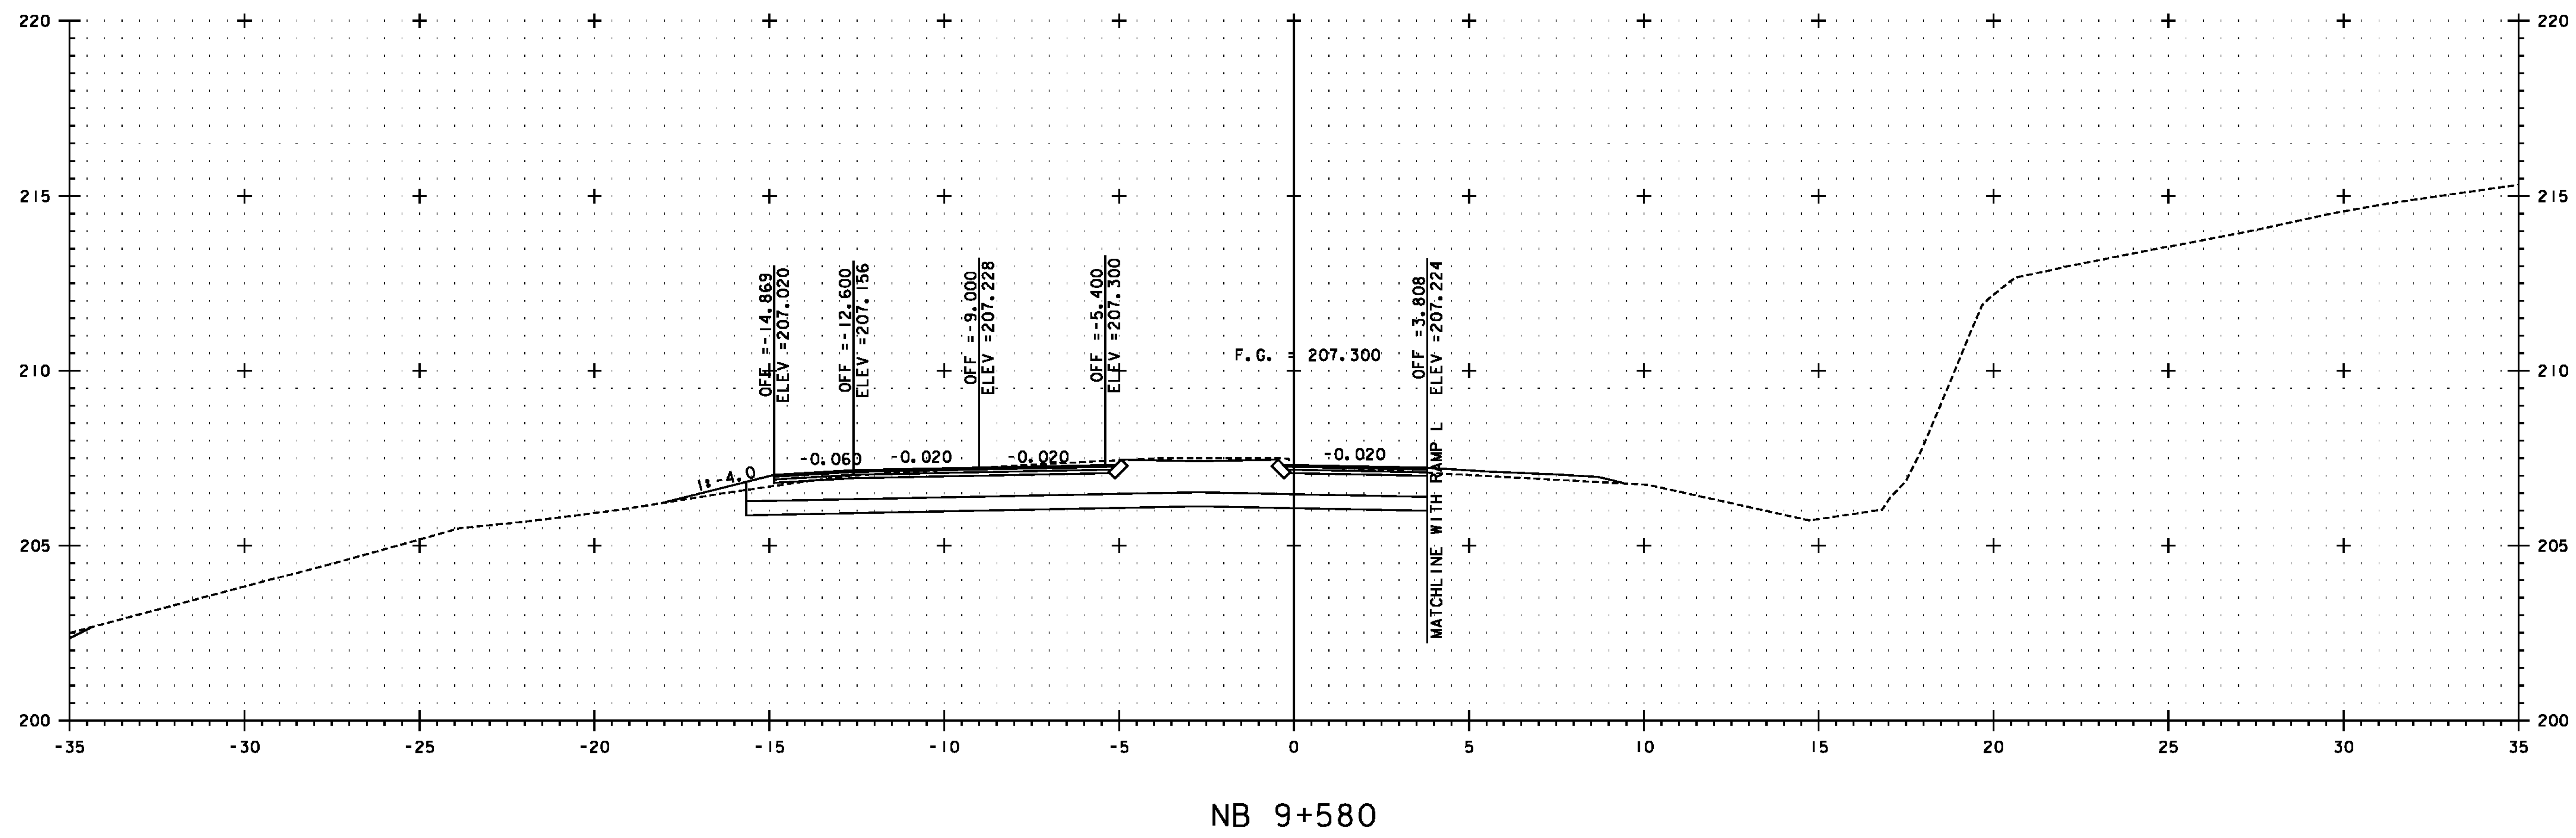

NB 9+580

SEE NOTE ON SHEET 420

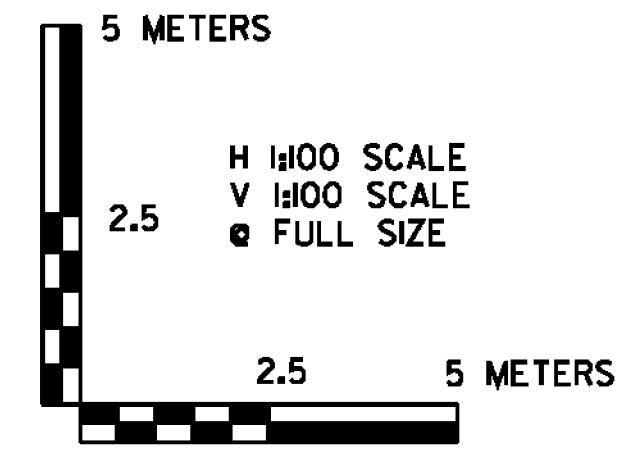

PROJECT NAME: BENNINGTON	PLOT DATE: 1/26/2010
PROJECT NUMBER: NH 019-(154)	DRAWN BY: STANTEC
FILE NAME: ...plot_files\zd307c4xs.7nb.ptf	CHECKED BY: GARY SANTY
DESIGN SUPERVISOR: GREG EDWARDS	SHEET 422 OF 468
DESIGNED BY: MARC FOISY	
US 7 NB CROSS SECTION NBX-03	

1/26/2010 4:58:13 PM v:\1953\getlive\1953\0002\tr\anspor\station\drawing\cont\tr\cst\_4\plot\_files\zd307c4xs.7nb.ptf