




NB 11+025.260 = G 2+306.468, 3.6m RT.

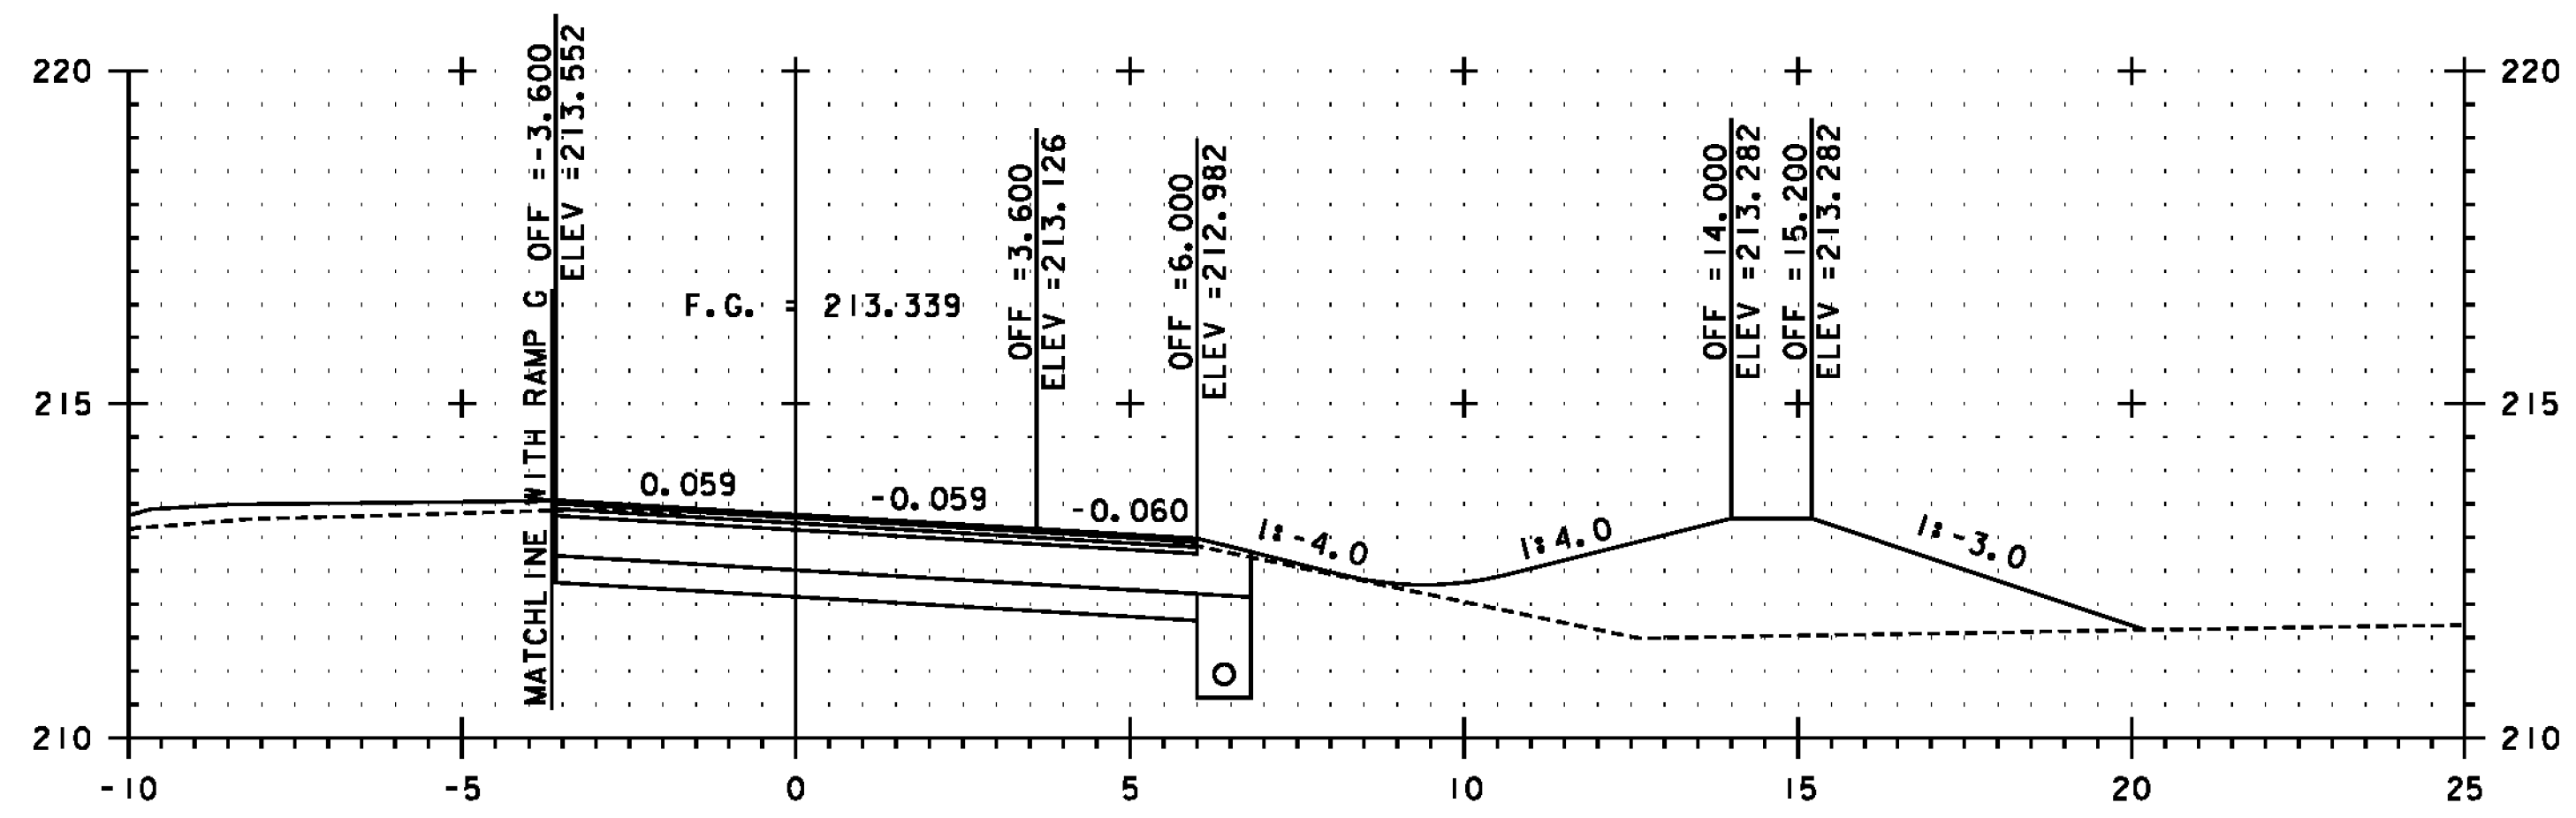


NB 11+020

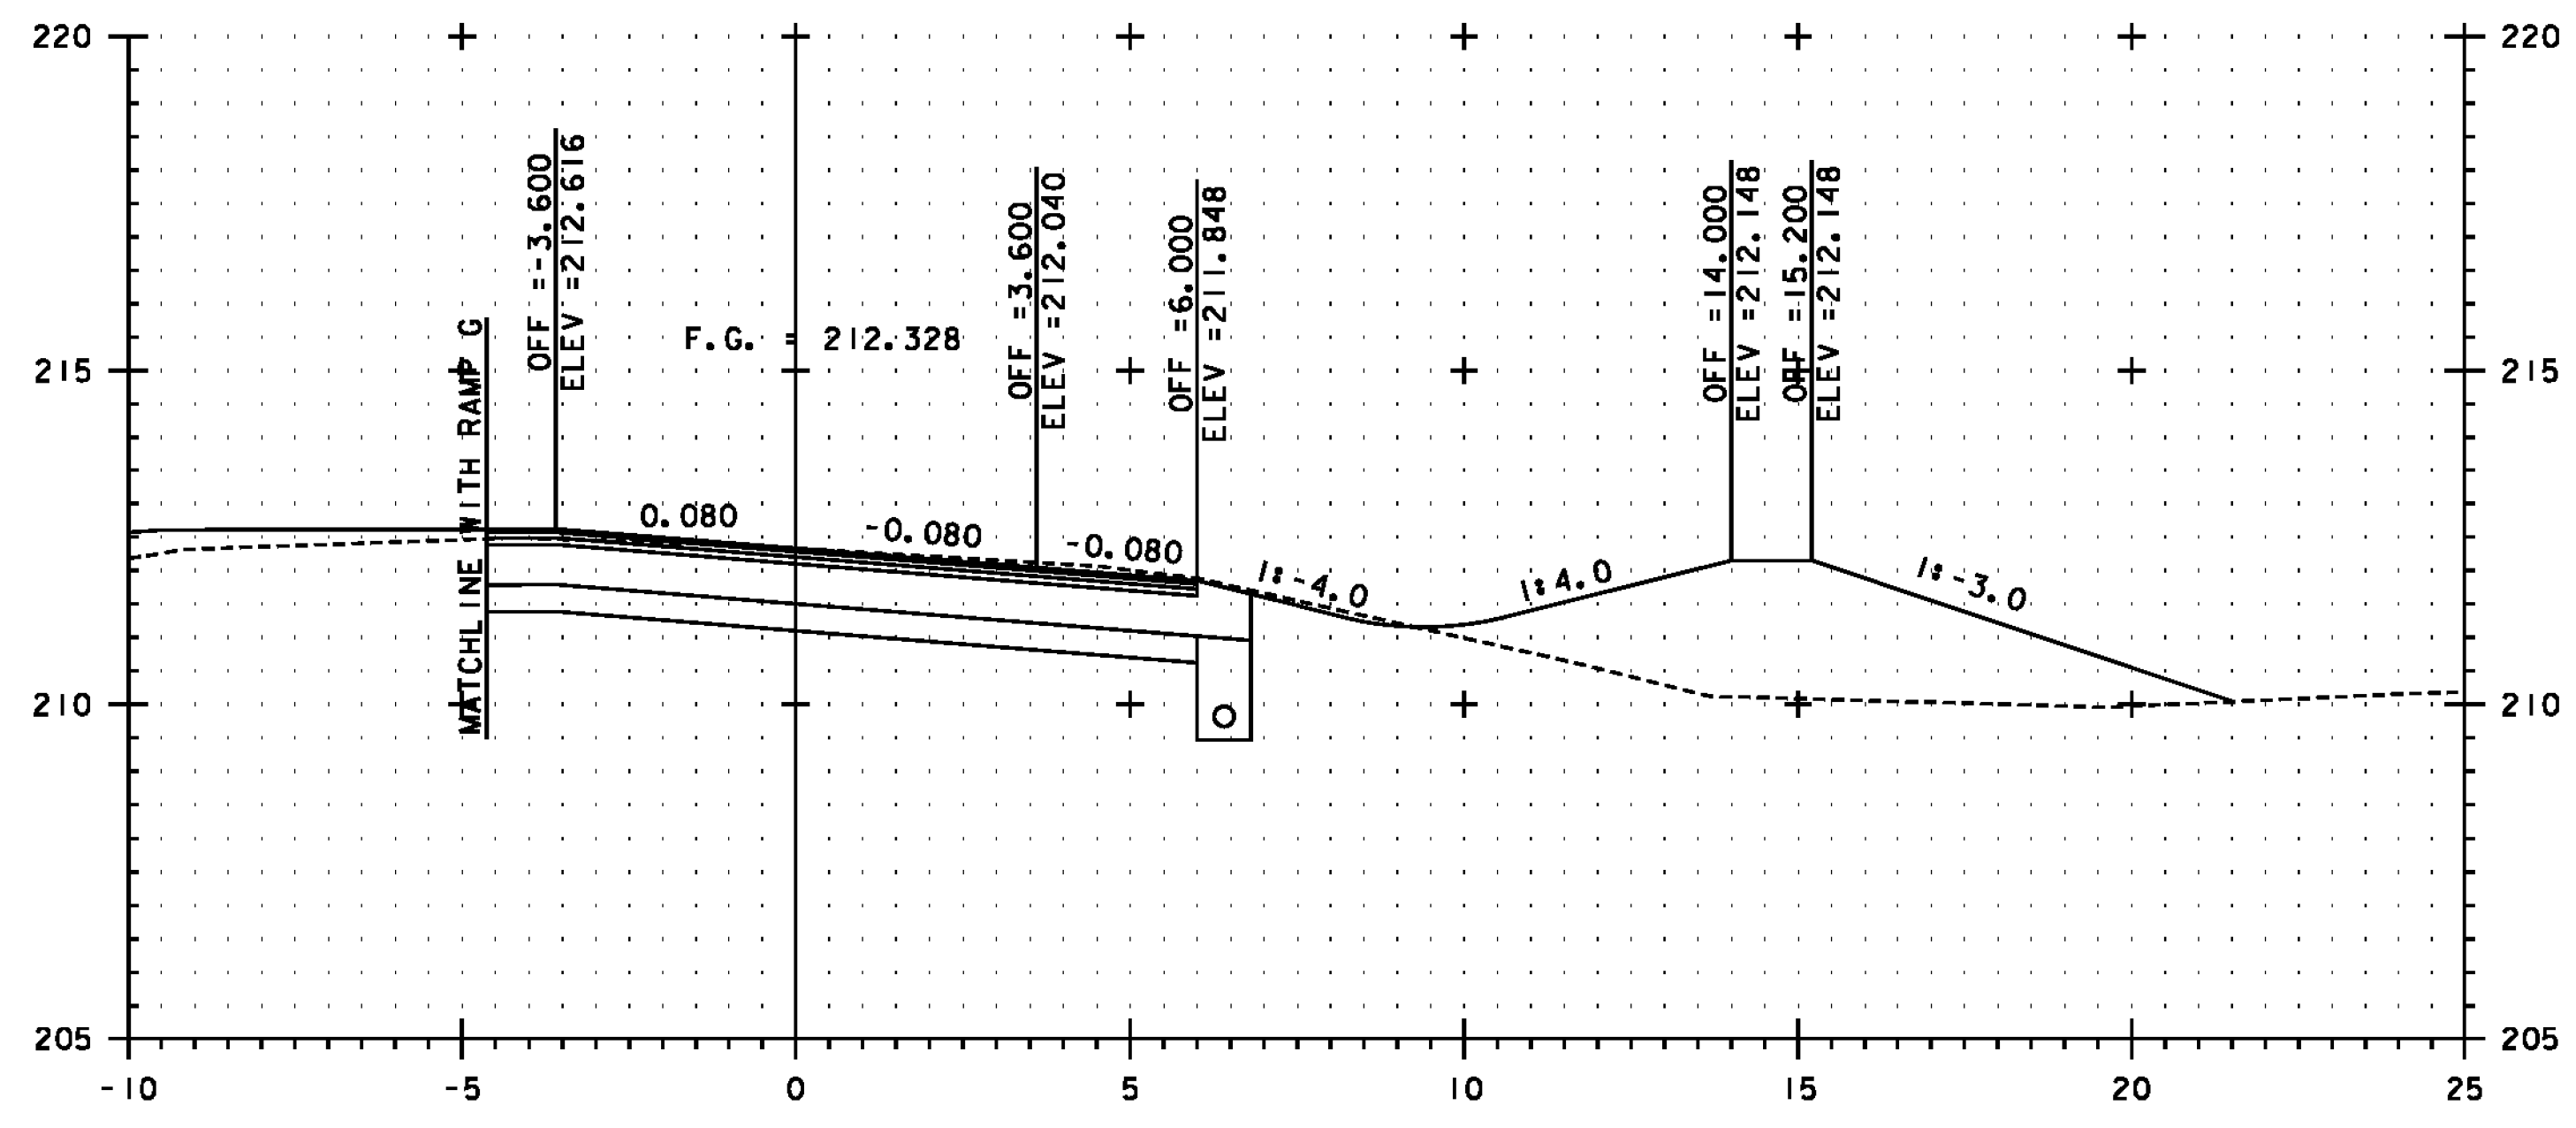


NB 11+000

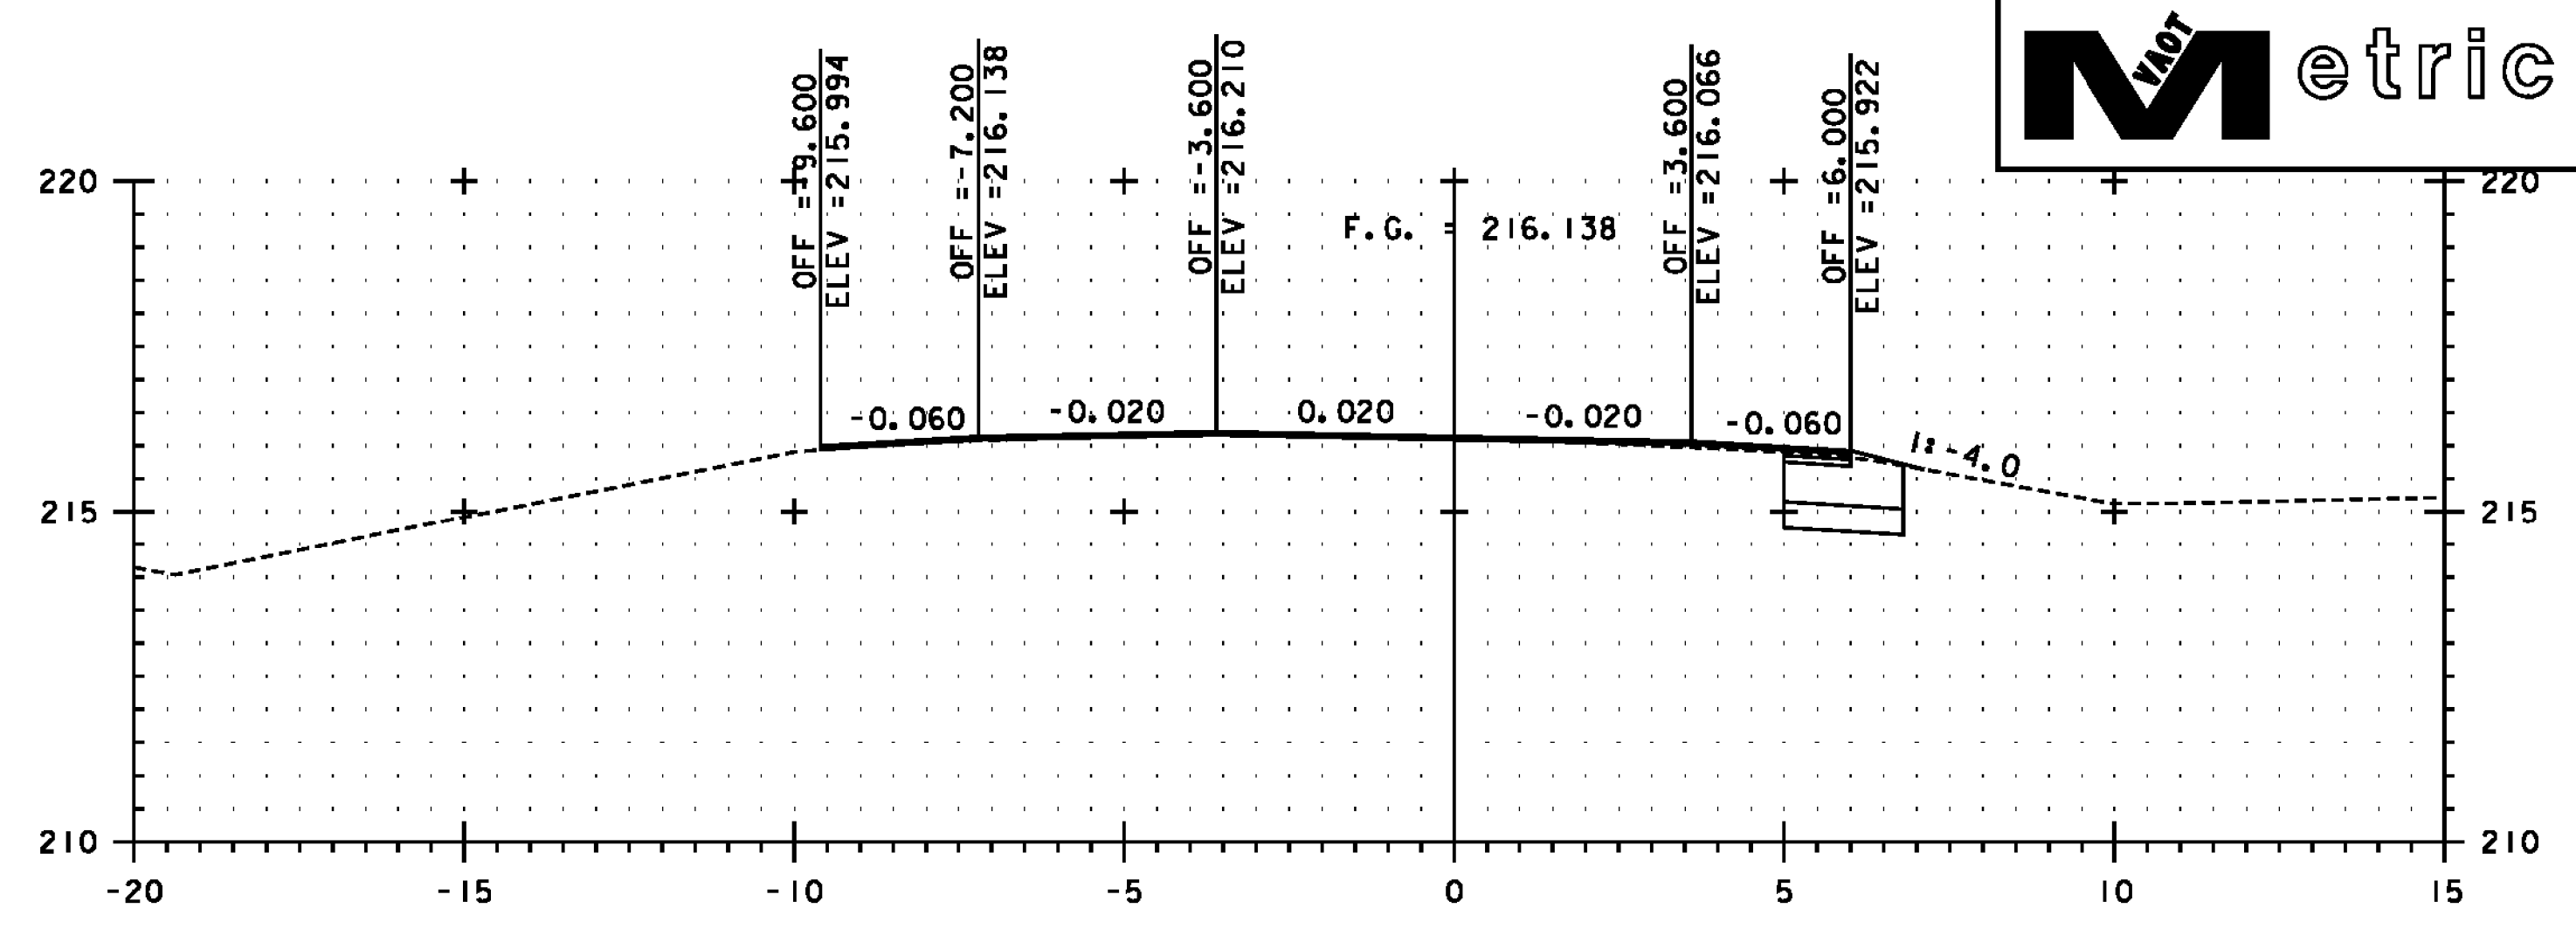

NB 11+080

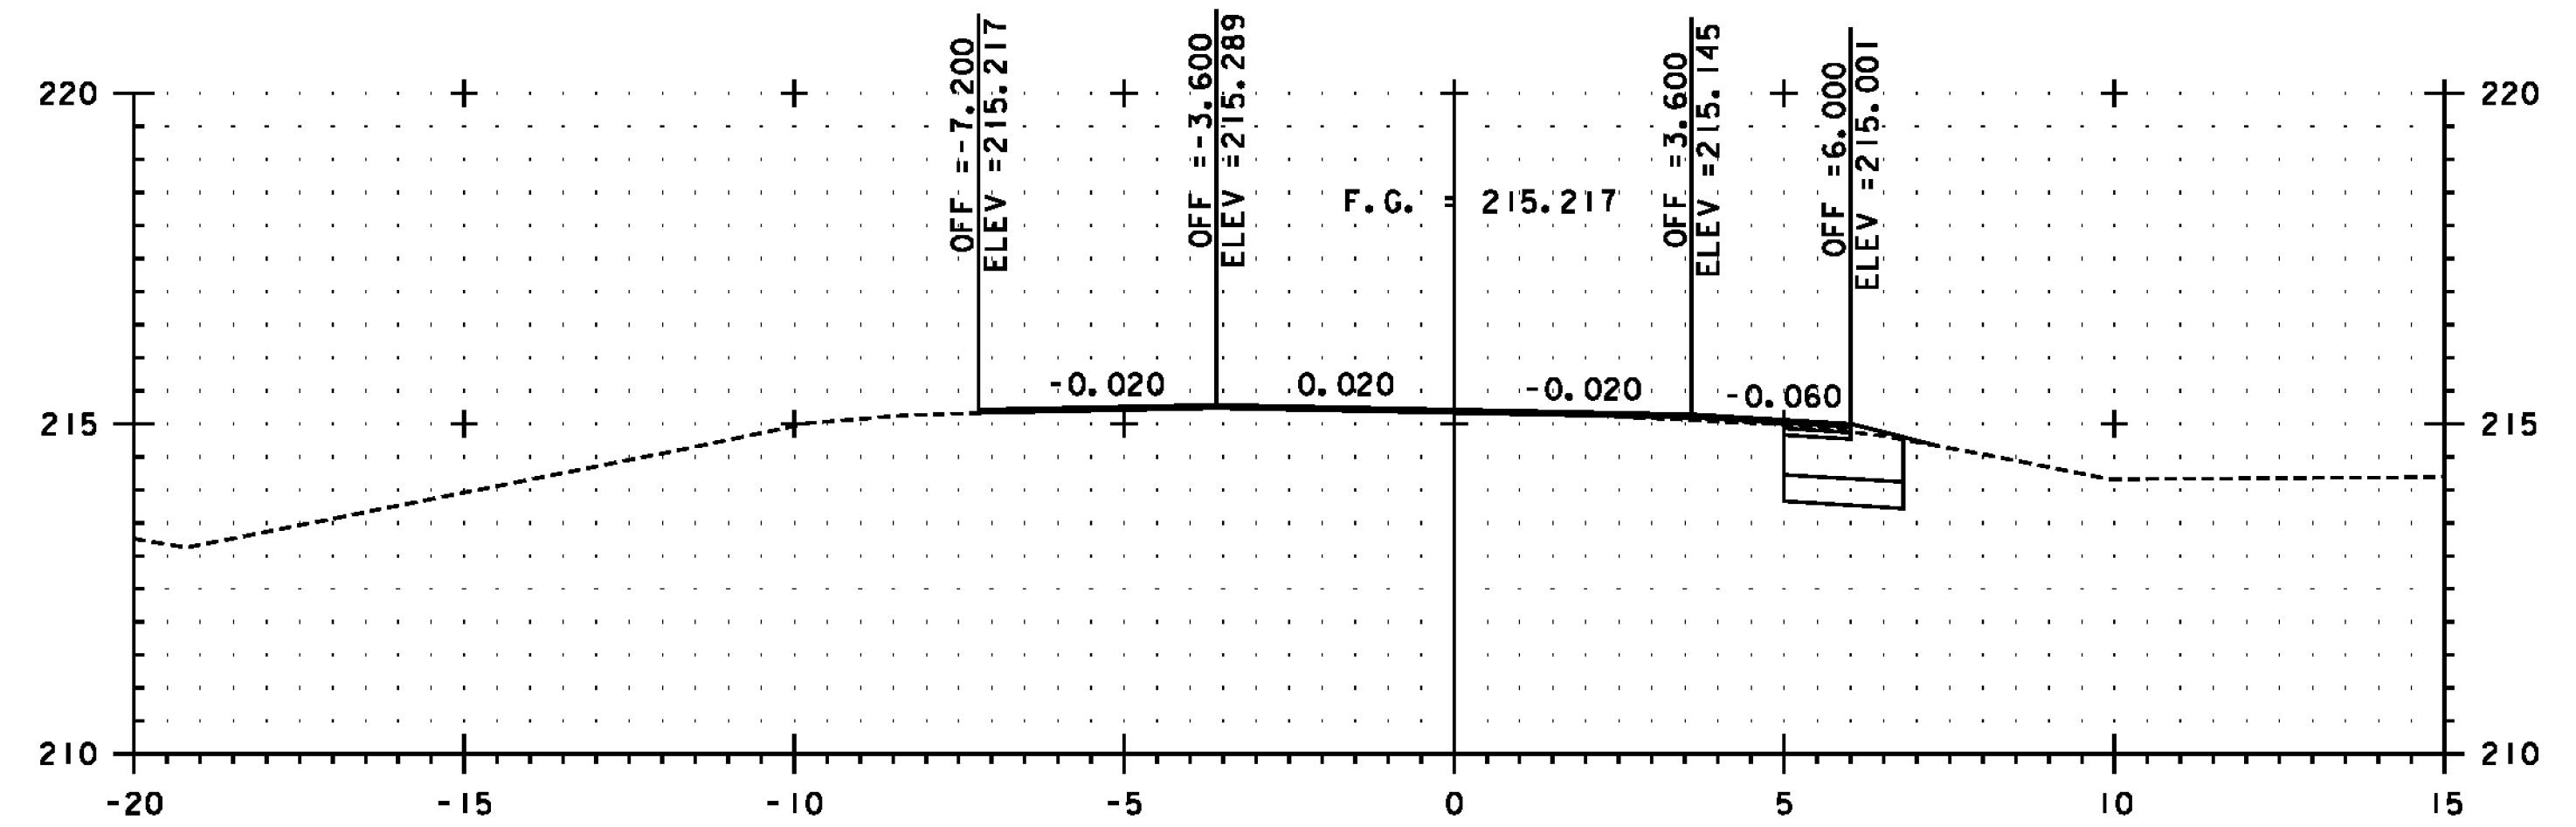


NB 11+060

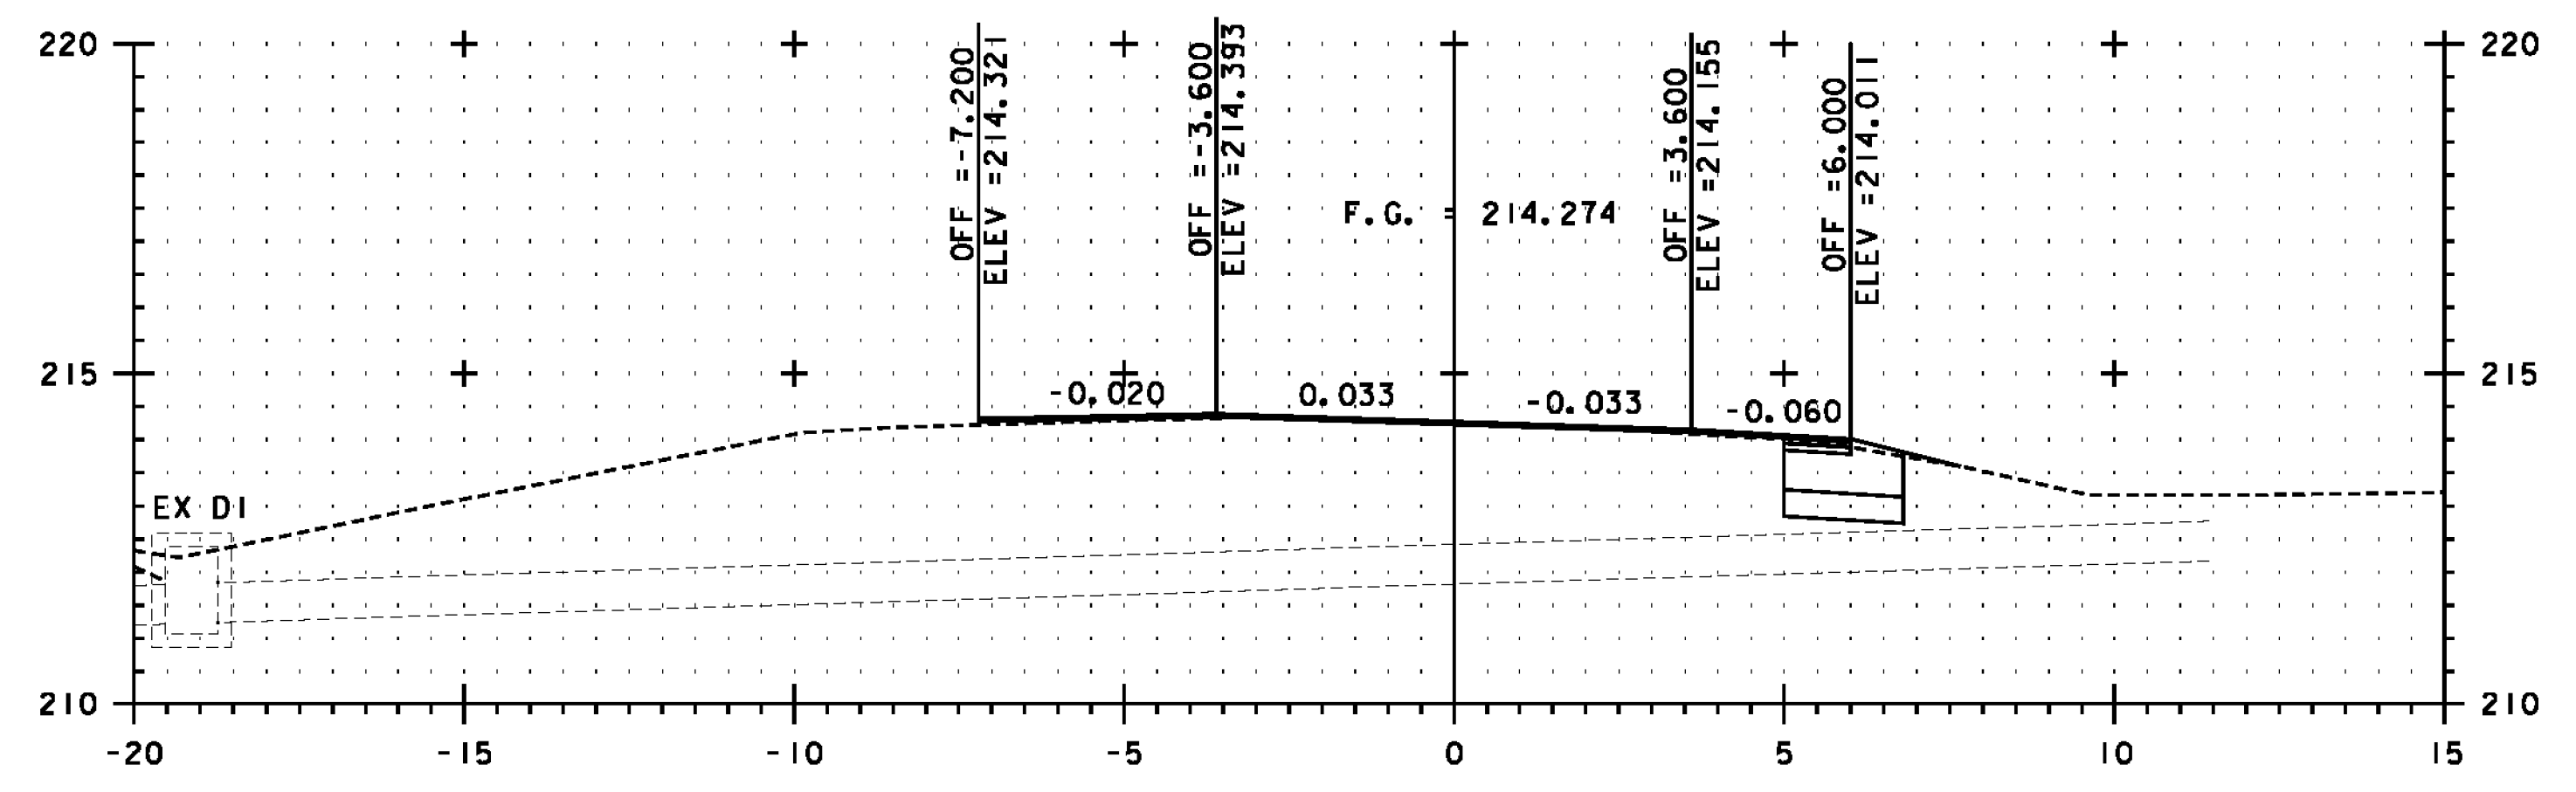

NB 11+040

SEE NOTE ON SHEET 420

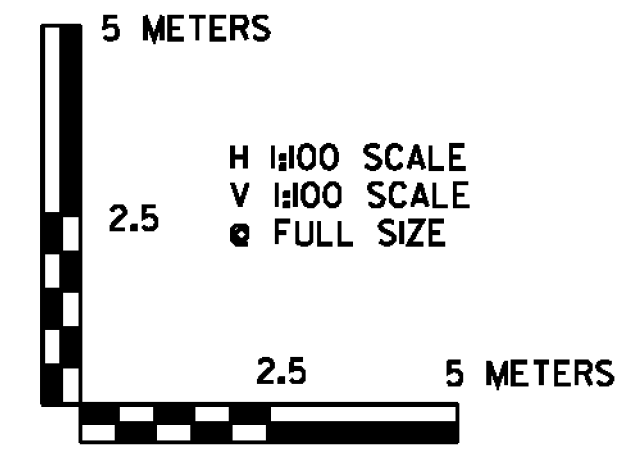

PROJECT NAME:	BENNINGTON	FILE NAME:	...plot_files\zd307c4xs.7nb.ptf	PLOT DATE:	1/26/2010
PROJECT NUMBER:	NH 019-(K54)	DESIGN SUPERVISOR:	GREG EDWARDS	DRAWN BY:	STANTEC
		DESIGNED BY:	MARC FOISY	CHECKED BY:	GARY SANTY
			US 7 NB CROSS SECTION NBX-25		SHEET 444 OF 468

1/26/2010 4:58:37 PM v:\1953\getlive\19530002\tr\anspor\1101\dr\dwg\confr\01\_4\plot\_files\zd307c4xs.7nb.ptf