




NB 11+120

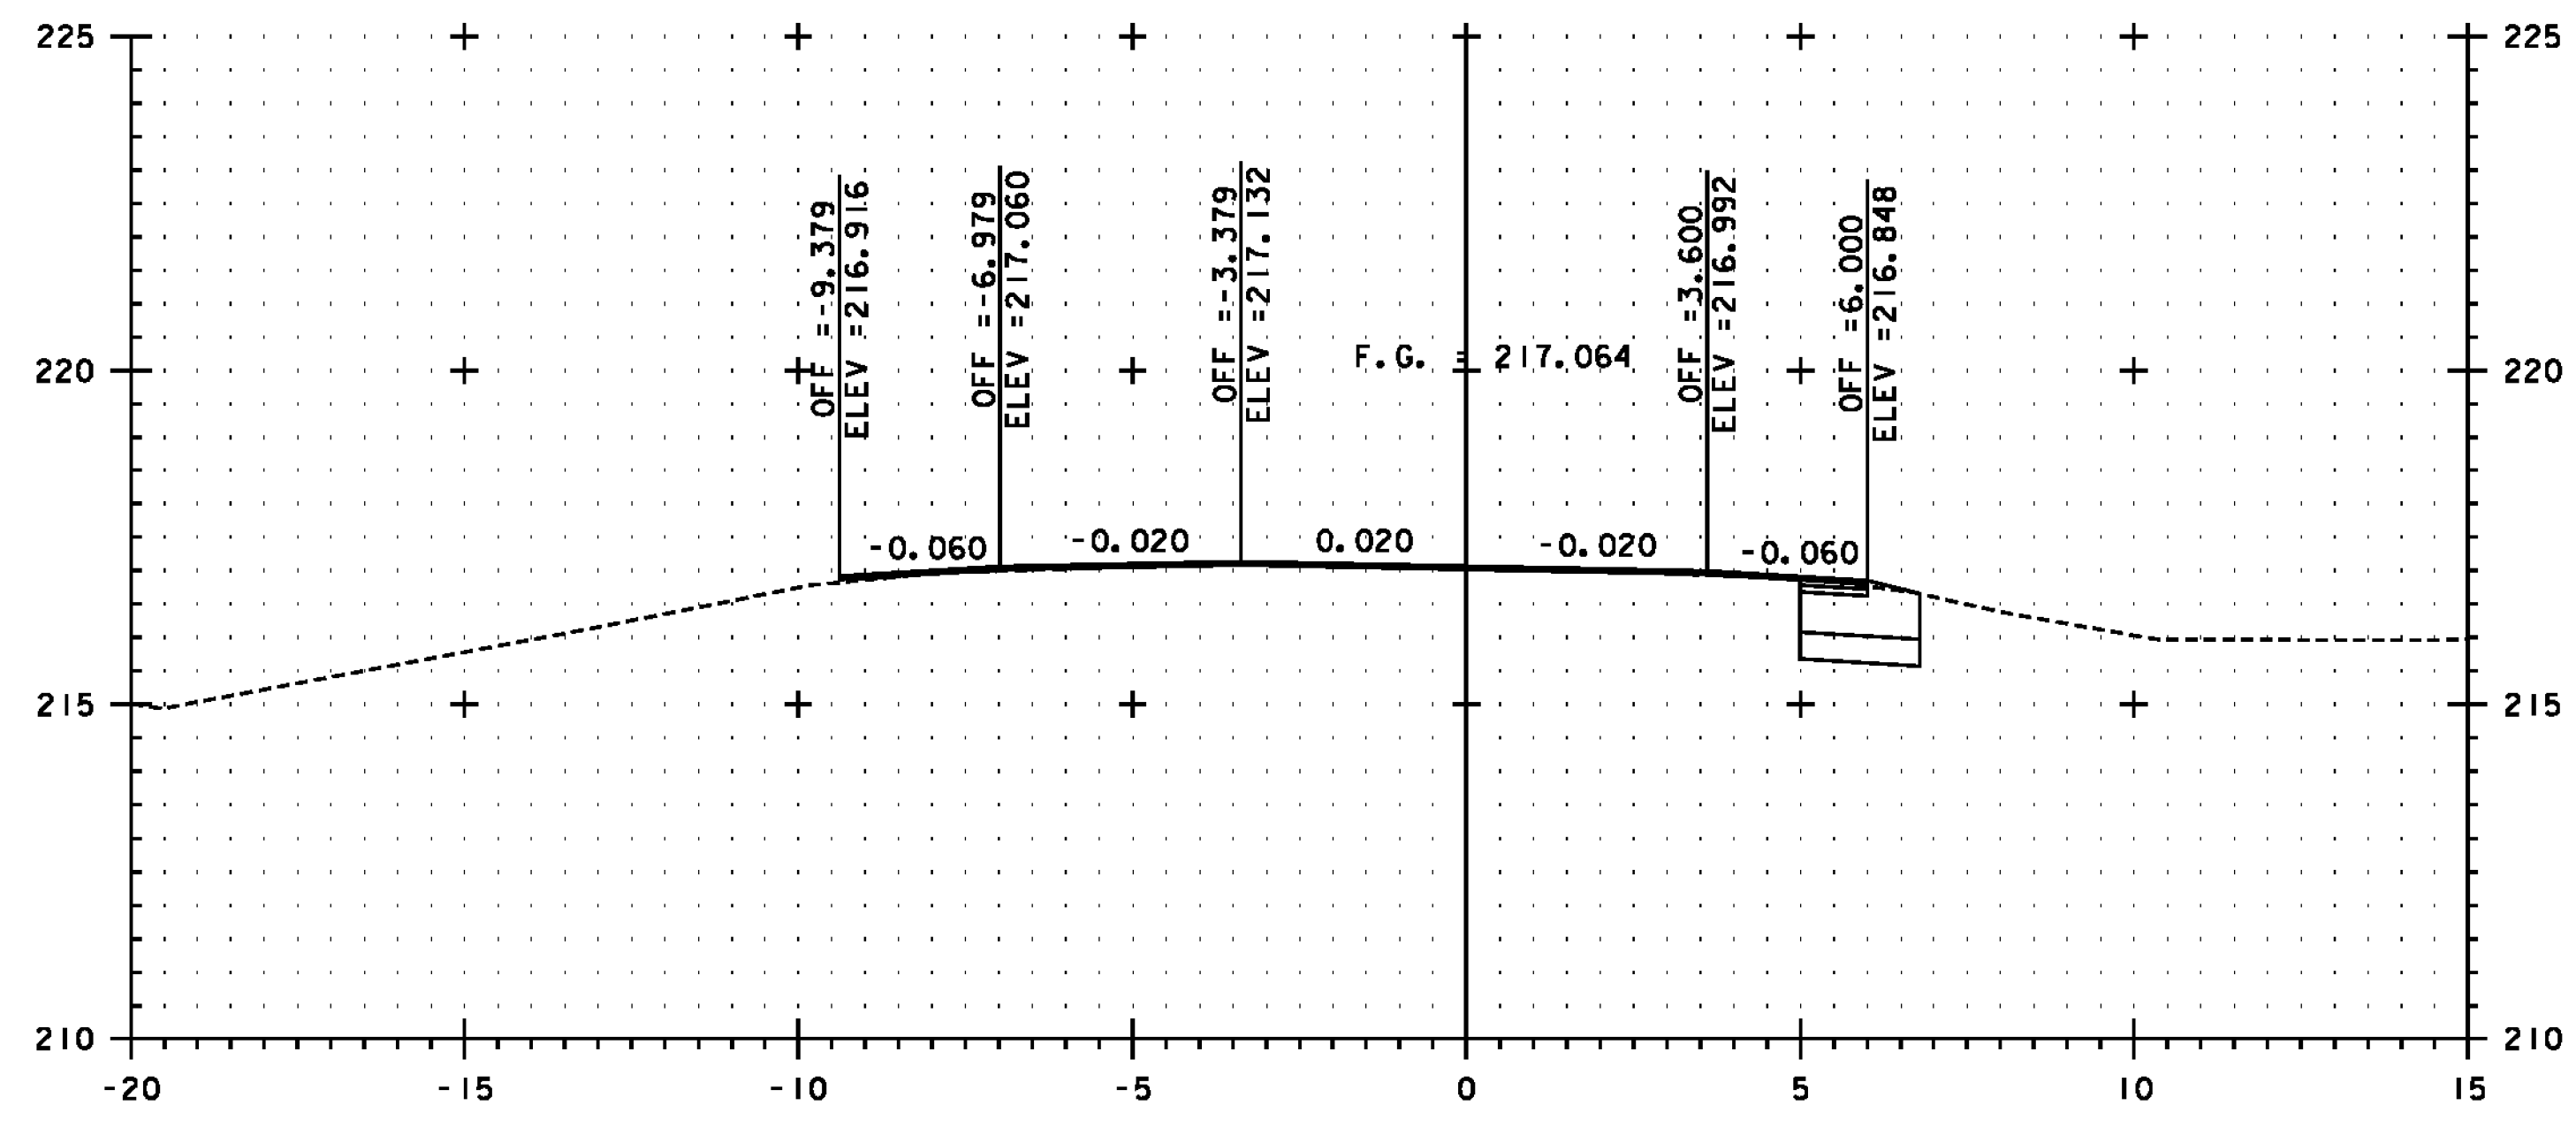


NB 11+100

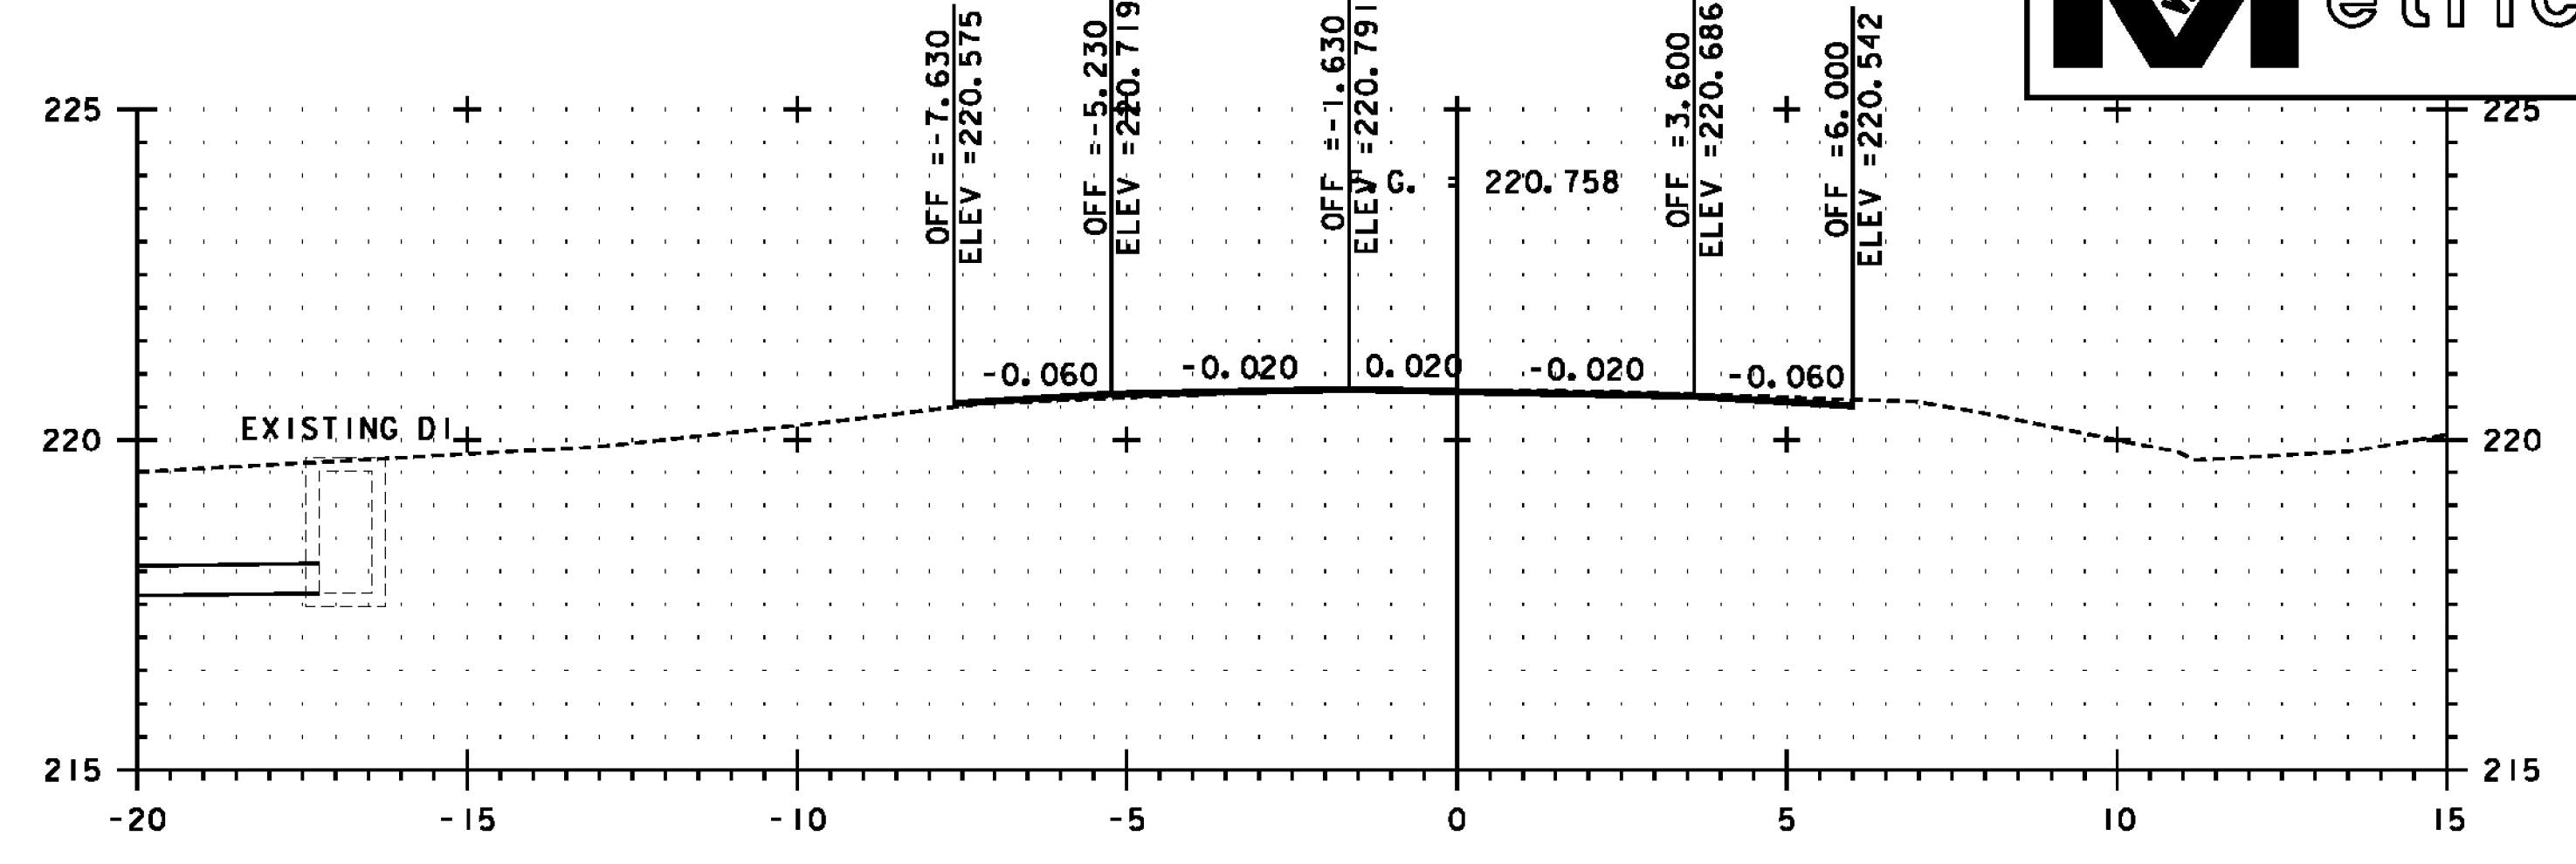

NB 11+180

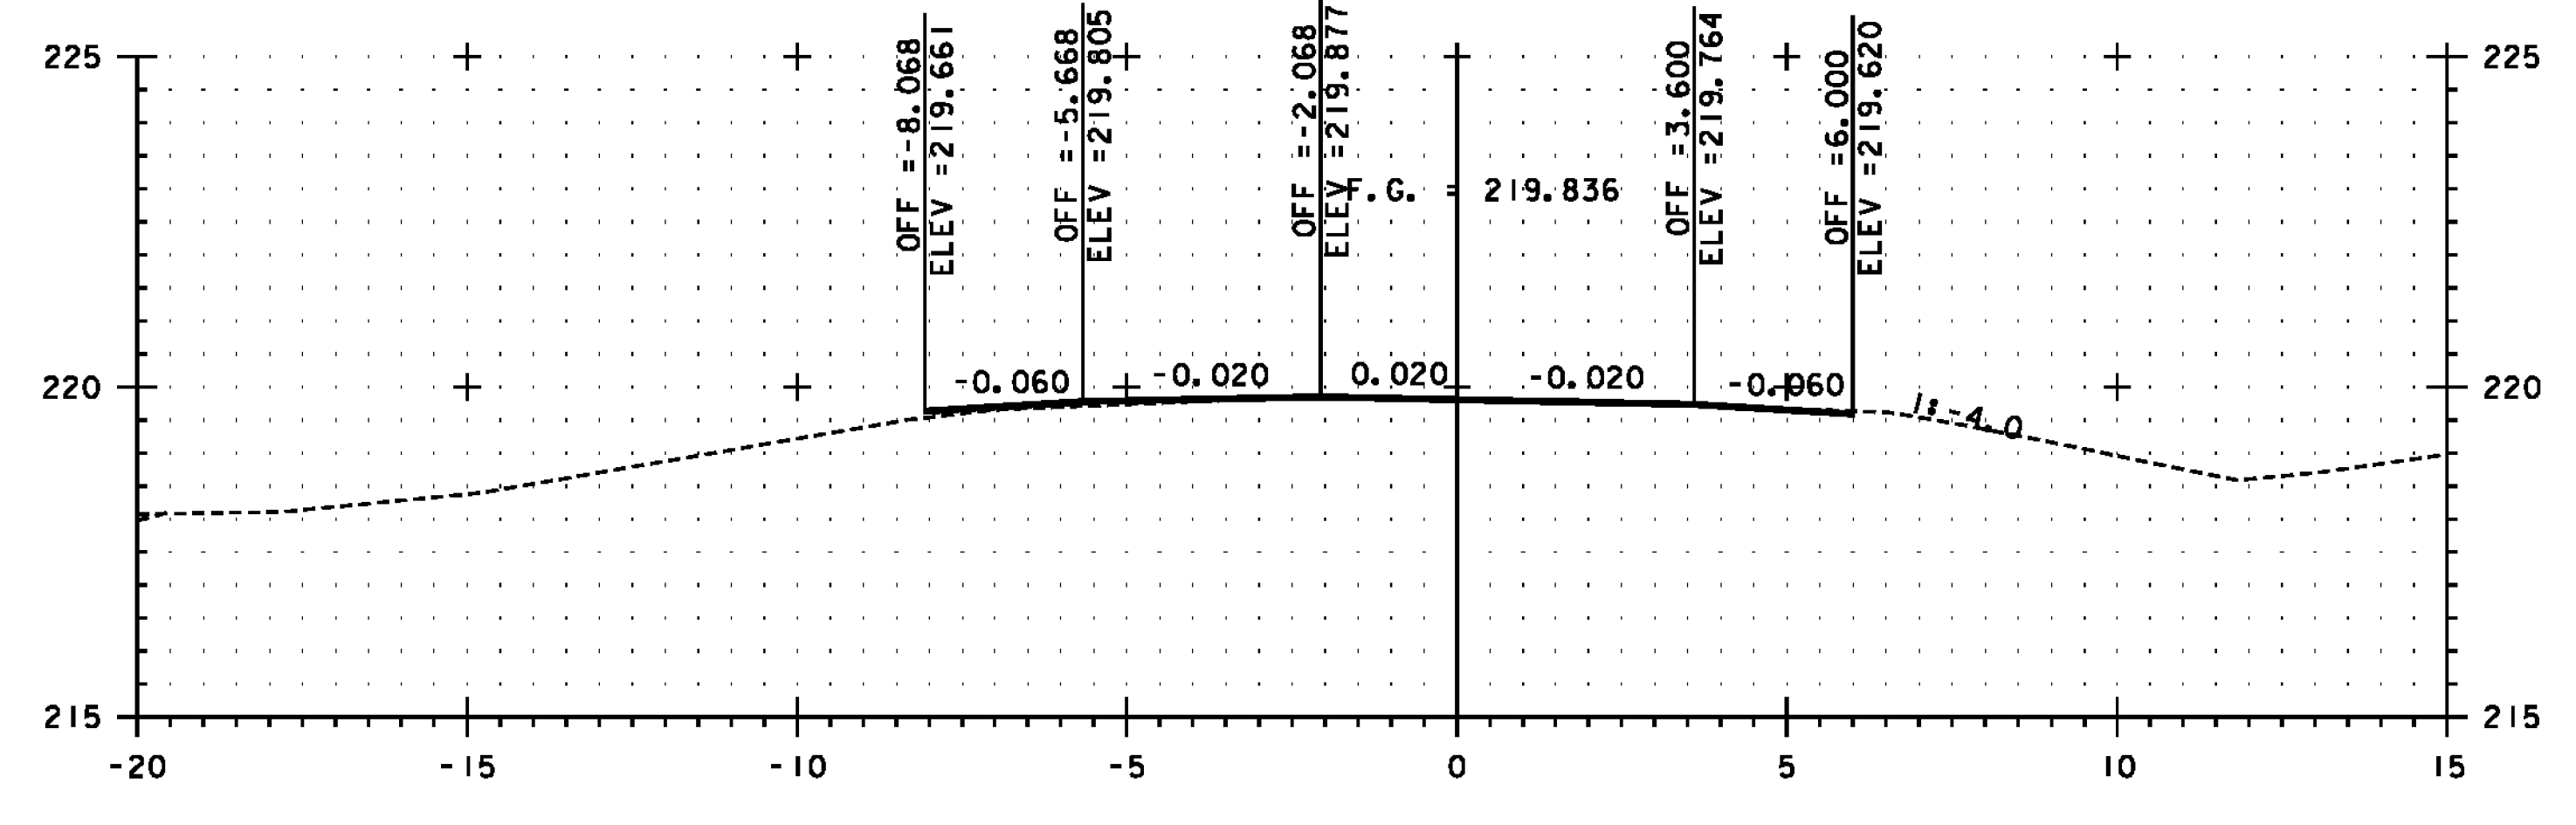


NB 11+160

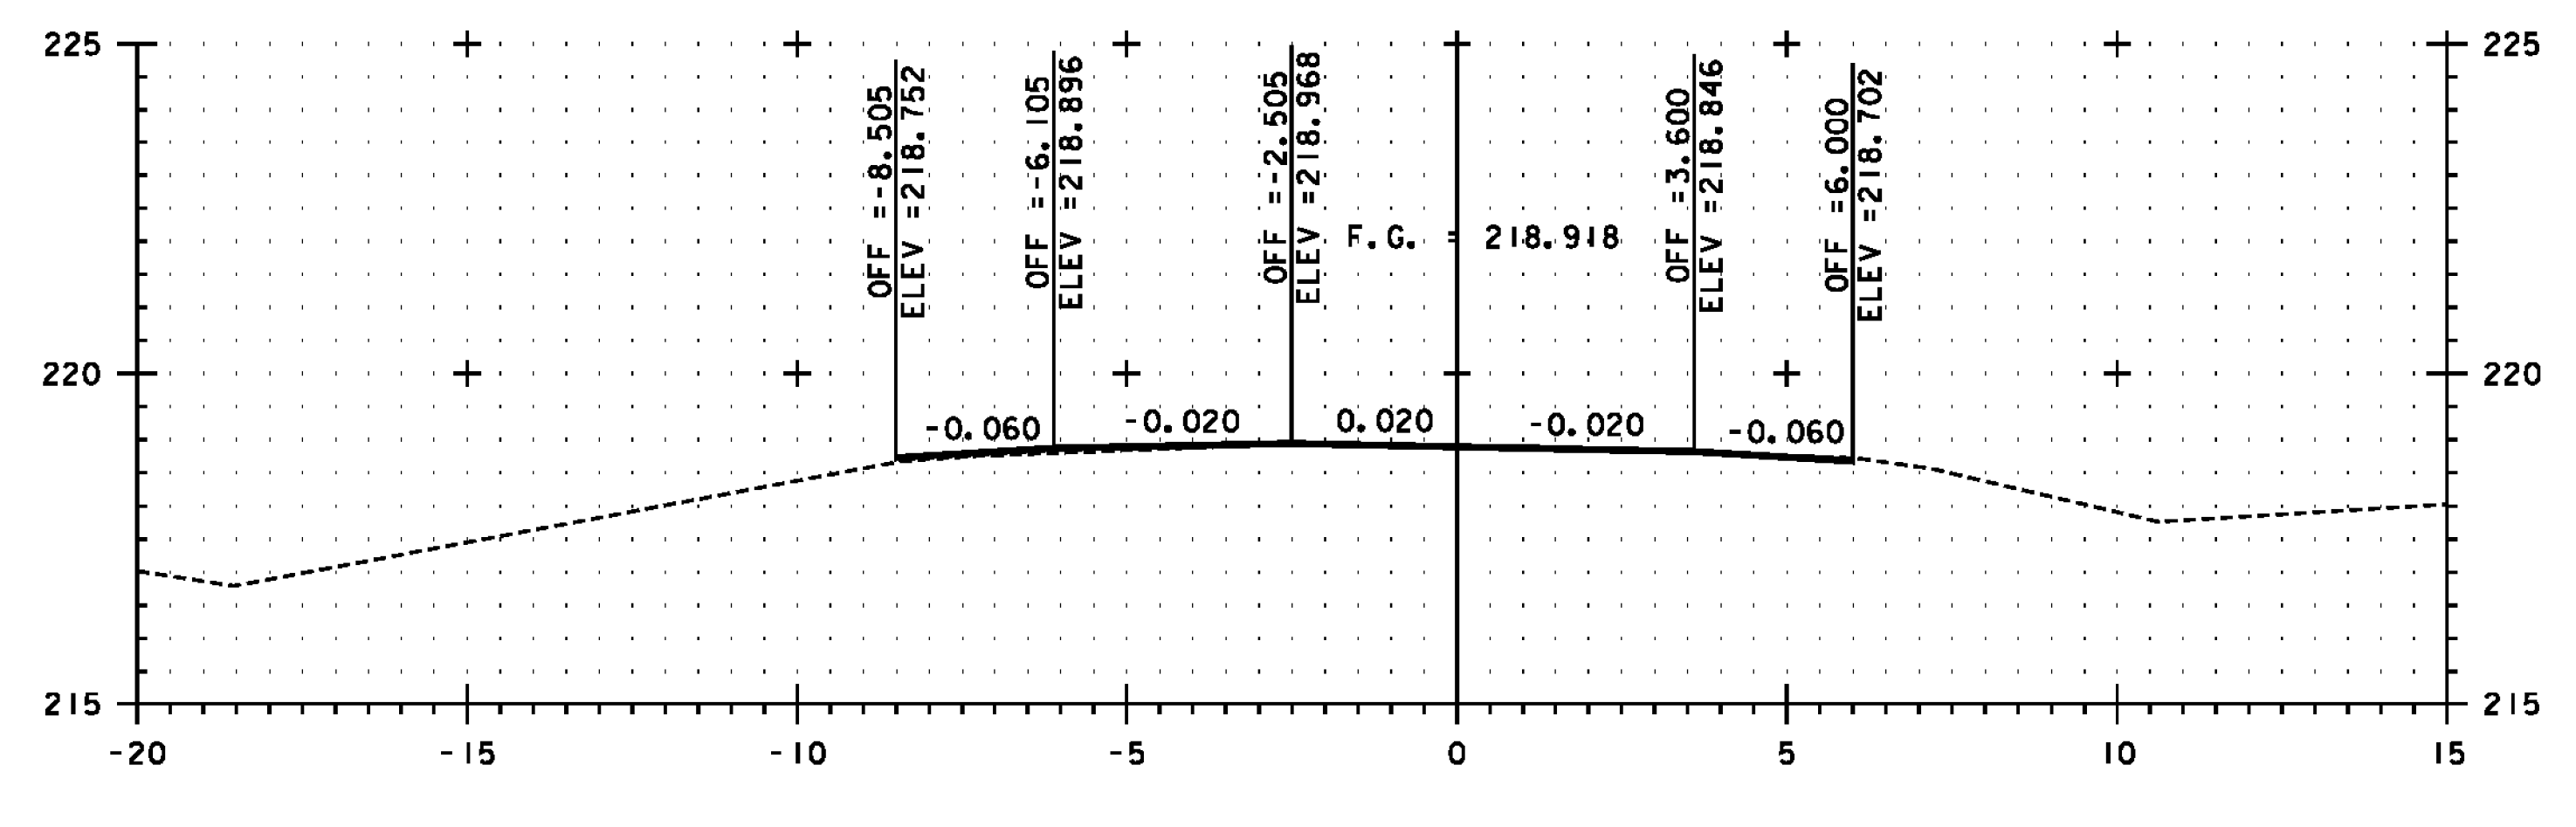

NB 11+140

SEE NOTE ON SHEET 420

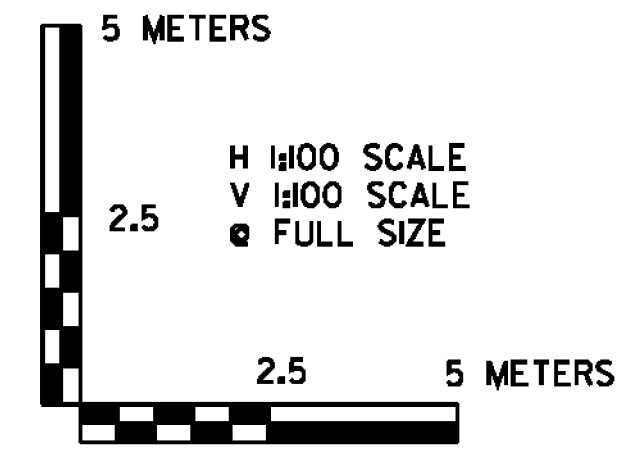

	PROJECT NAME: BENNINGTON
	PROJECT NUMBER: NH 019-(154)
FILE NAME: ...\\plot_files\zd307c4xs.7nb.ptf	PLOT DATE: 1/26/2010
DESIGN SUPERVISOR: GREG EDWARDS	DRAWN BY: STANTEC
DESIGNED BY: MARC FOISY	CHECKED BY: GARY SANTY
US 7 NB CROSS SECTION NBX-26	SHEET 445 OF 468

1/26/2010 4:58:38 PM v:\1953\getlive\19530002\tr\anspor\ref\ion\dr\cwg\ng\com\tr\cst_4\plot_files\zd307c4xs.7nb.ptf