


NOTE: FINAL CROSS SECTIONS FOR SB ARE CONTAINED IN THE FINAL COMP BOOKS FOR ITEM 203.15 - COMMON EXCAVATION

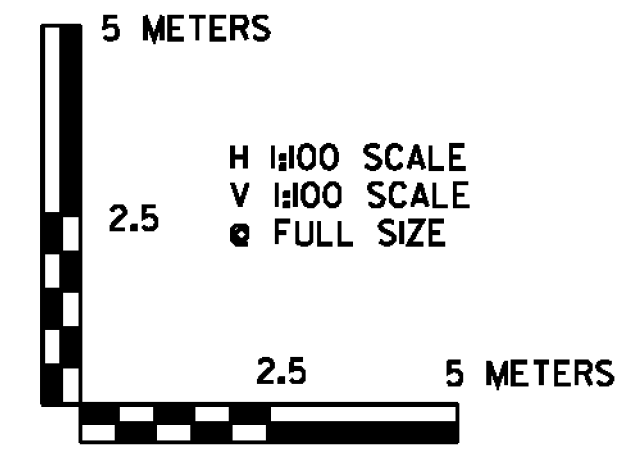

	PROJECT NAME: BENNINGTON	
	PROJECT NUMBER: NH 019-(154)	
FILE NAME: ...\plot_files\zd307c4xs.7SB.ptf	PLOT DATE: 1/26/2010	
DESIGN SUPERVISOR: GREG EDWARDS	DRAWN BY: STANTEC	
DESIGNED BY: MARC FOISY	CHECKED BY: GARY SANTY	
US 7 SB CROSS SECTION SBX-01	SHEET 447 OF 468	

1/26/2010 4:58:43 PM v:\1953\getlive\19530002\tr\anspor\101101\dr\cwg\ng\com\tr\cst\4\plot_files\zd307c4xs.7SB.ptf