



SB 9+880

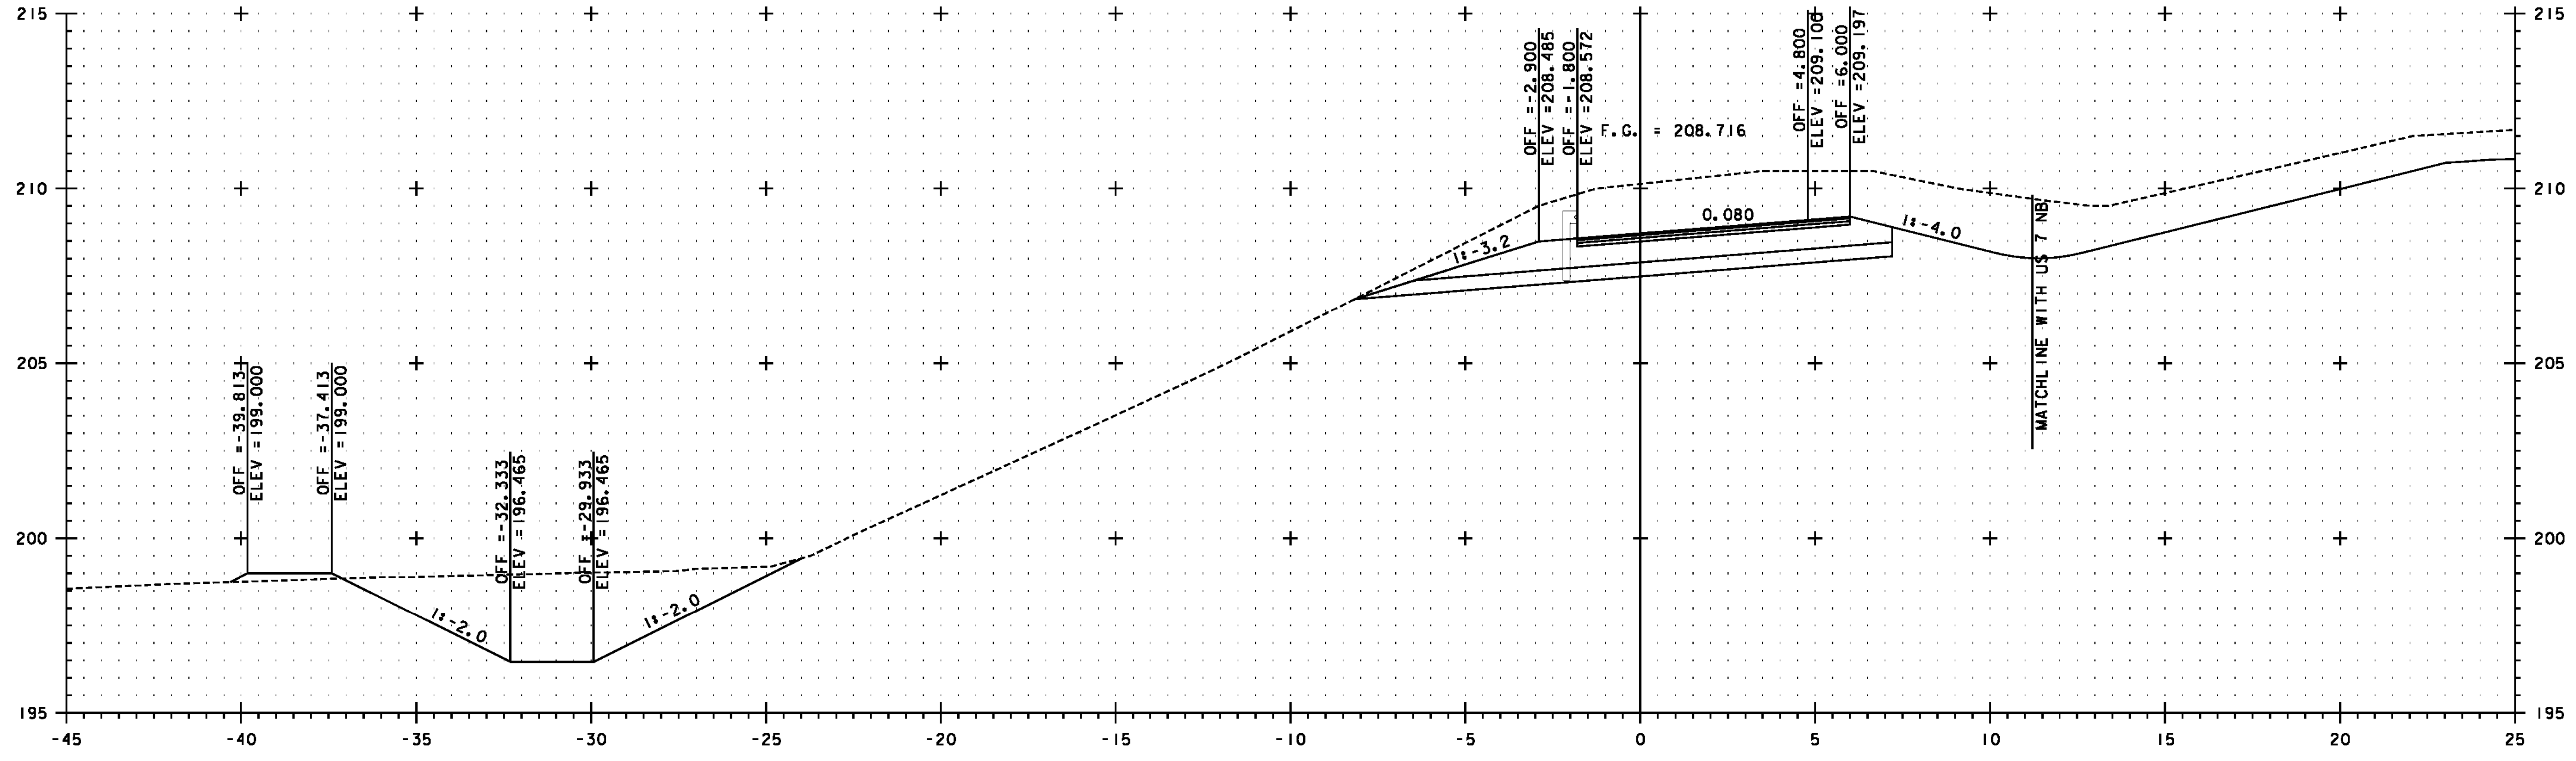

SB 9+860

SEE NOTE ON SHEET 447

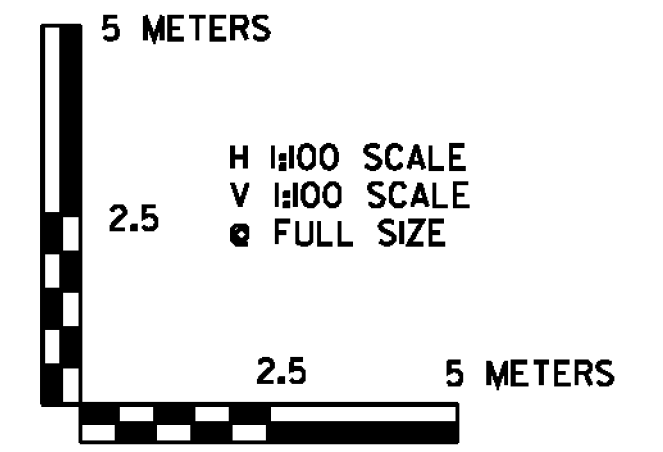

PROJECT NAME: BENNINGTON	
PROJECT NUMBER: NH 019-(154)	
FILE NAME: ...plot_files\zd307c4xs.7SB.ptf	PLOT DATE: 1/26/2010
DESIGN SUPERVISOR: GREG EDWARDS	DRAWN BY: STANTEC
DESIGNED BY: MARC FOISY	CHECKED BY: GARY SANTY
US 7 SB CROSS SECTION SBX-04	
SHEET 450 OF 468	

1/26/2010 4:58:46 PM v:\1953\getlive\19530002A\tr\anspor\station\dr\dwg\con\tr\cst_4\plot_files\zd307c4xs_7SB.ptf