


SEE NOTE ON SHEET 447

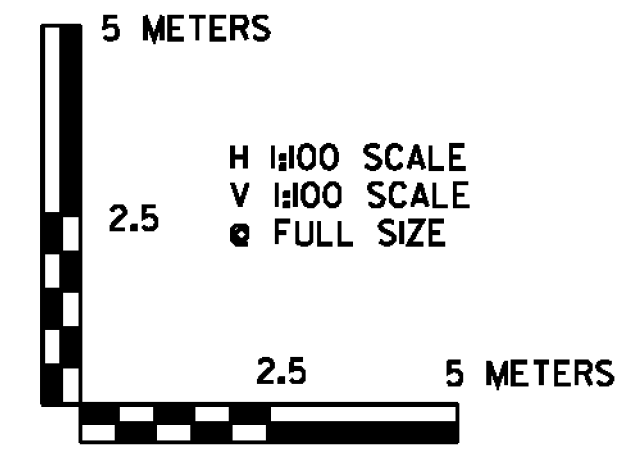

PROJECT NAME:	BENNINGTON	PLOT DATE:	3/16/2010
PROJECT NUMBER:	NH 019-(154)	DRAWN BY:	STANTEC
FILE NAME:	...plot_files\zd307c4xs.7SB.ptf	CHECKED BY:	GARY SANTY
DESIGN SUPERVISOR:	GREG EDWARDS	SHEET	451 OF 468
DESIGNED BY:	MARC FOISY		
US 7 SB CROSS SECTION SBX-05			

3/16/2010 3:46:23 PM v:\1953\getlive\1953\0002\tr\anspor\101\on\dr\cm\ng\com\tr\cst_4\p101_files\z307c4xs_7SB.ptf