



SB 10+000

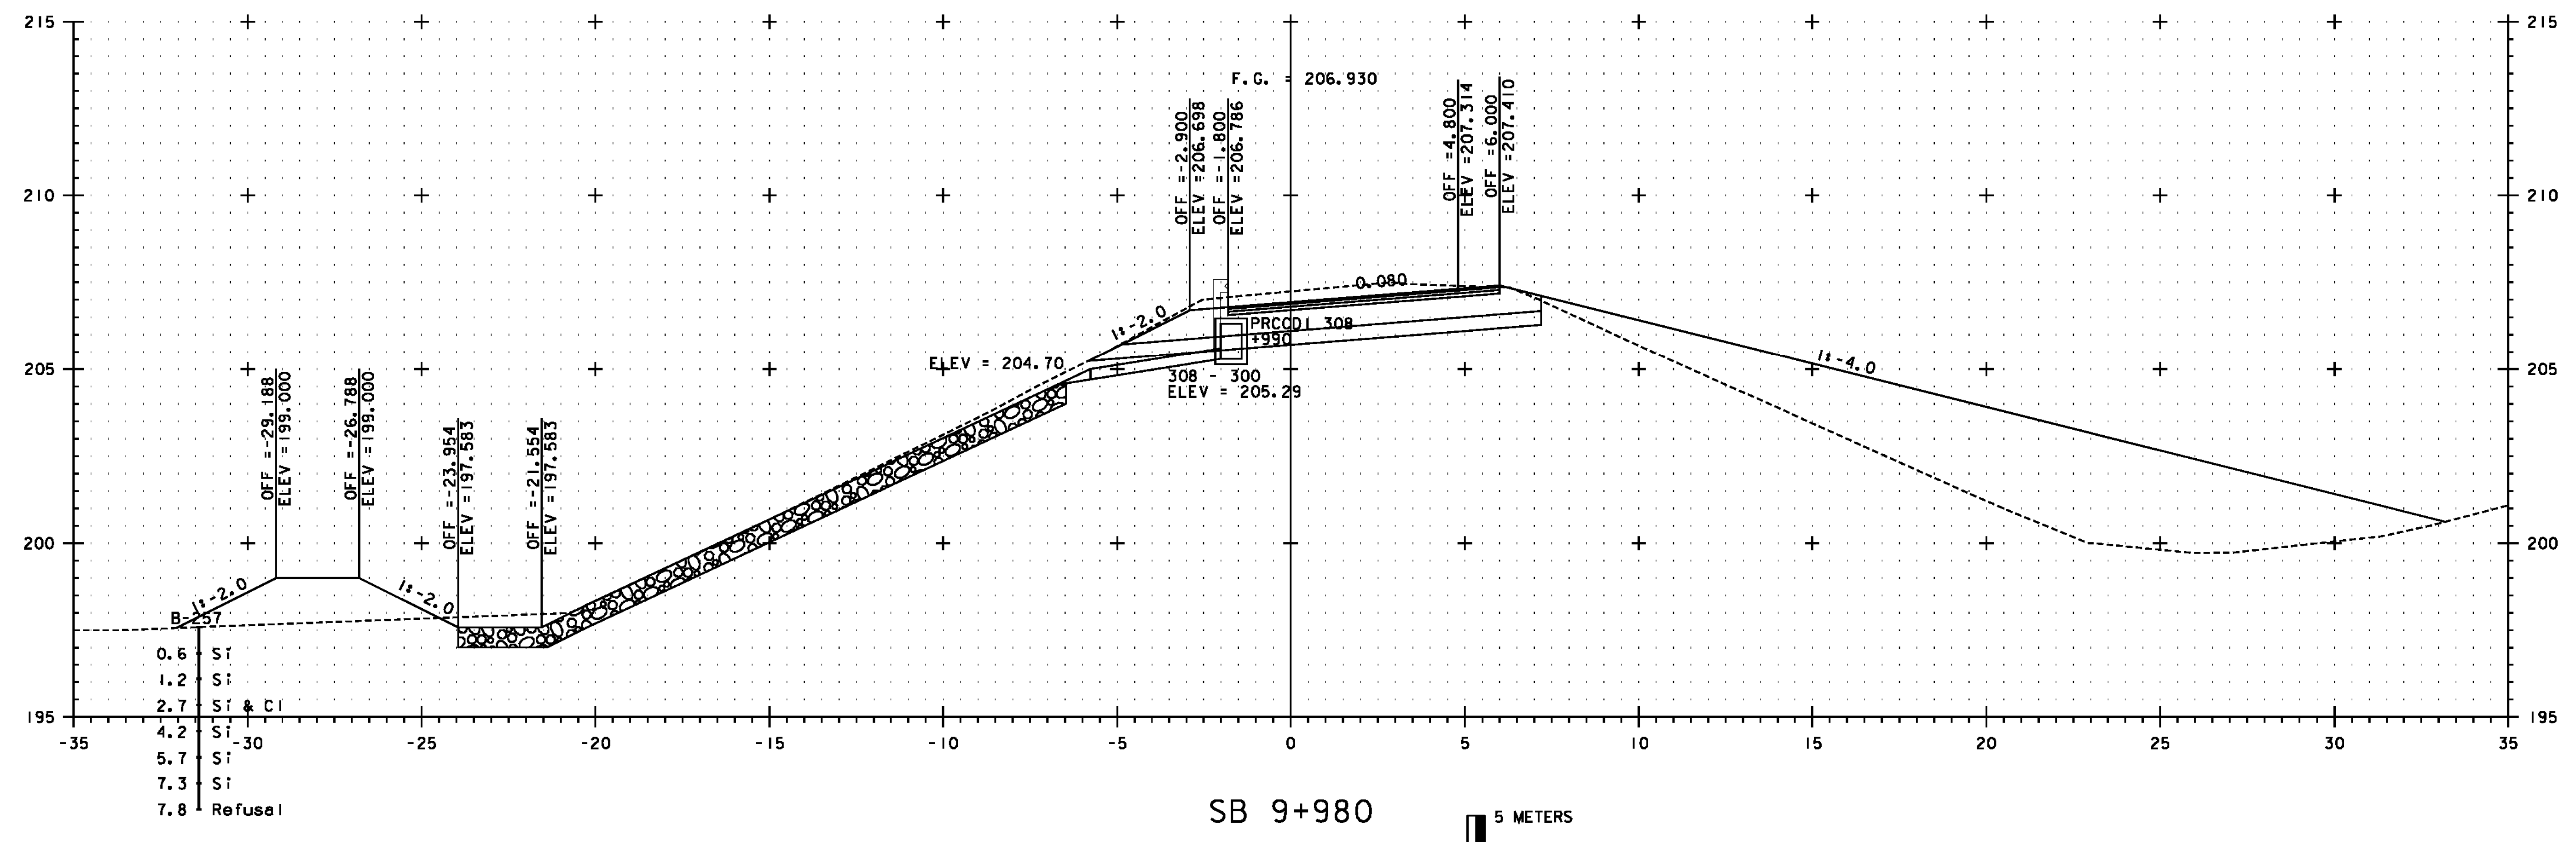

SB 9+980

- 0.6 Si
- 1.2 Si
- 2.7 Si & CI
- 4.2 Si
- 5.7 Si
- 7.3 Si
- 7.8 Refusal

SEE NOTE ON SHEET 447

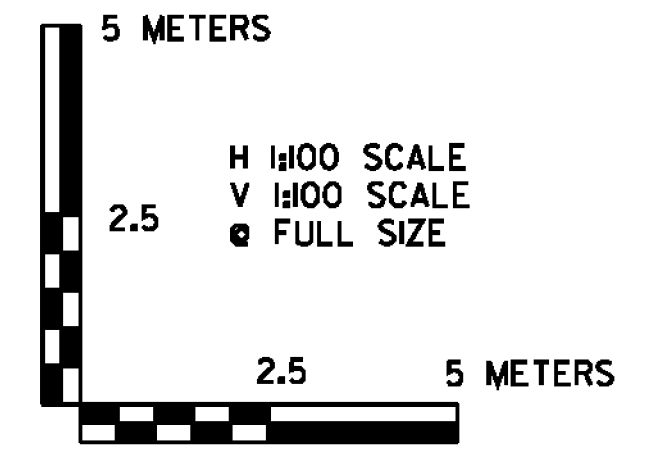

	PROJECT NAME: BENNINGTON	PLOT DATE: 1/26/2010
	PROJECT NUMBER: NH 019-(154)	DRAWN BY: STANTEC
FILE NAME: ...\plot_files\zd307c4xs.7SB.ptf	DESIGNED BY: MARC FOISY	CHECKED BY: GARY SANTY
	DESIGN SUPERVISOR: GREG EDWARDS	SHEET 453 OF 468
	US 7 SB CROSS SECTION SBX-07	