


SB 10+040



SB 10+020

SEE NOTE ON SHEET 447

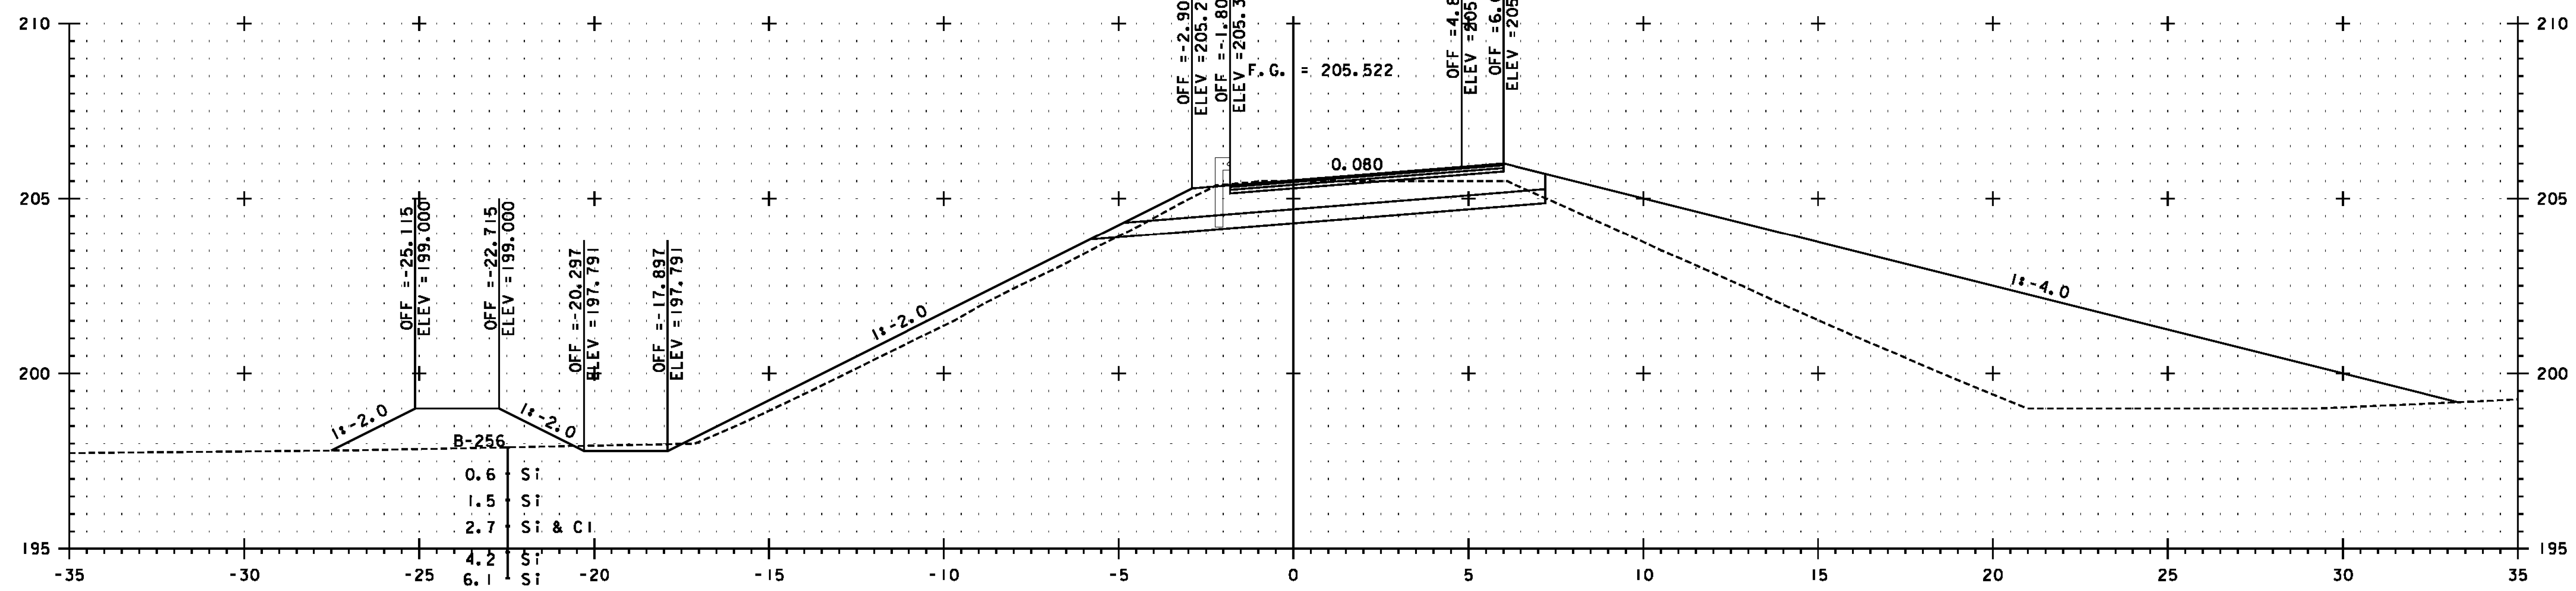

PROJECT NAME:	BENNINGTON	PLOT DATE:	1/26/2010
PROJECT NUMBER:	NH 019-(154)	DRAWN BY:	STANTEC
FILE NAME:	...plot_files\zd307c4xs.7SB.ptf	DESIGNED BY:	MARC FOISY
DESIGN SUPERVISOR:	GREG EDWARDS	CHECKED BY:	GARY SANTY
US 7 SB CROSS SECTION SBX-08		SHEET 454 OF 468	